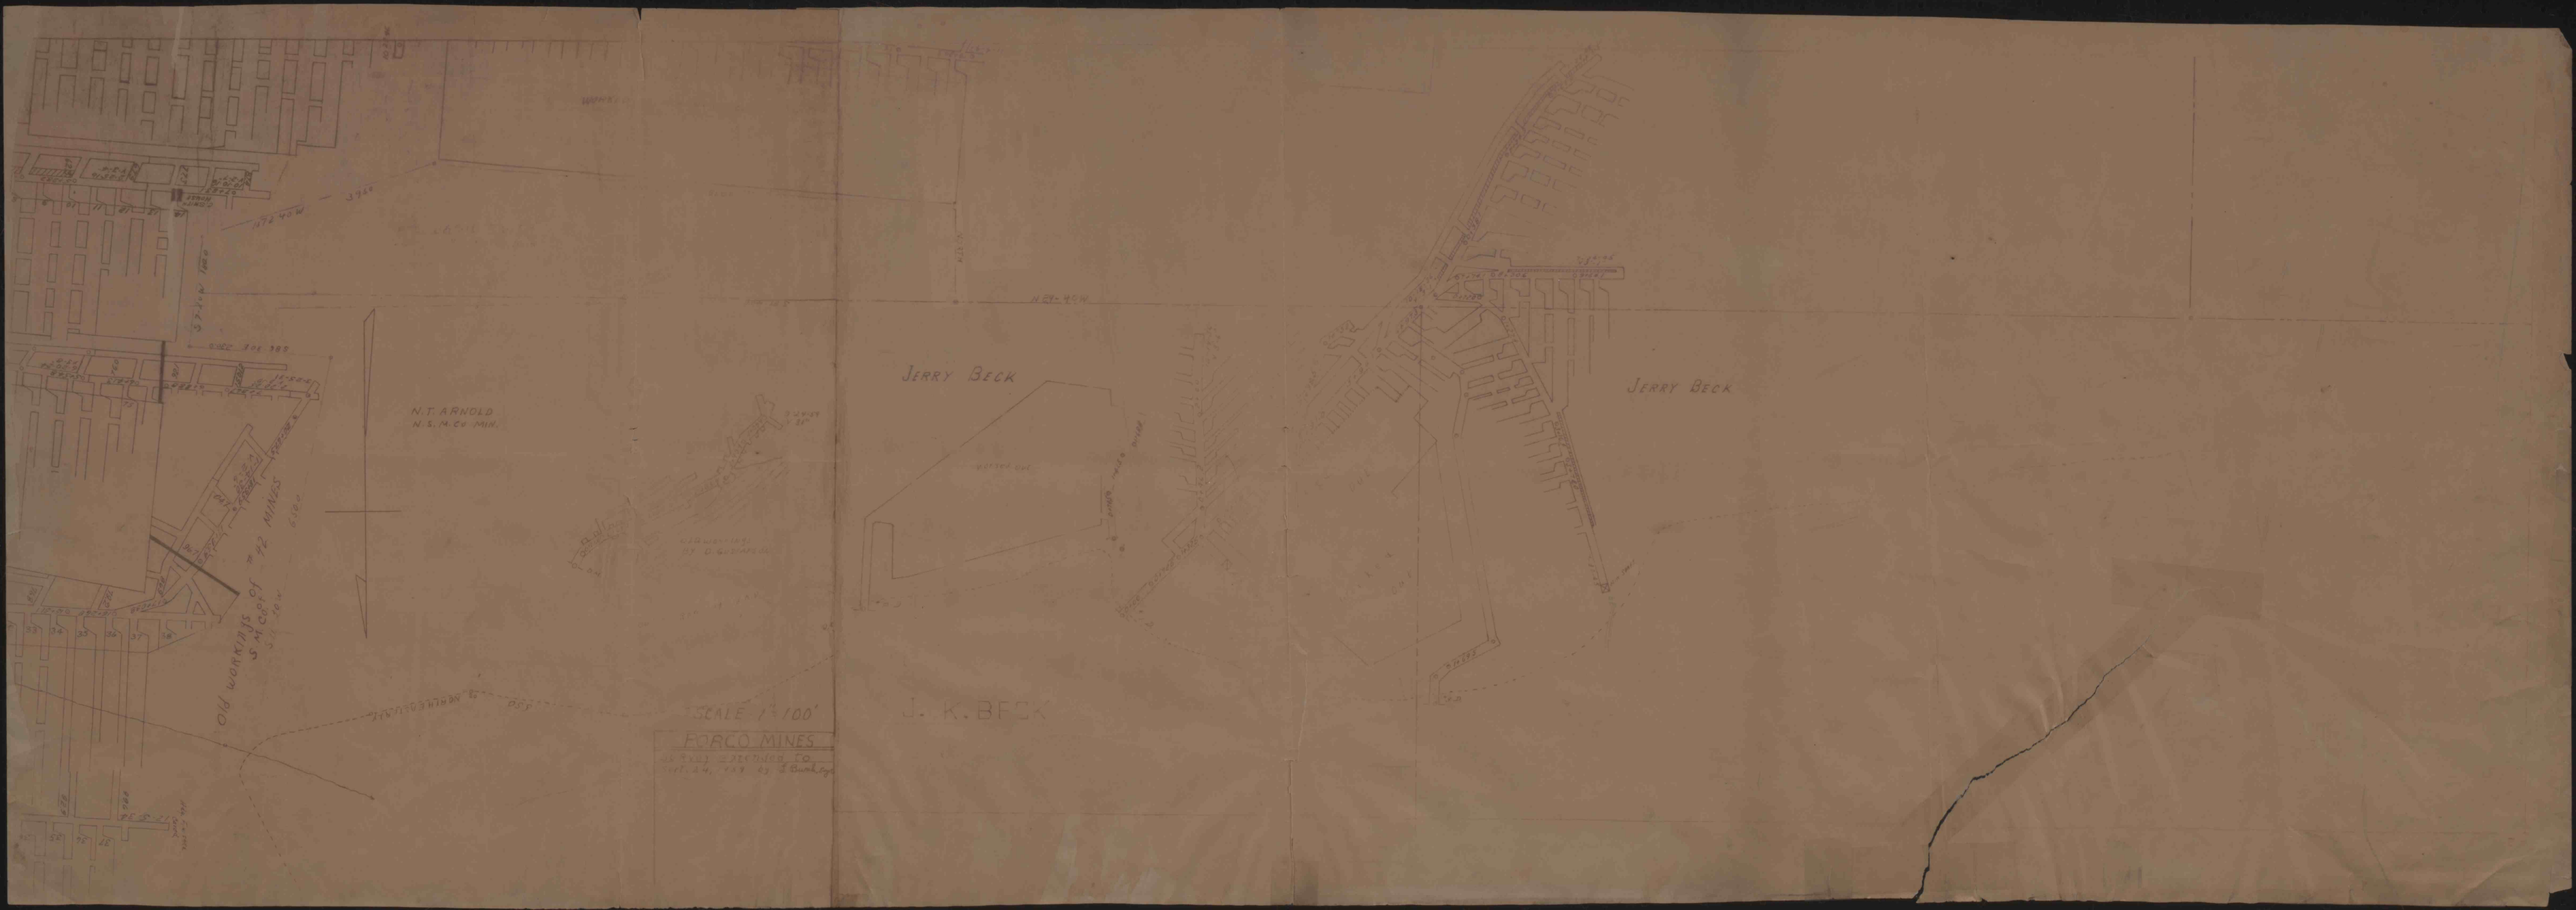
N.T. ARNOLD
N.S.M.CO MIN.
OLD WORKINGS OF THE MINES
S.M.CO.
JERRY BECK
JERRY BECK
SCALE 1"=100'
J. K. BECK
