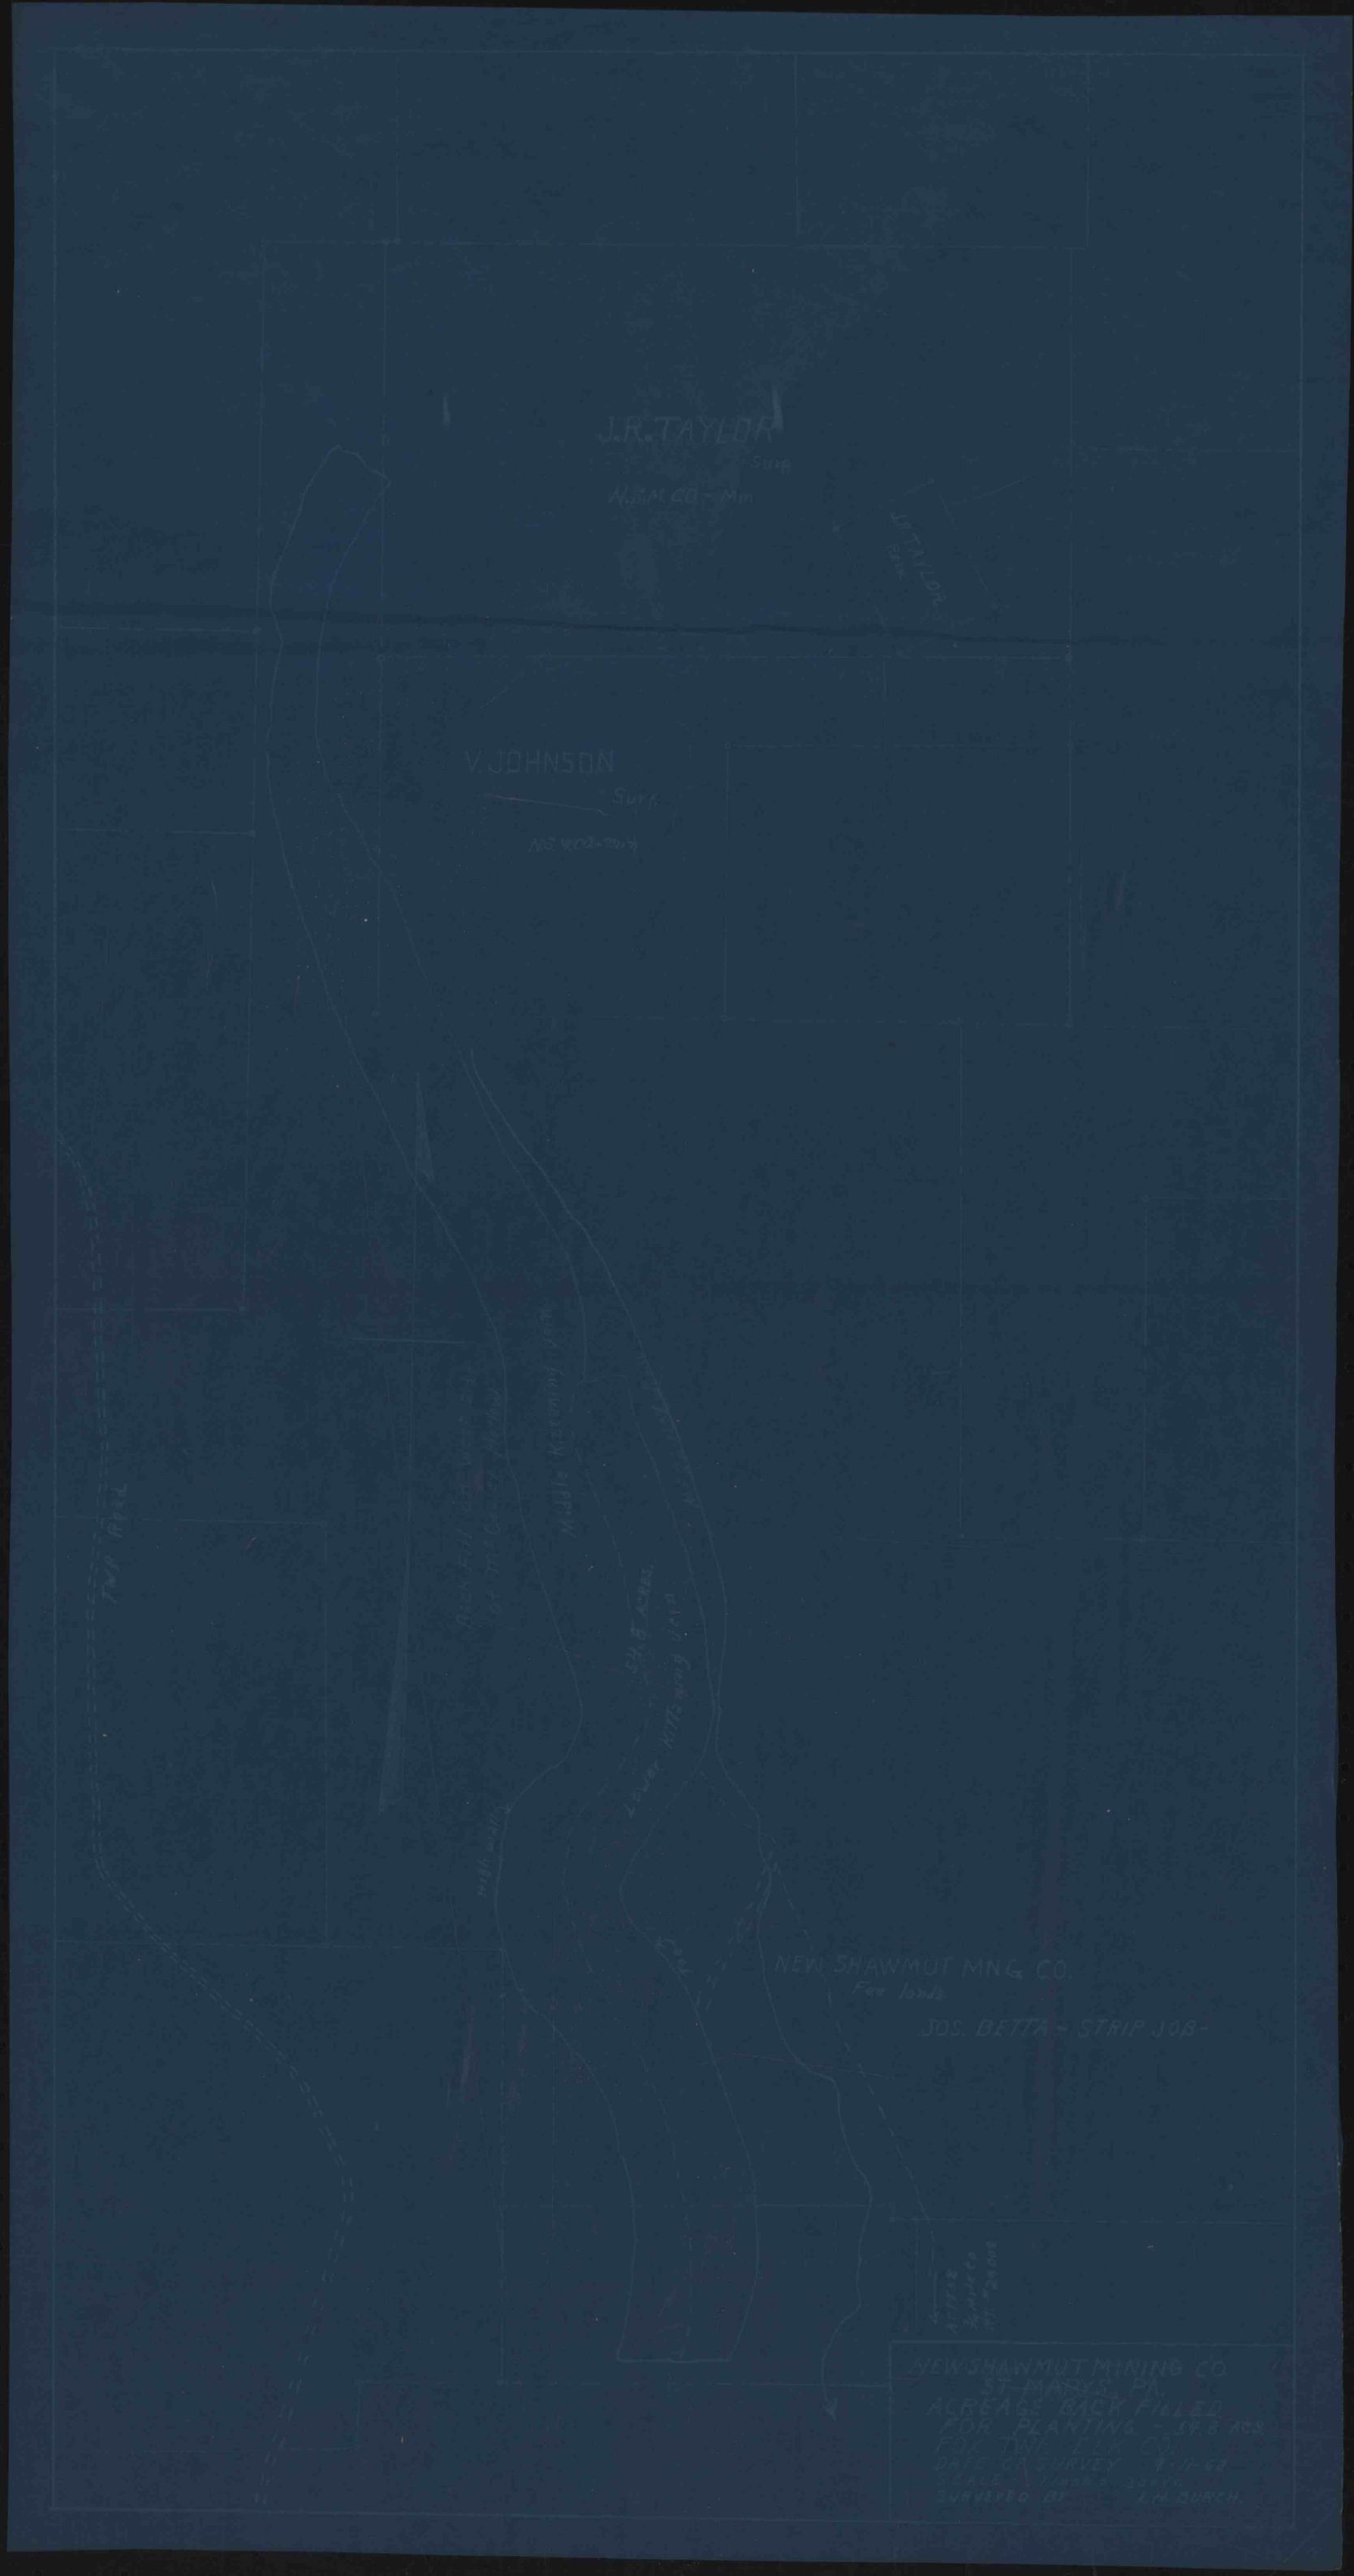
J.R. TAYLOR
Surp
N.S.M. CO - Min
J.R. TAYLOR
Surp
V. JOHNSON
Surp
N.S. WOOD-Min
TWP ROAD
Middle Kittanning Coal
Lower Kittanning Coal
NEW SHAWMUT MN.G. CO.
Fee lands
JOS. BETTA - STRIP JOB -
NEW SHAWMUT MINING CO
ST. MARYS PA.
ACREAGE BACK FILLED
FOR PLANTING - 39.8 ACS
FOR TWP. ELK CO.
DATE OF SURVEY
SCALE
SURVEYED BY
J.M. BURCH.