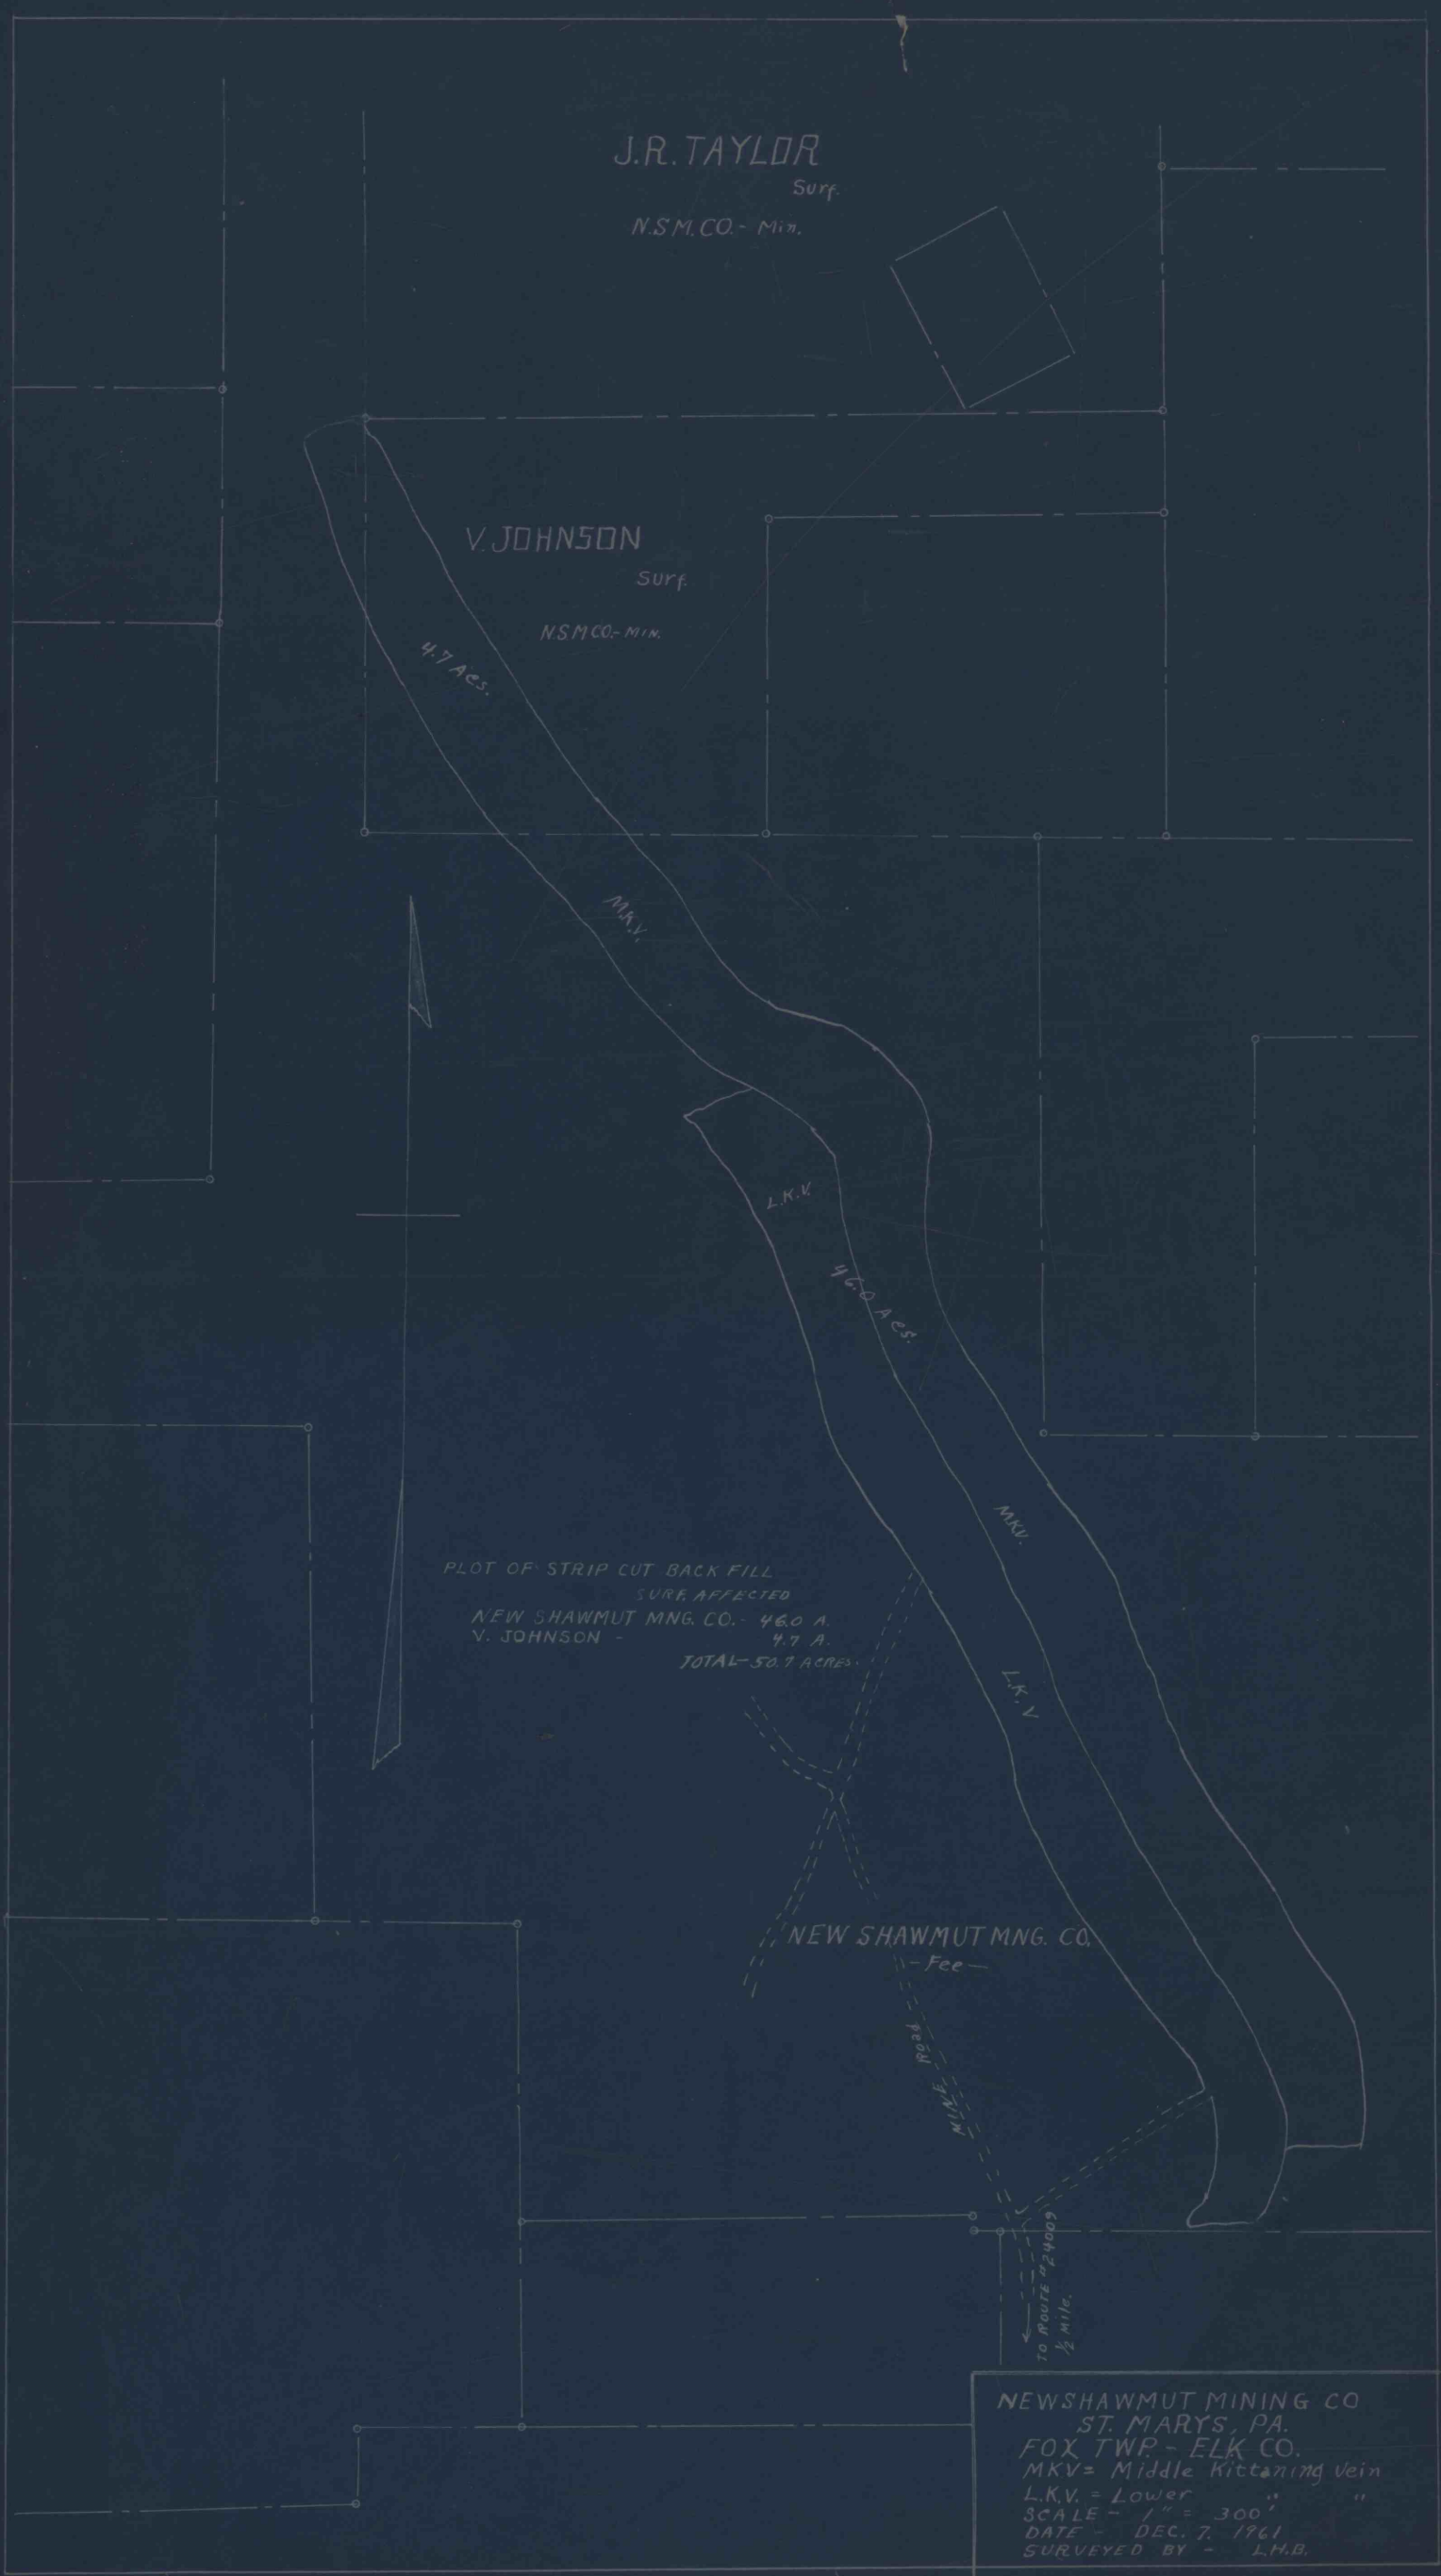
J.R. TAYLOR
Surf.
N.S.M.CO.- Min.
V. JOHNSON
Surf.
N.S.M.CO.- MIN.
4.7 Acs.
M.K.V.
L.K.V.
M.K.V.
L.K.V.
PLOT OF STRIP CUT BACK FILL
SURF. AFFECTED
NEW SHAWMUT MNG. CO. - 46.0 A.
V. JOHNSON - 4.7 A.
TOTAL - 50.7 ACRES.
NEW SHAWMUT MNG. CO.
- Fee -
MINE Road
TO ROUTE #24009
½ MILE.
NEWSHAWMUT MINING CO
ST. MARYS, PA.
FOX TWP - ELK CO.
MKV = Middle Kittanning Vein
L.K.V. = Lower " "
SCALE - 1" = 300'
DATE - DEC. 7. 1961
SURVEYED BY - L.H.B.