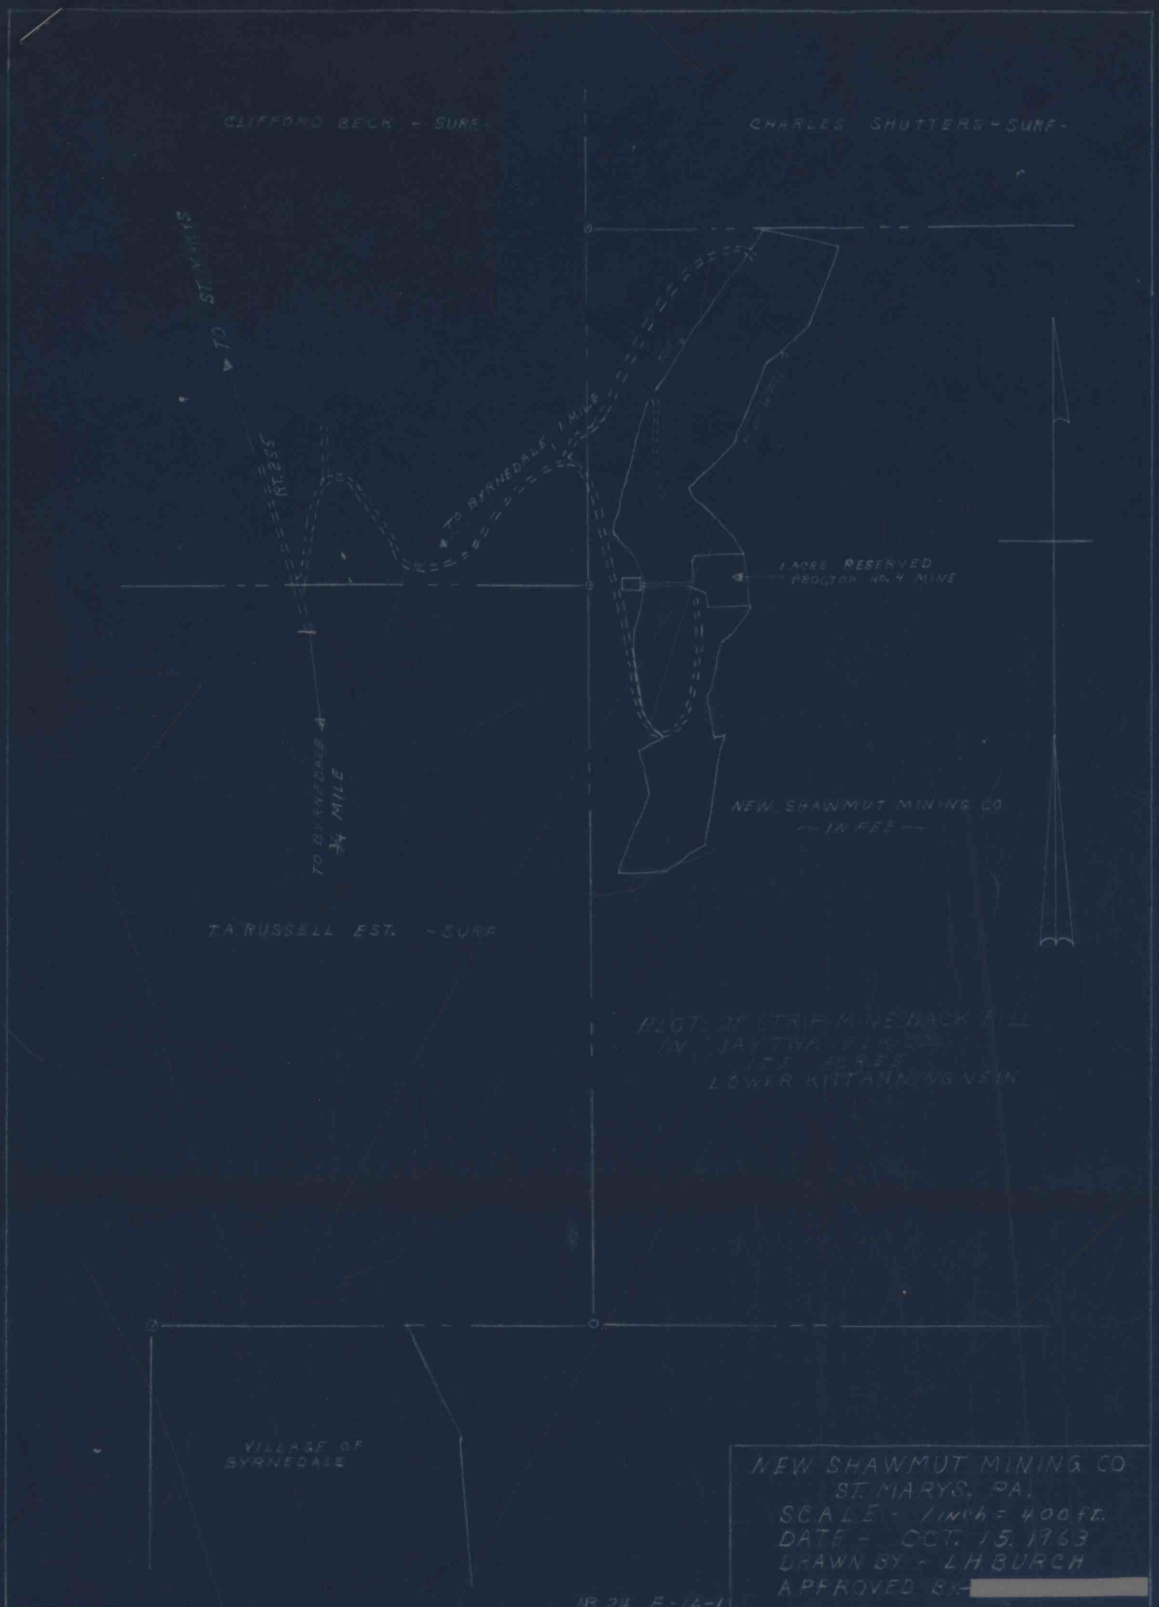
CLIFFORD BECK - SURF.
CHARLES SHUTTERS - SURF.
TO ST. MARYS
RT. 255
TO BYRNEDALE 1 MILE
1 ACRE RESERVED
PROCTOR NO. 4 MINE
NEW SHAWMUT MINING CO
— IN FEE —
TO BYRNEDALE
3/4 MILE
T.A. RUSSELL EST. - SURF.
PLOT OF STRIP-MINE BACK FILL
ON JAY TINA FLATS
IN FEE
LOWER KITTANNING VEIN
VILLAGE OF
BYRNEDALE
NEW SHAWMUT MINING CO
ST. MARYS, PA.
SCALE - 1 INCH = 400 FT.
DATE - OCT. 15. 1963
DRAWN BY - L.H. BURCH
APPROVED BY -
NB 24 E-16-1