


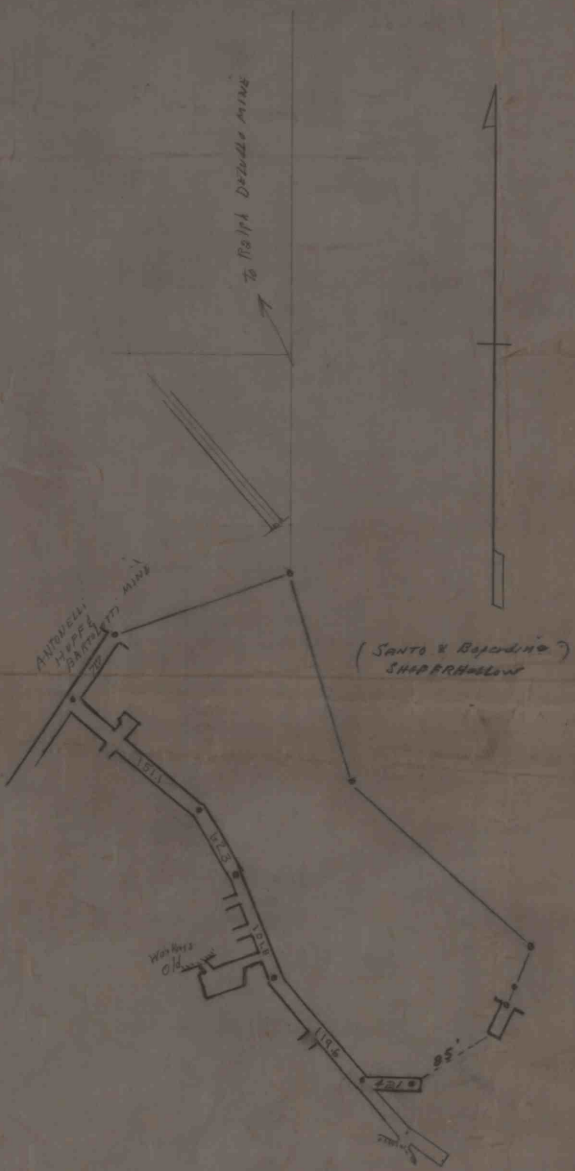

ANTHONY HOFF & BARTLETT MINE

Washers Old