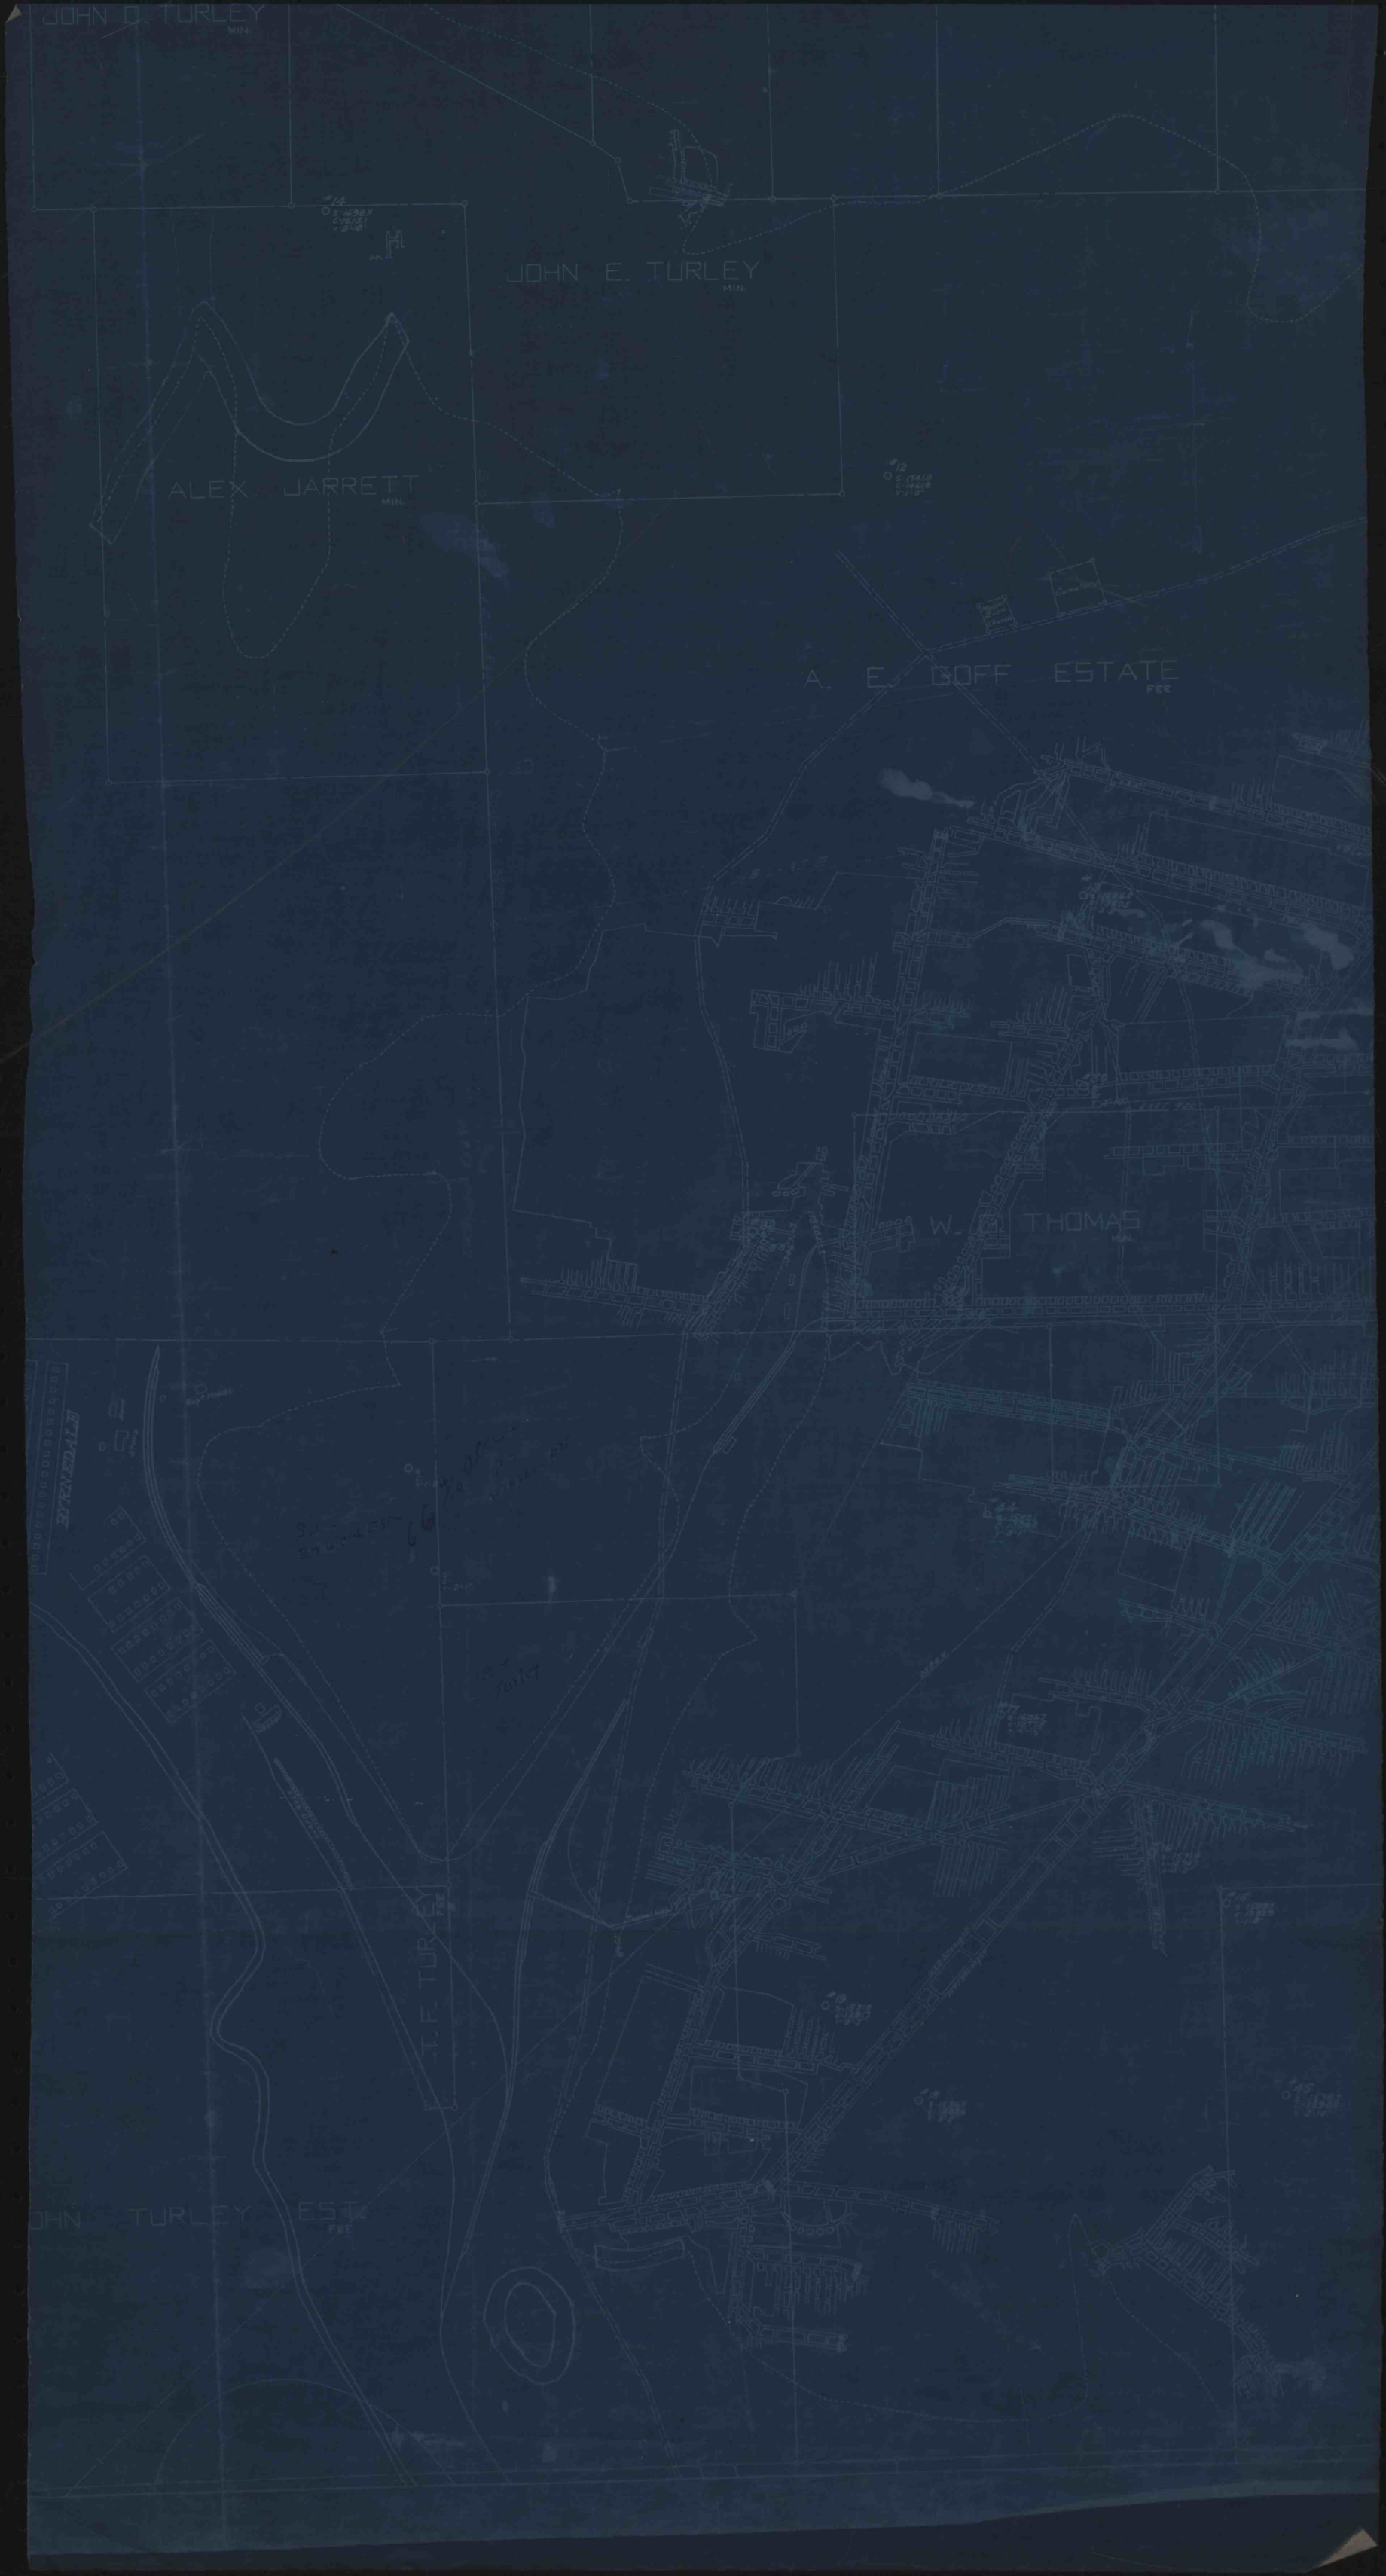
JOHN D. TURLEY
MIN.
JOHN E. TURLEY
MIN.
ALEX. JARRETT
MIN.
A. E. GOFF ESTATE
FEE
W. O. THOMAS
MIN.
BYRNEDALE
T. F. TURLEY
FEE
JOHN TURLEY ESTATE
FEE