


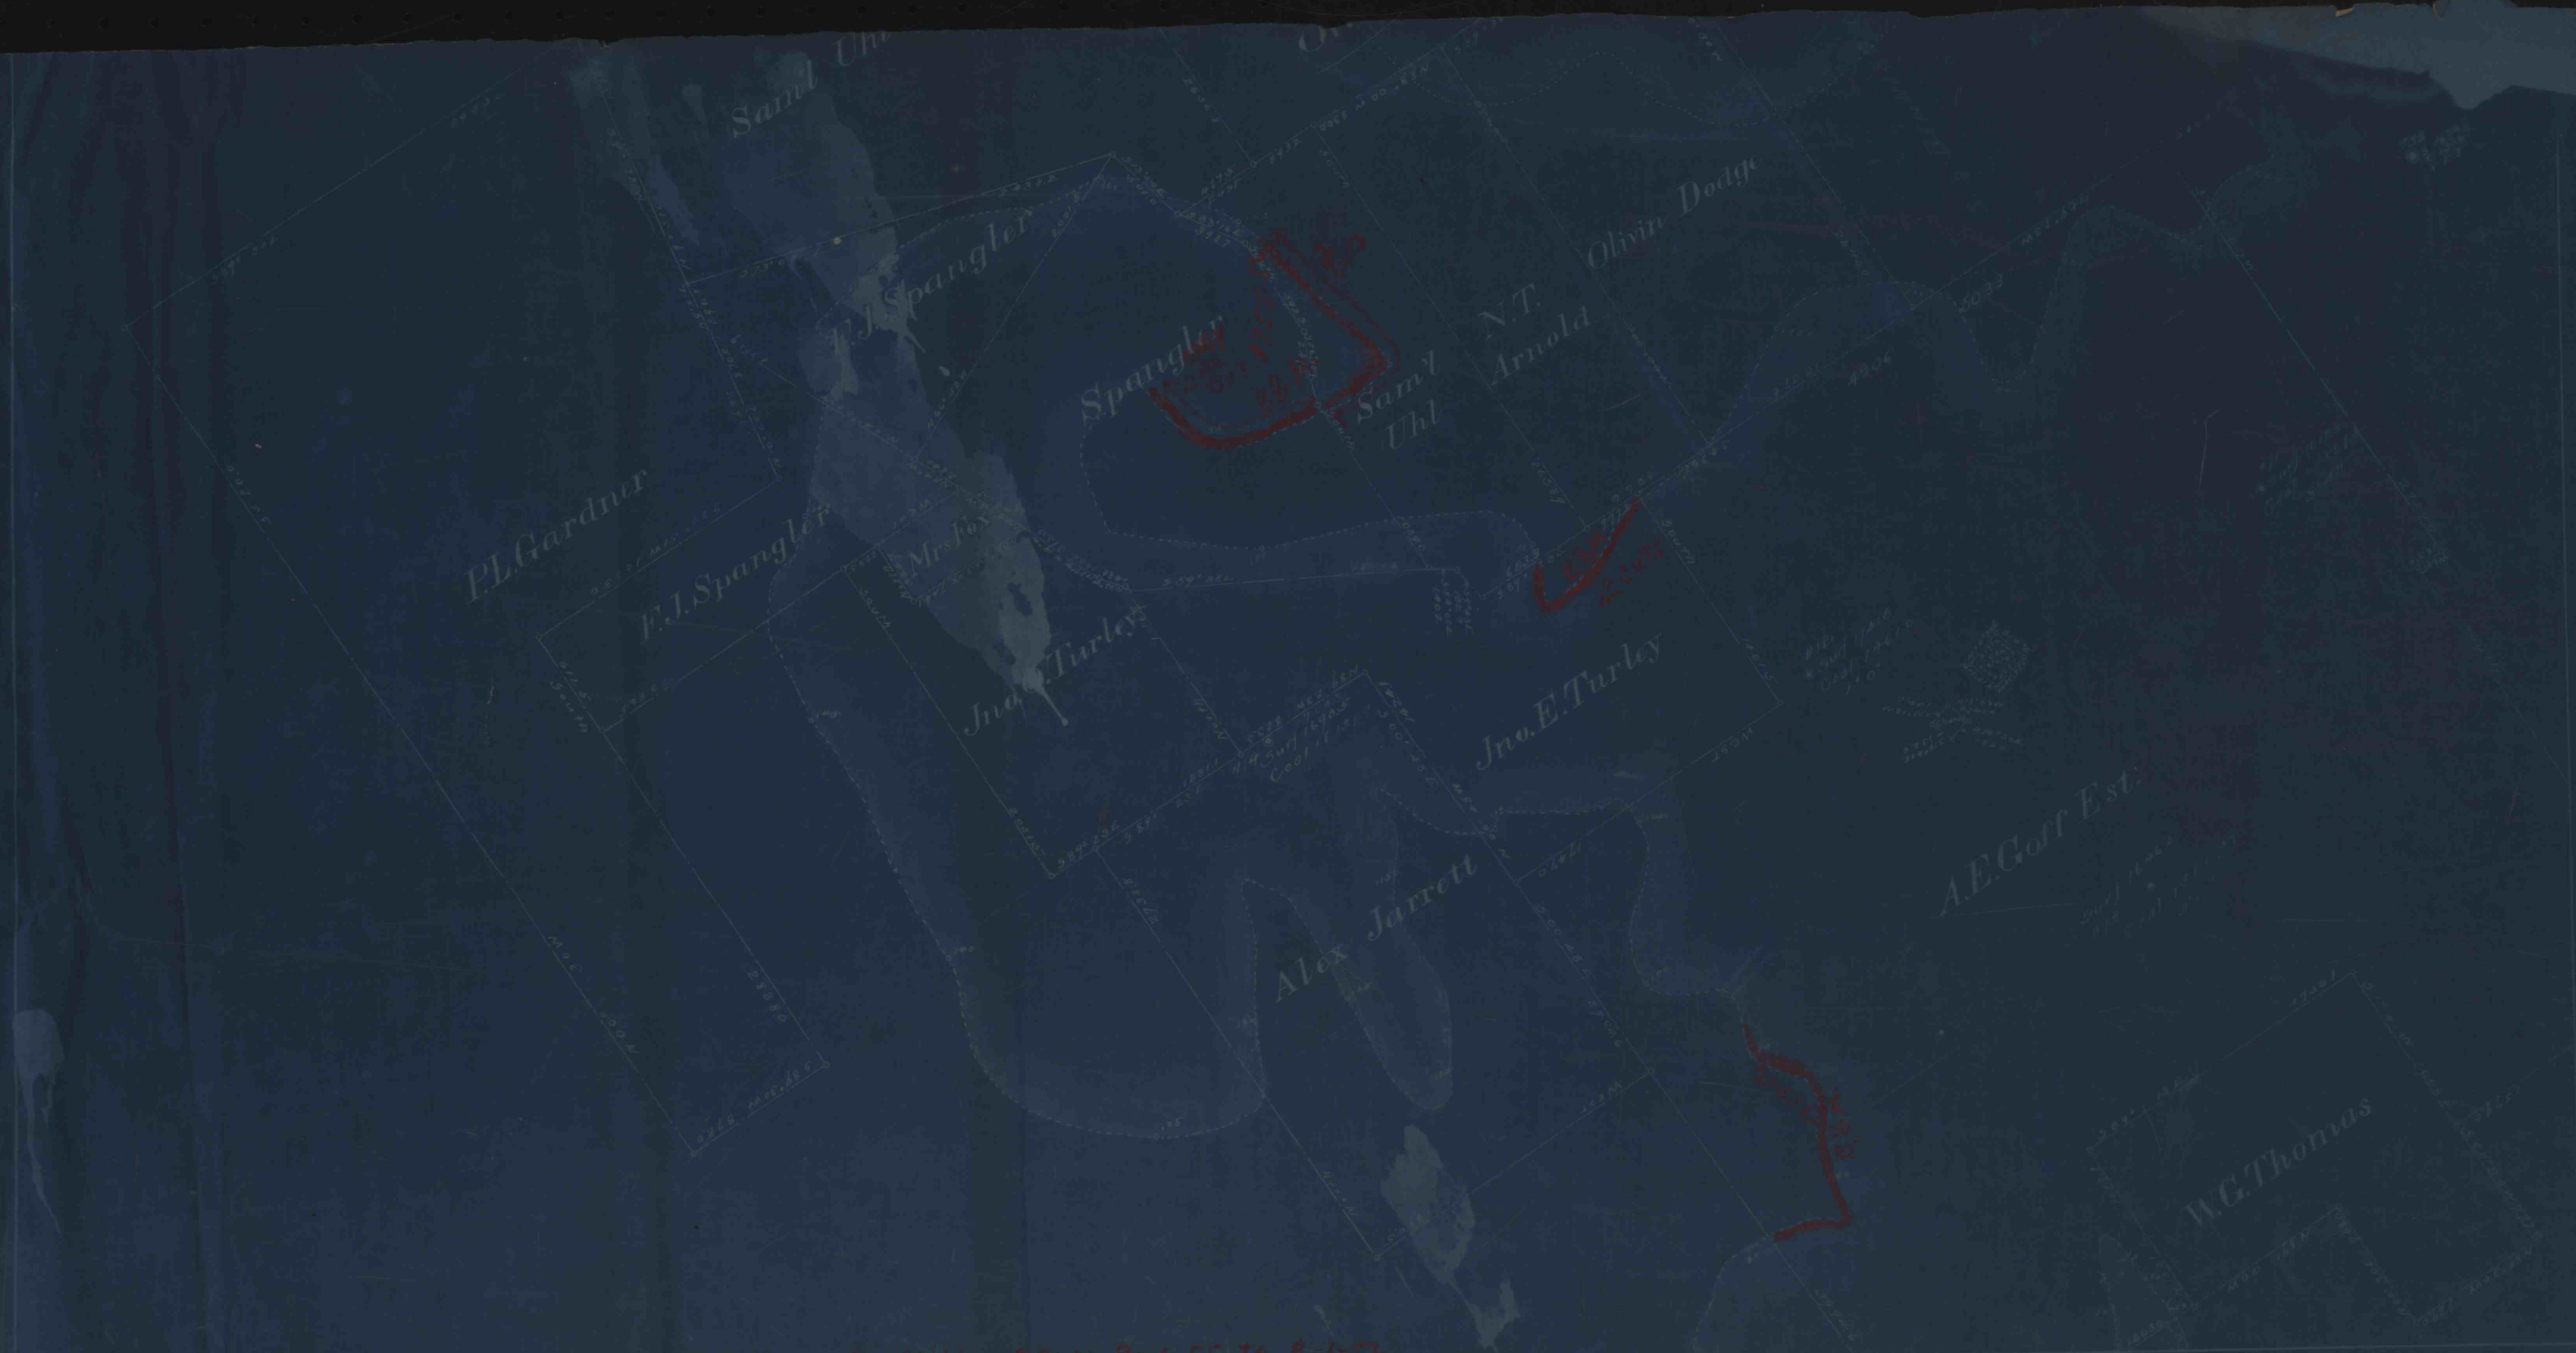

B.B.A. STRIPPING FROM B-1-55 TO B-1-56.