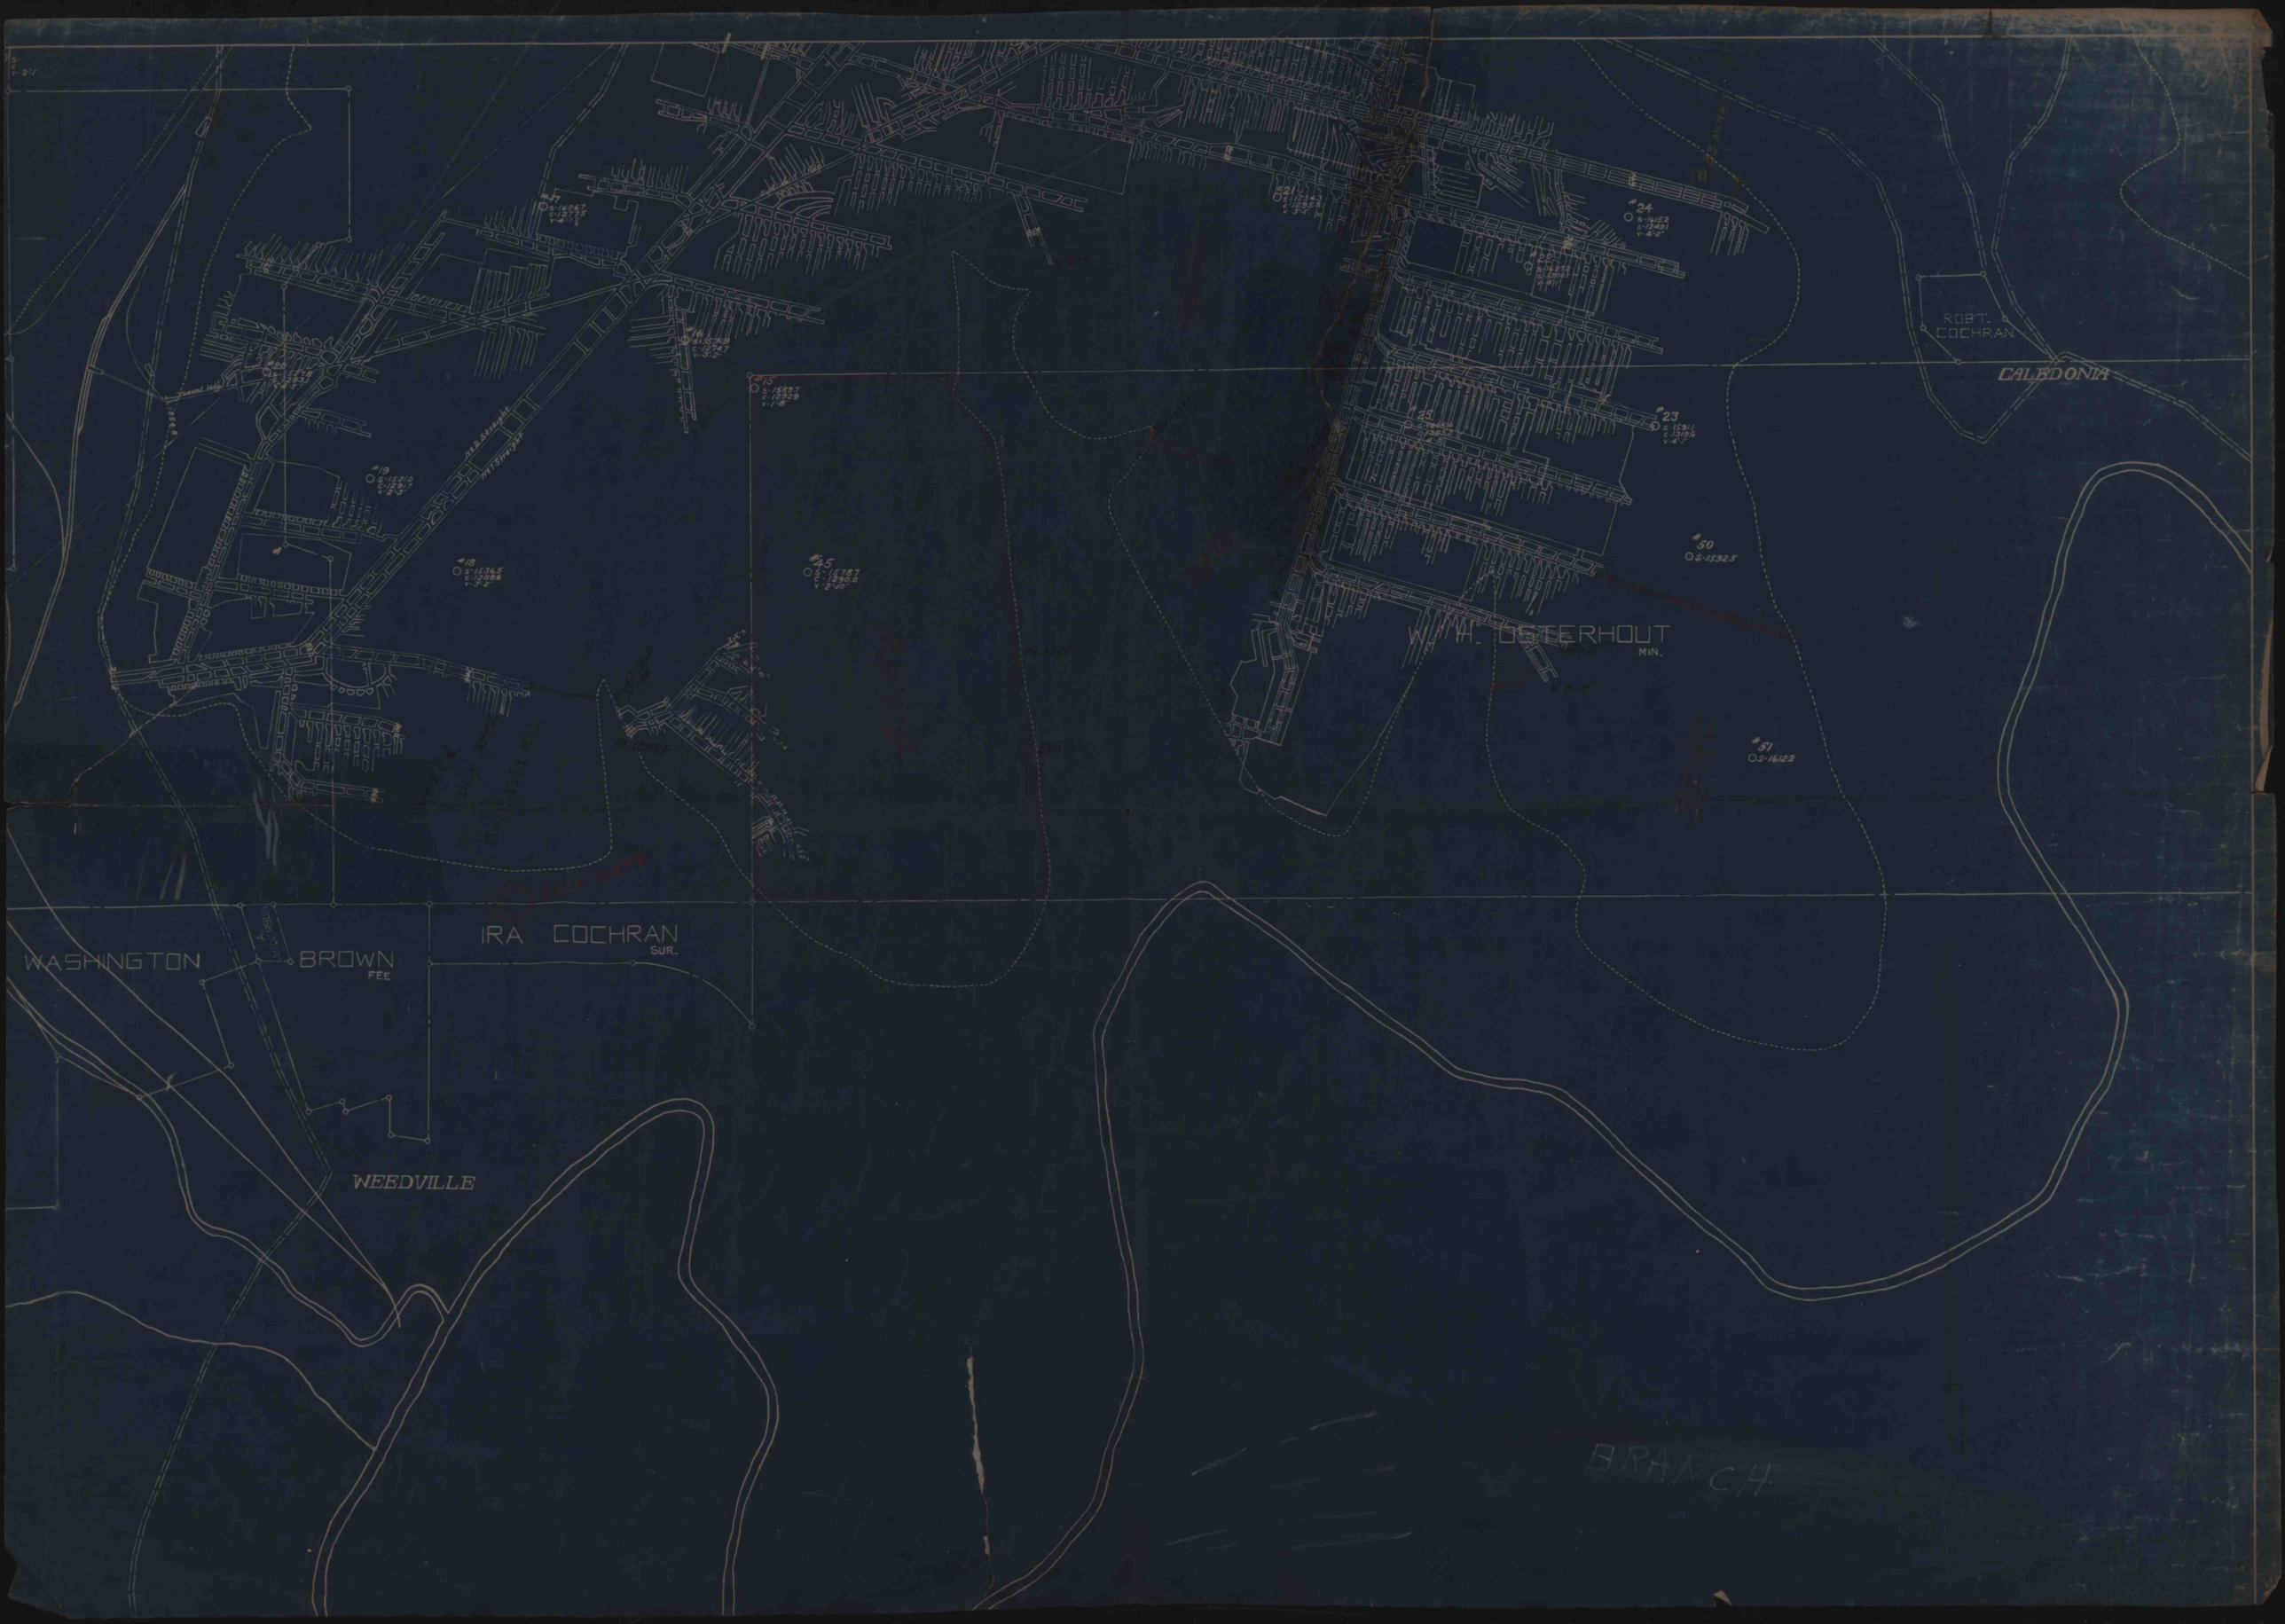
ROB'T. COCHRAN
CALEDONIA
W. H. OSTERHOUT
MIN.
IRA COCHRAN
SUR.
WASHINGTON
BROWN
FEE
WEEDVILLE
BRANCH