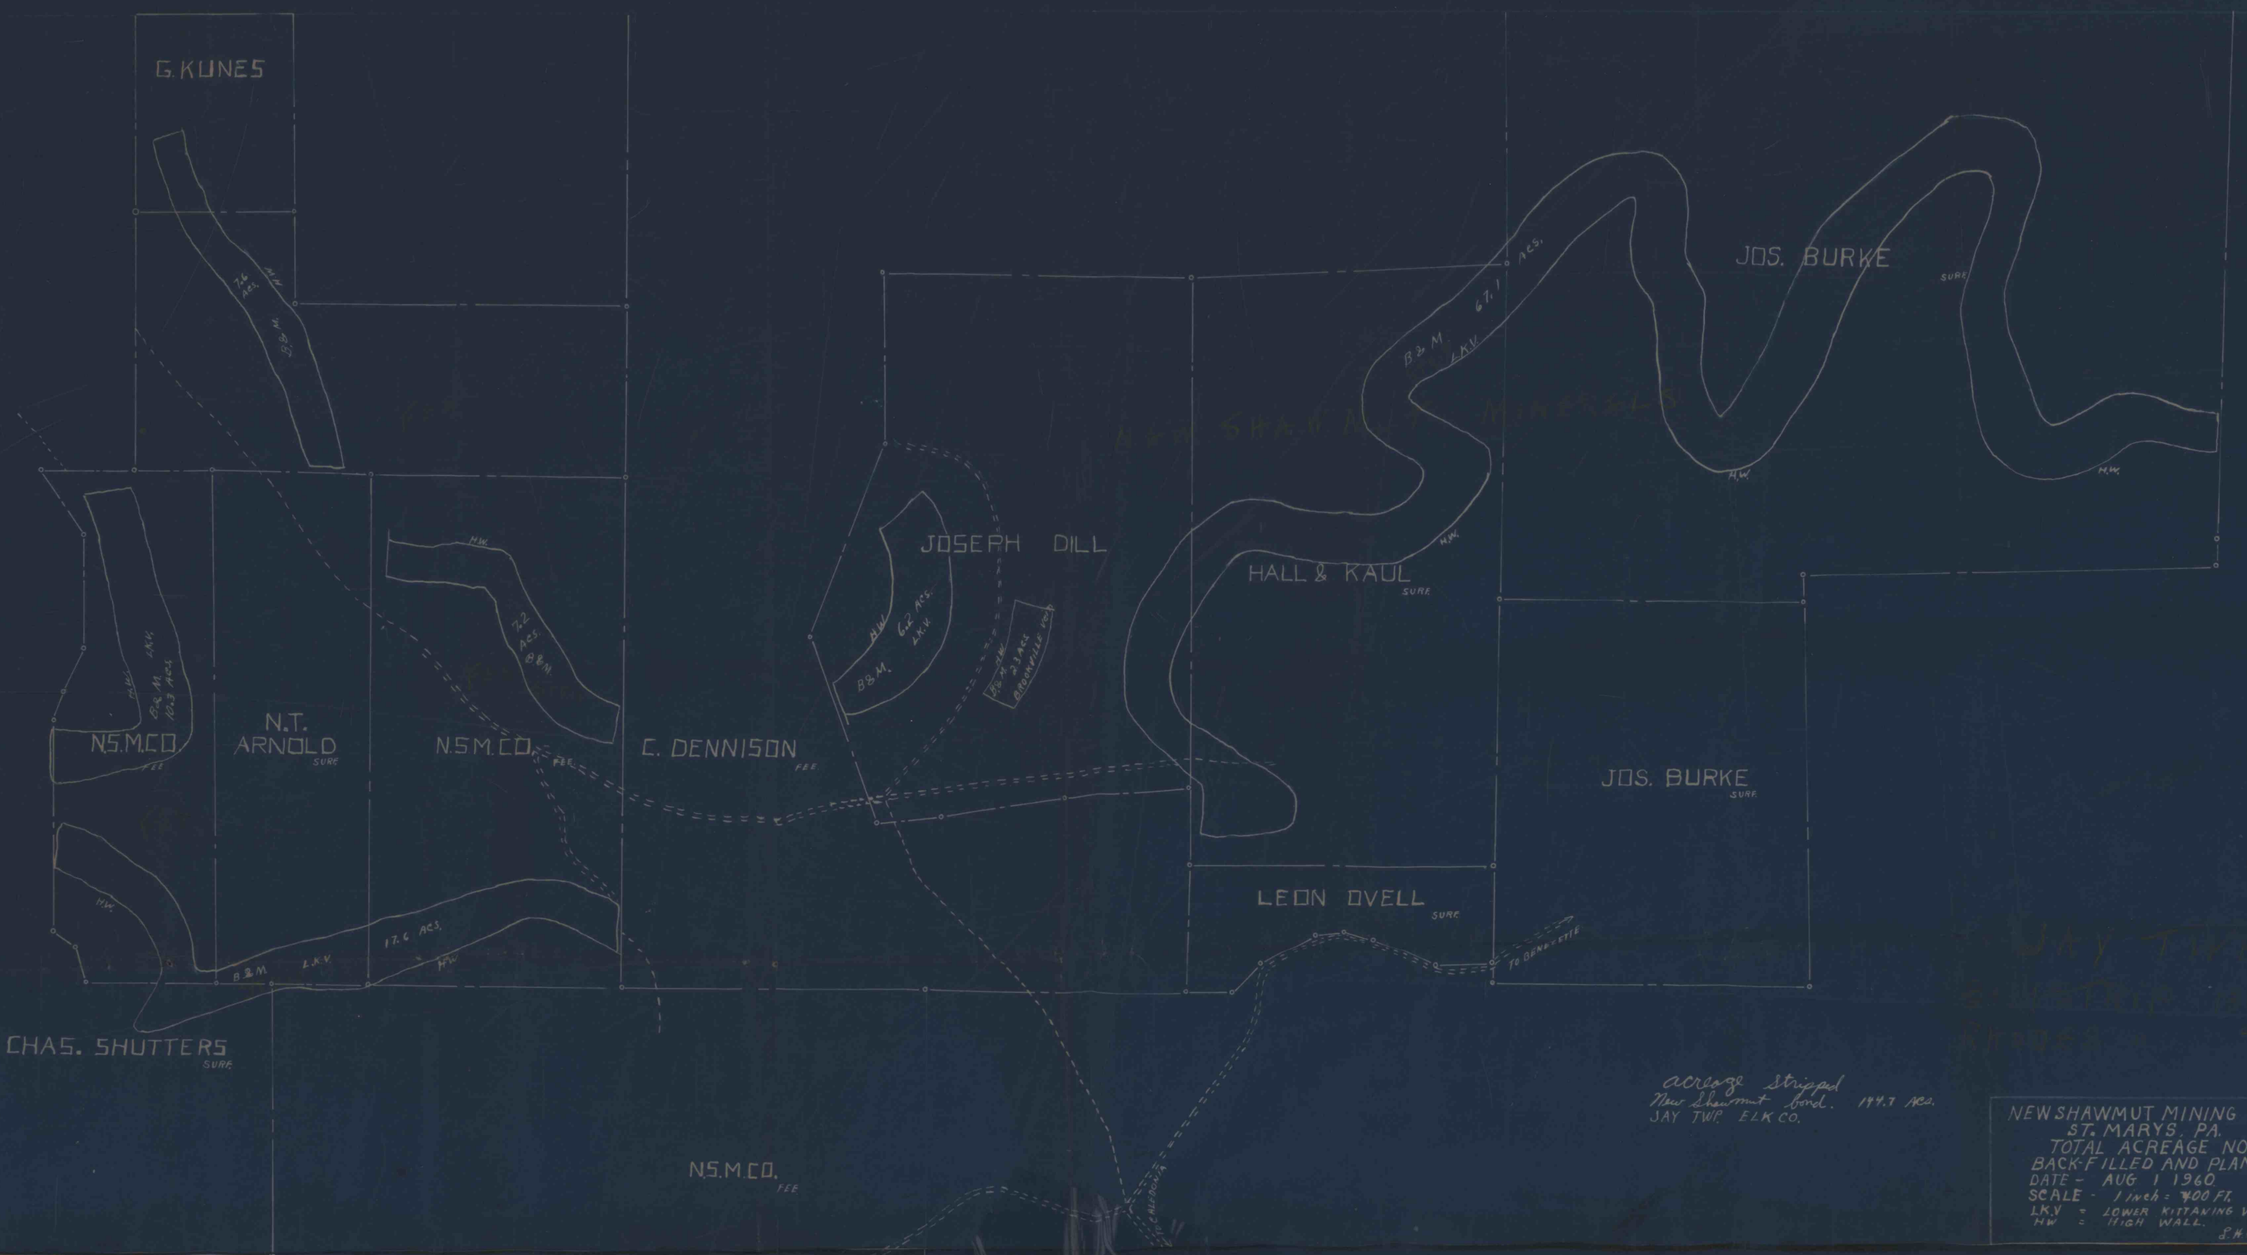
G. KUNES
JOS. BURKE
JOSEPH DILL
HALL & KAUL
N.S.M.CO.
N.T. ARNOLD
N.S.M.CO.
C. DENNISON
JOS. BURKE
LEON OVELL
CHAS. SHUTTERS
N.S.M.CO.
TO CALEDONIA
acreage Stripped
New Shawmut bond. 194.7 Acs.
JAY TWP. ELK CO.
NEW SHAWMUT MINING CO.
ST. MARYS, PA.
TOTAL ACREAGE NOT
BACK-FILLED AND PLANTED
DATE - AUG 1 1960
SCALE - 1 inch = 400 ft.
L.K.V = LOWER KITTANING VEIN
HW = HIGH WALL.
S. H. Burch - Eng.

TO RIDGEWAY
MT. ZION
TWP. ROAD TO WEEDVILLE
16.5 ACS
B&M
L.K.V.
HW
TO CALEDONIA
TO WEEDVILLE