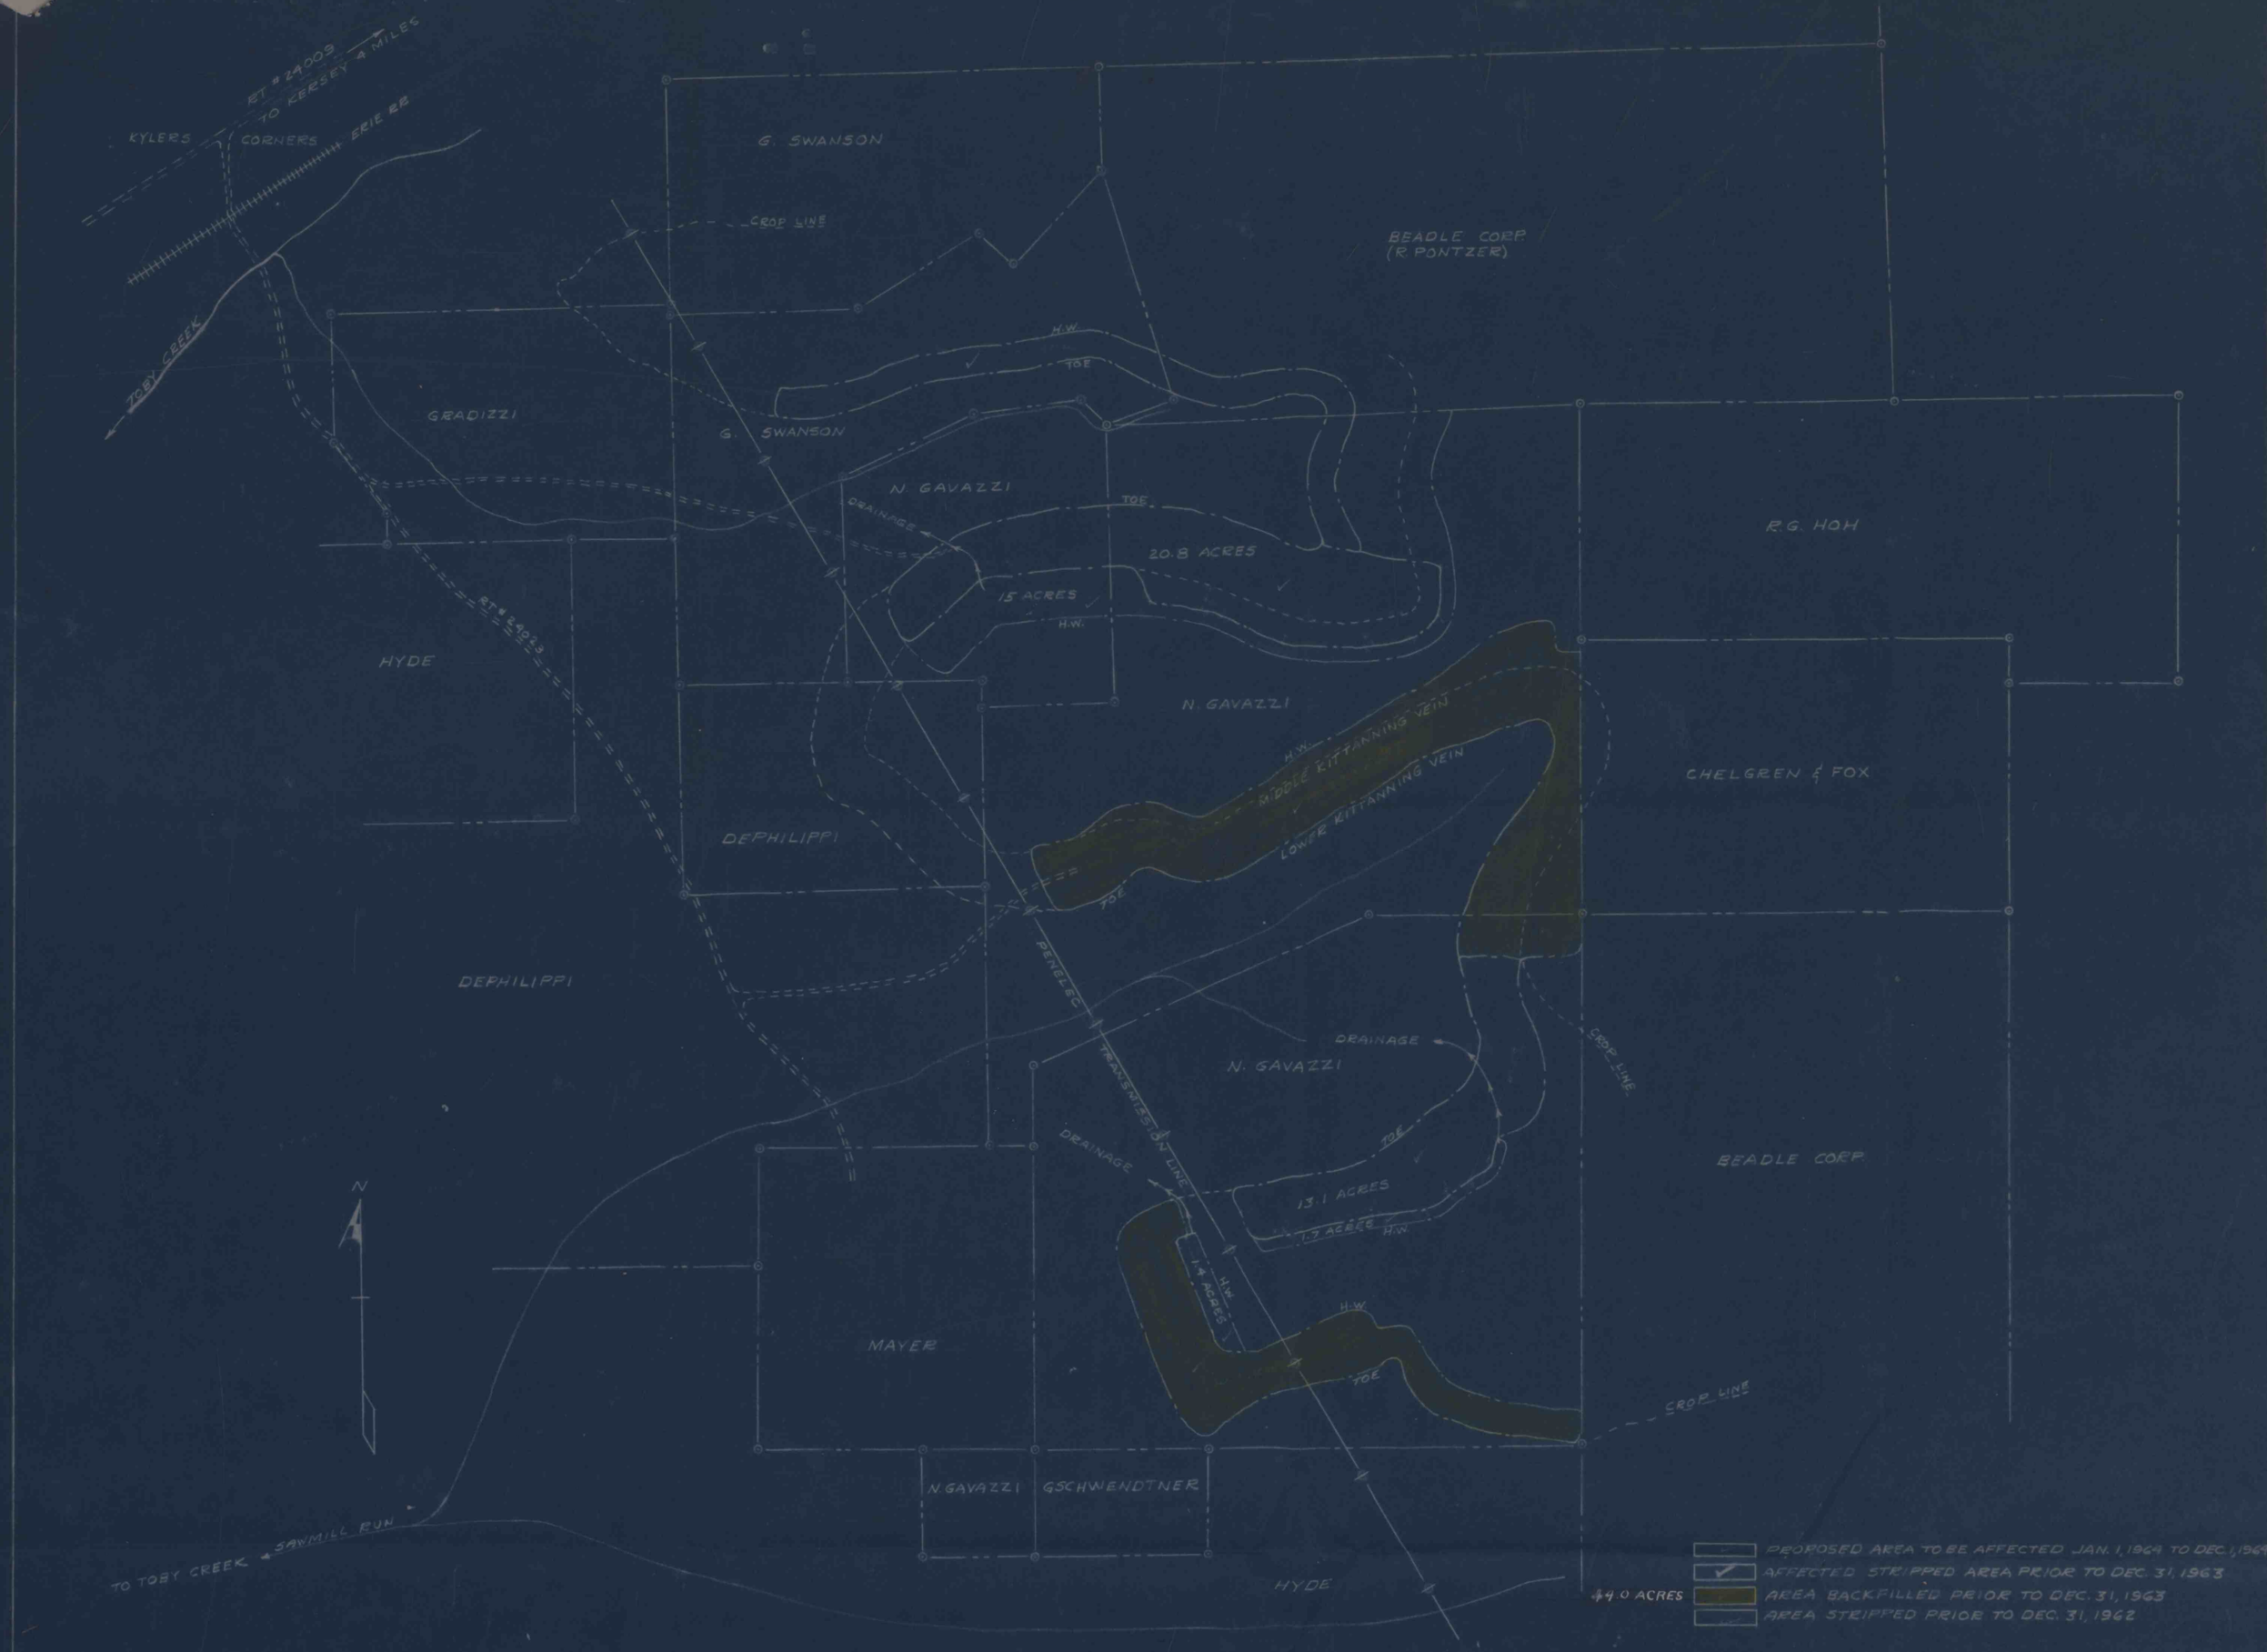
RT # 24009
TO KERSEY 4 MILES
KYLERS
CORNERS
ERIE RR
TOBY CREEK
G. SWANSON
CROP LINE
BEADLE CORP
(R. PONTZER)
H.W.
TOE
GRADIZZI
G. SWANSON
N. GAVAZZI
DRAINAGE
TOE
20.8 ACRES
15 ACRES
H.W.
R.G. HOH
RT # 24009
HYDE
N. GAVAZZI
MIDDLE KITTANNING VEIN
LOWER KITTANNING VEIN
CHELGREN & FOX
DEPHILIPPI
DEPHILIPPI
PENELEC
TRANSMISSION LINE
DRAINAGE
N. GAVAZZI
CROP LINE
DRAINAGE
TOE
BEADLE CORP.
13.1 ACRES
1.3 ACRES
H.W.
1.4 ACRES
H.W.
H.W.
TOE
N
MAYER
CROP LINE
N. GAVAZZI
GSCHWENDTNER
TO TOBY CREEK
SAWMILL RUN
HYDE
PROPOSED AREA TO BE AFFECTED JAN. 1, 1964 TO DEC. 1, 1964
AFFECTED STRIPPED AREA PRIOR TO DEC. 31, 1963
44.0 ACRES
AREA BACKFILLED PRIOR TO DEC. 31, 1963
AREA STRIPPED PRIOR TO DEC. 31, 1962
UTILITY LINE
NEW SHAWMUT MINING CO.
ST. MARYS, PENNA.
STRIP MINING OPERATION
FOX TOWNSHIP, ELK COUNTY
DATE: 12-23-63 SCALE: 1" = 400'
DRAWN BY - JAMES D. BROWN
NS P-13-2-18
NS NO 26, PGS 16, 17 & 18