


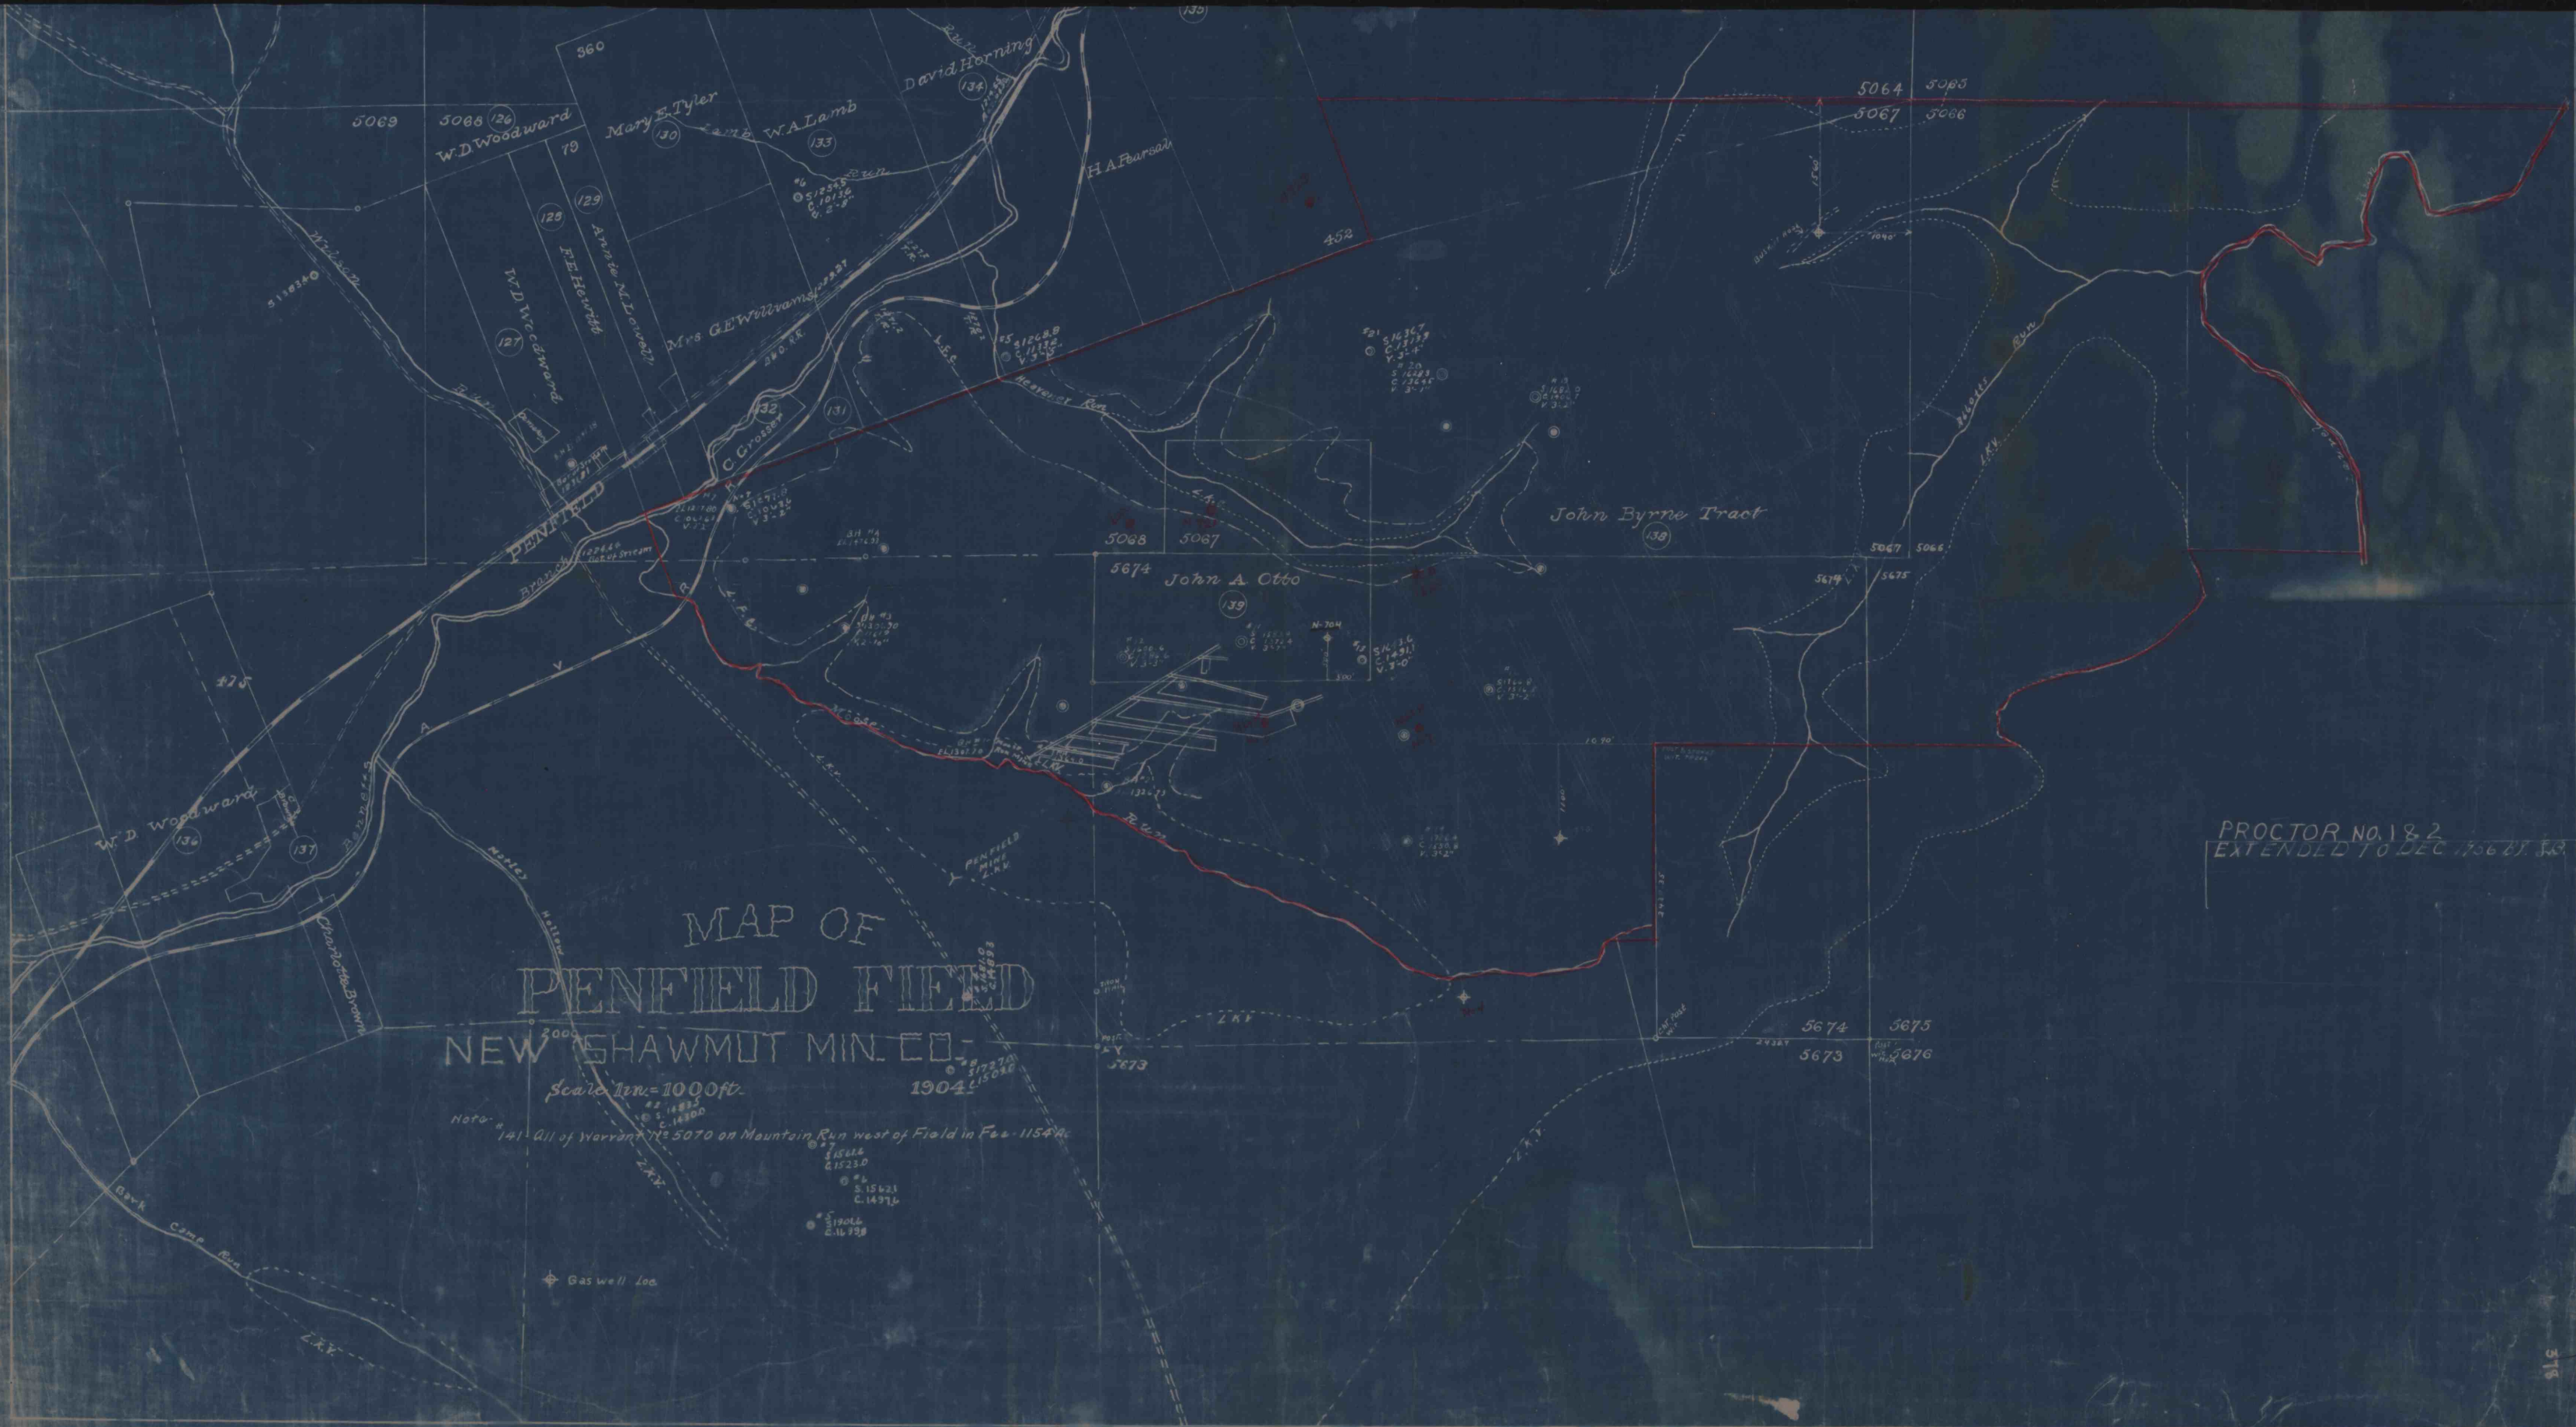

PROCTOR NO. 182
EXTENDED TO DEC. 1862 J.S.

MAP OF
PENFIELD FIELD
NEW SHAWMUT MIN. CO.
Scale 1 in = 1000 ft.
1904

Note: 141 All of Warrant No. 5070 on Mountain Run west of Field in Feb. 1854.

Gas well loc.