


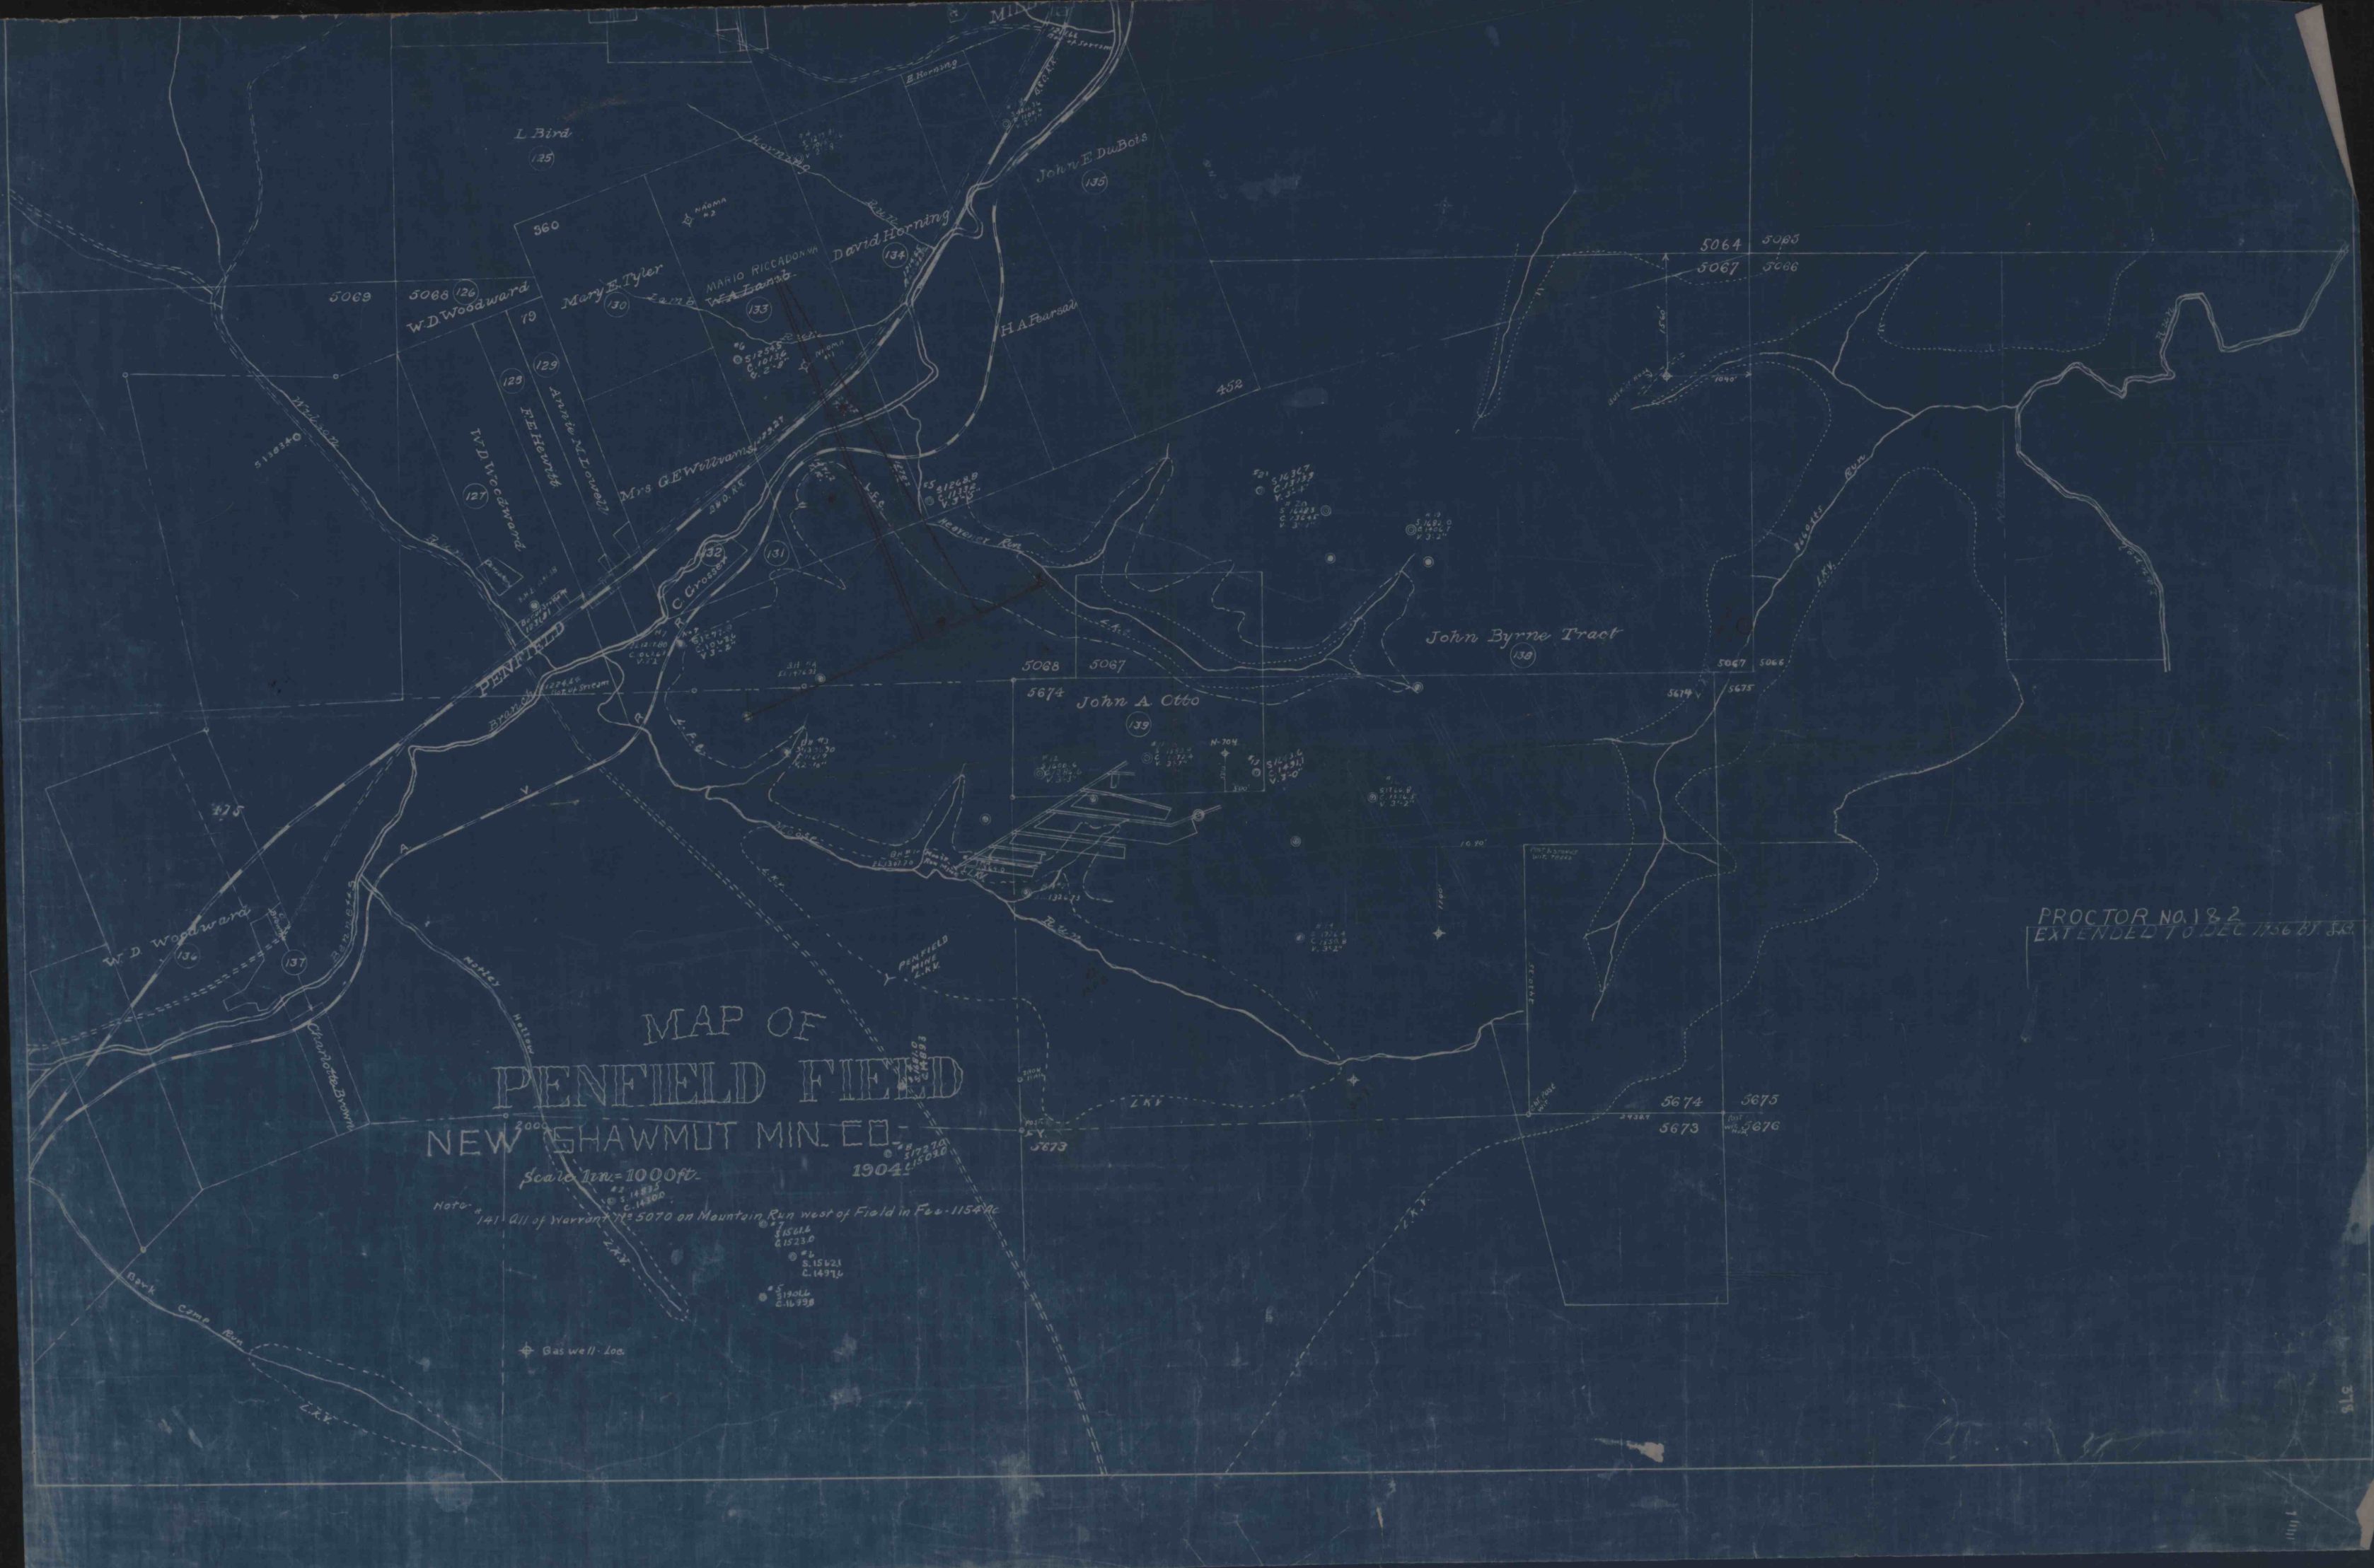

MAP OF
PENFIELD FIELD

NEW SHAWMUT MIN. CO.

Scale 1 in = 1000 ft.

Note: 141- All of Warrant No. 5070 on Mountain Run west of Field in Feb. 1154 Ac.

1904

PROCTOR No. 182
EXTENDED TO DEC. 1756 BY J.R.

Gas well - loc.