


CONCRETING LOG

EXCAVATION LOG

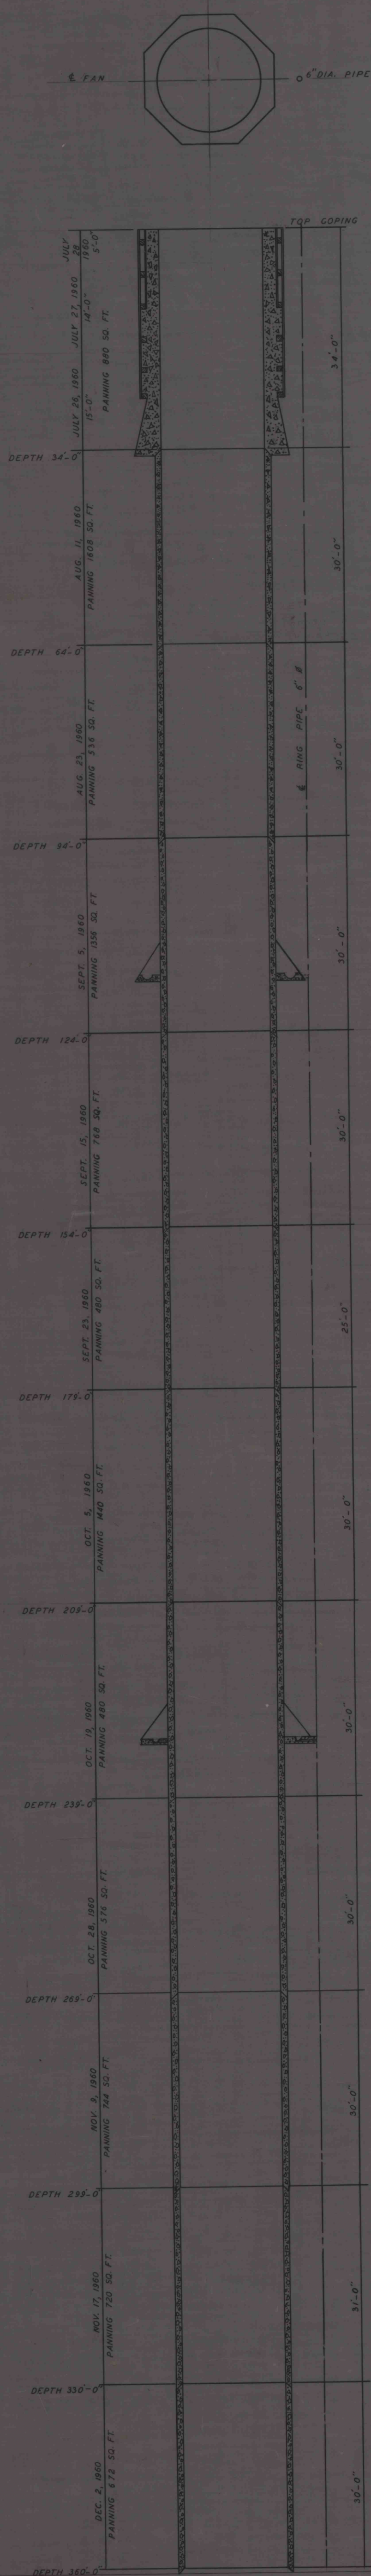

BETHLEHEM MINES CORPORATION
 ELLSWORTH PA.
 COLUMNAR SECTION OF MINE #51
 HORNE SHAFT
 DEC. 12, 1960

SCALE $\frac{1}{8}" = 1'$ 