
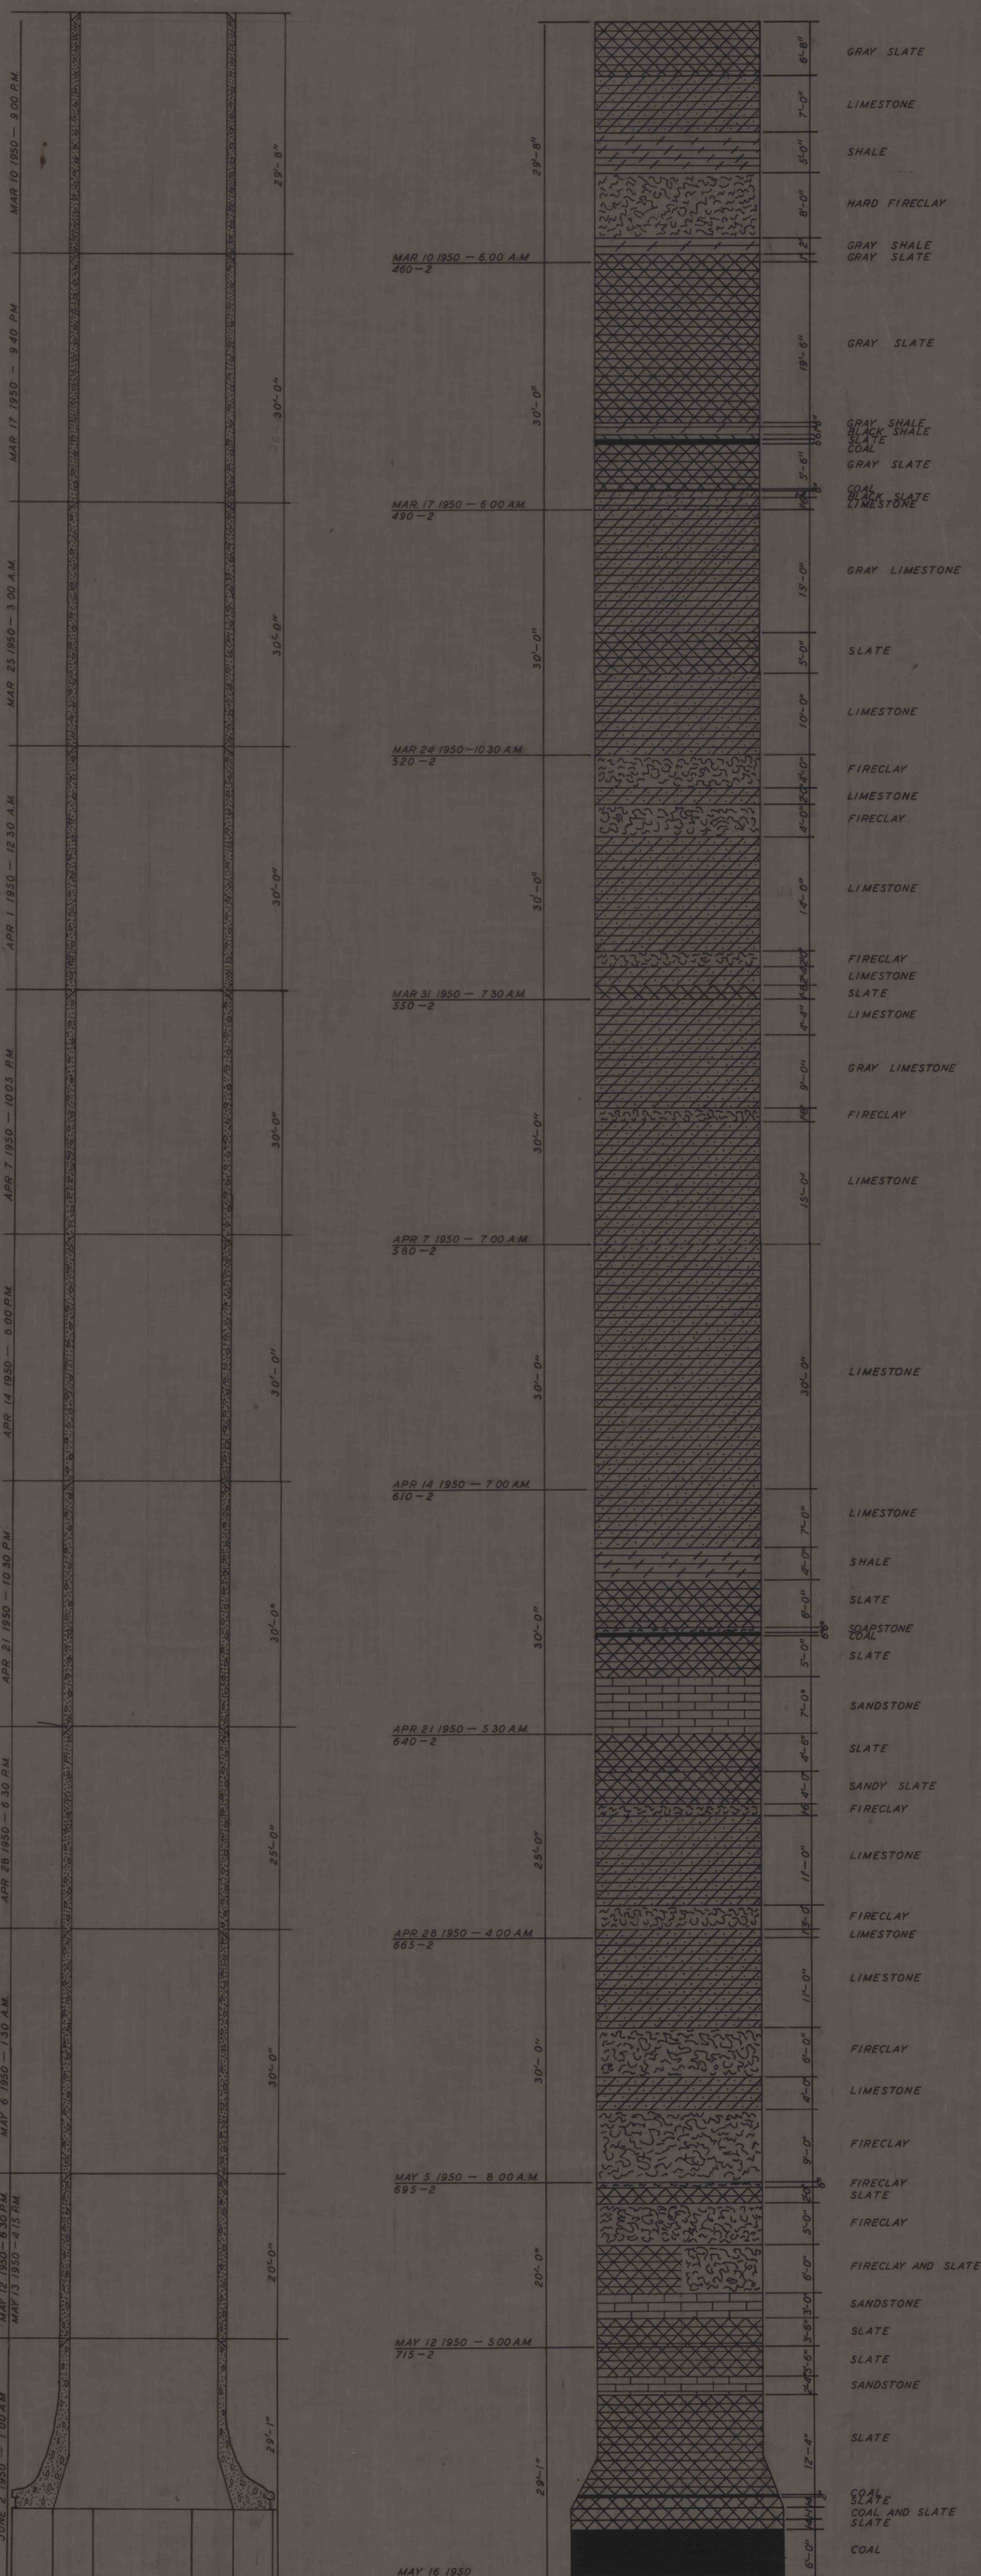
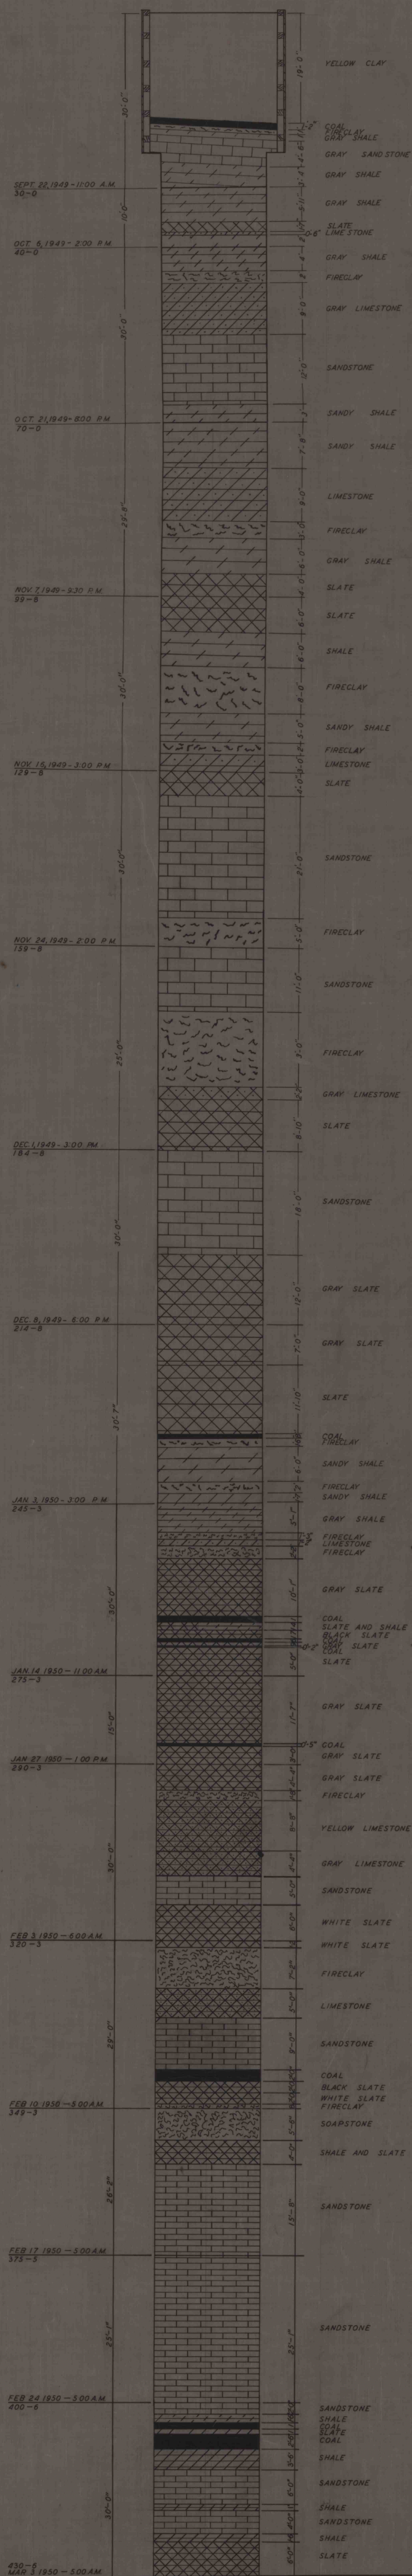
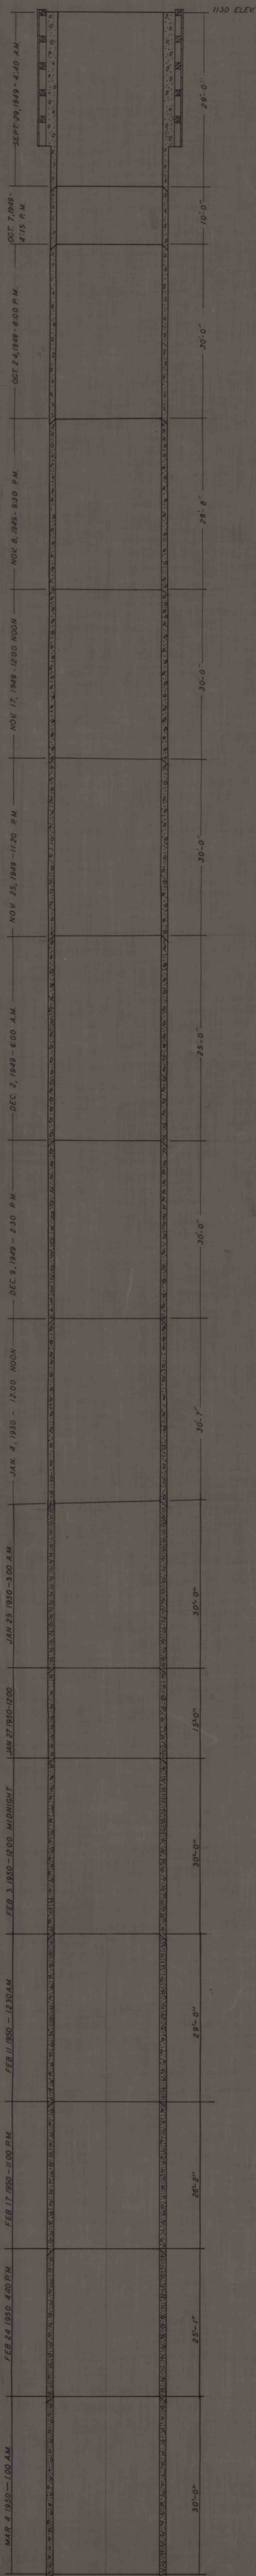


CONCRETING LOG

SHAFT SINKING LOG

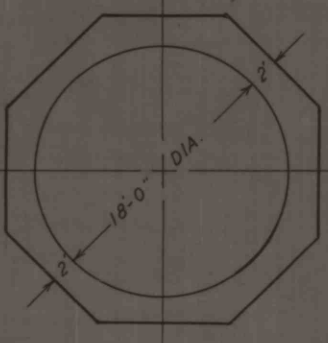

NOTE
FOR ARRANGEMENT OF SHAFT BOTTOM
SEE BETHLEHEM COLLIERIES DWGS
HOS 28024 11-12-13
FOOTER POURED MAY 18 1950
SIDE WALLS MAY 26 1950
ARCH JUNE 1 1950
SHAFT JUNE 2 1950

BETHLEHEM COLLIERIES CORP.
ELLSWORTH PA.
COLUMNAR SECTION OF MINE 50
HOOVER SHAFT
SCALE 1/8"=1'