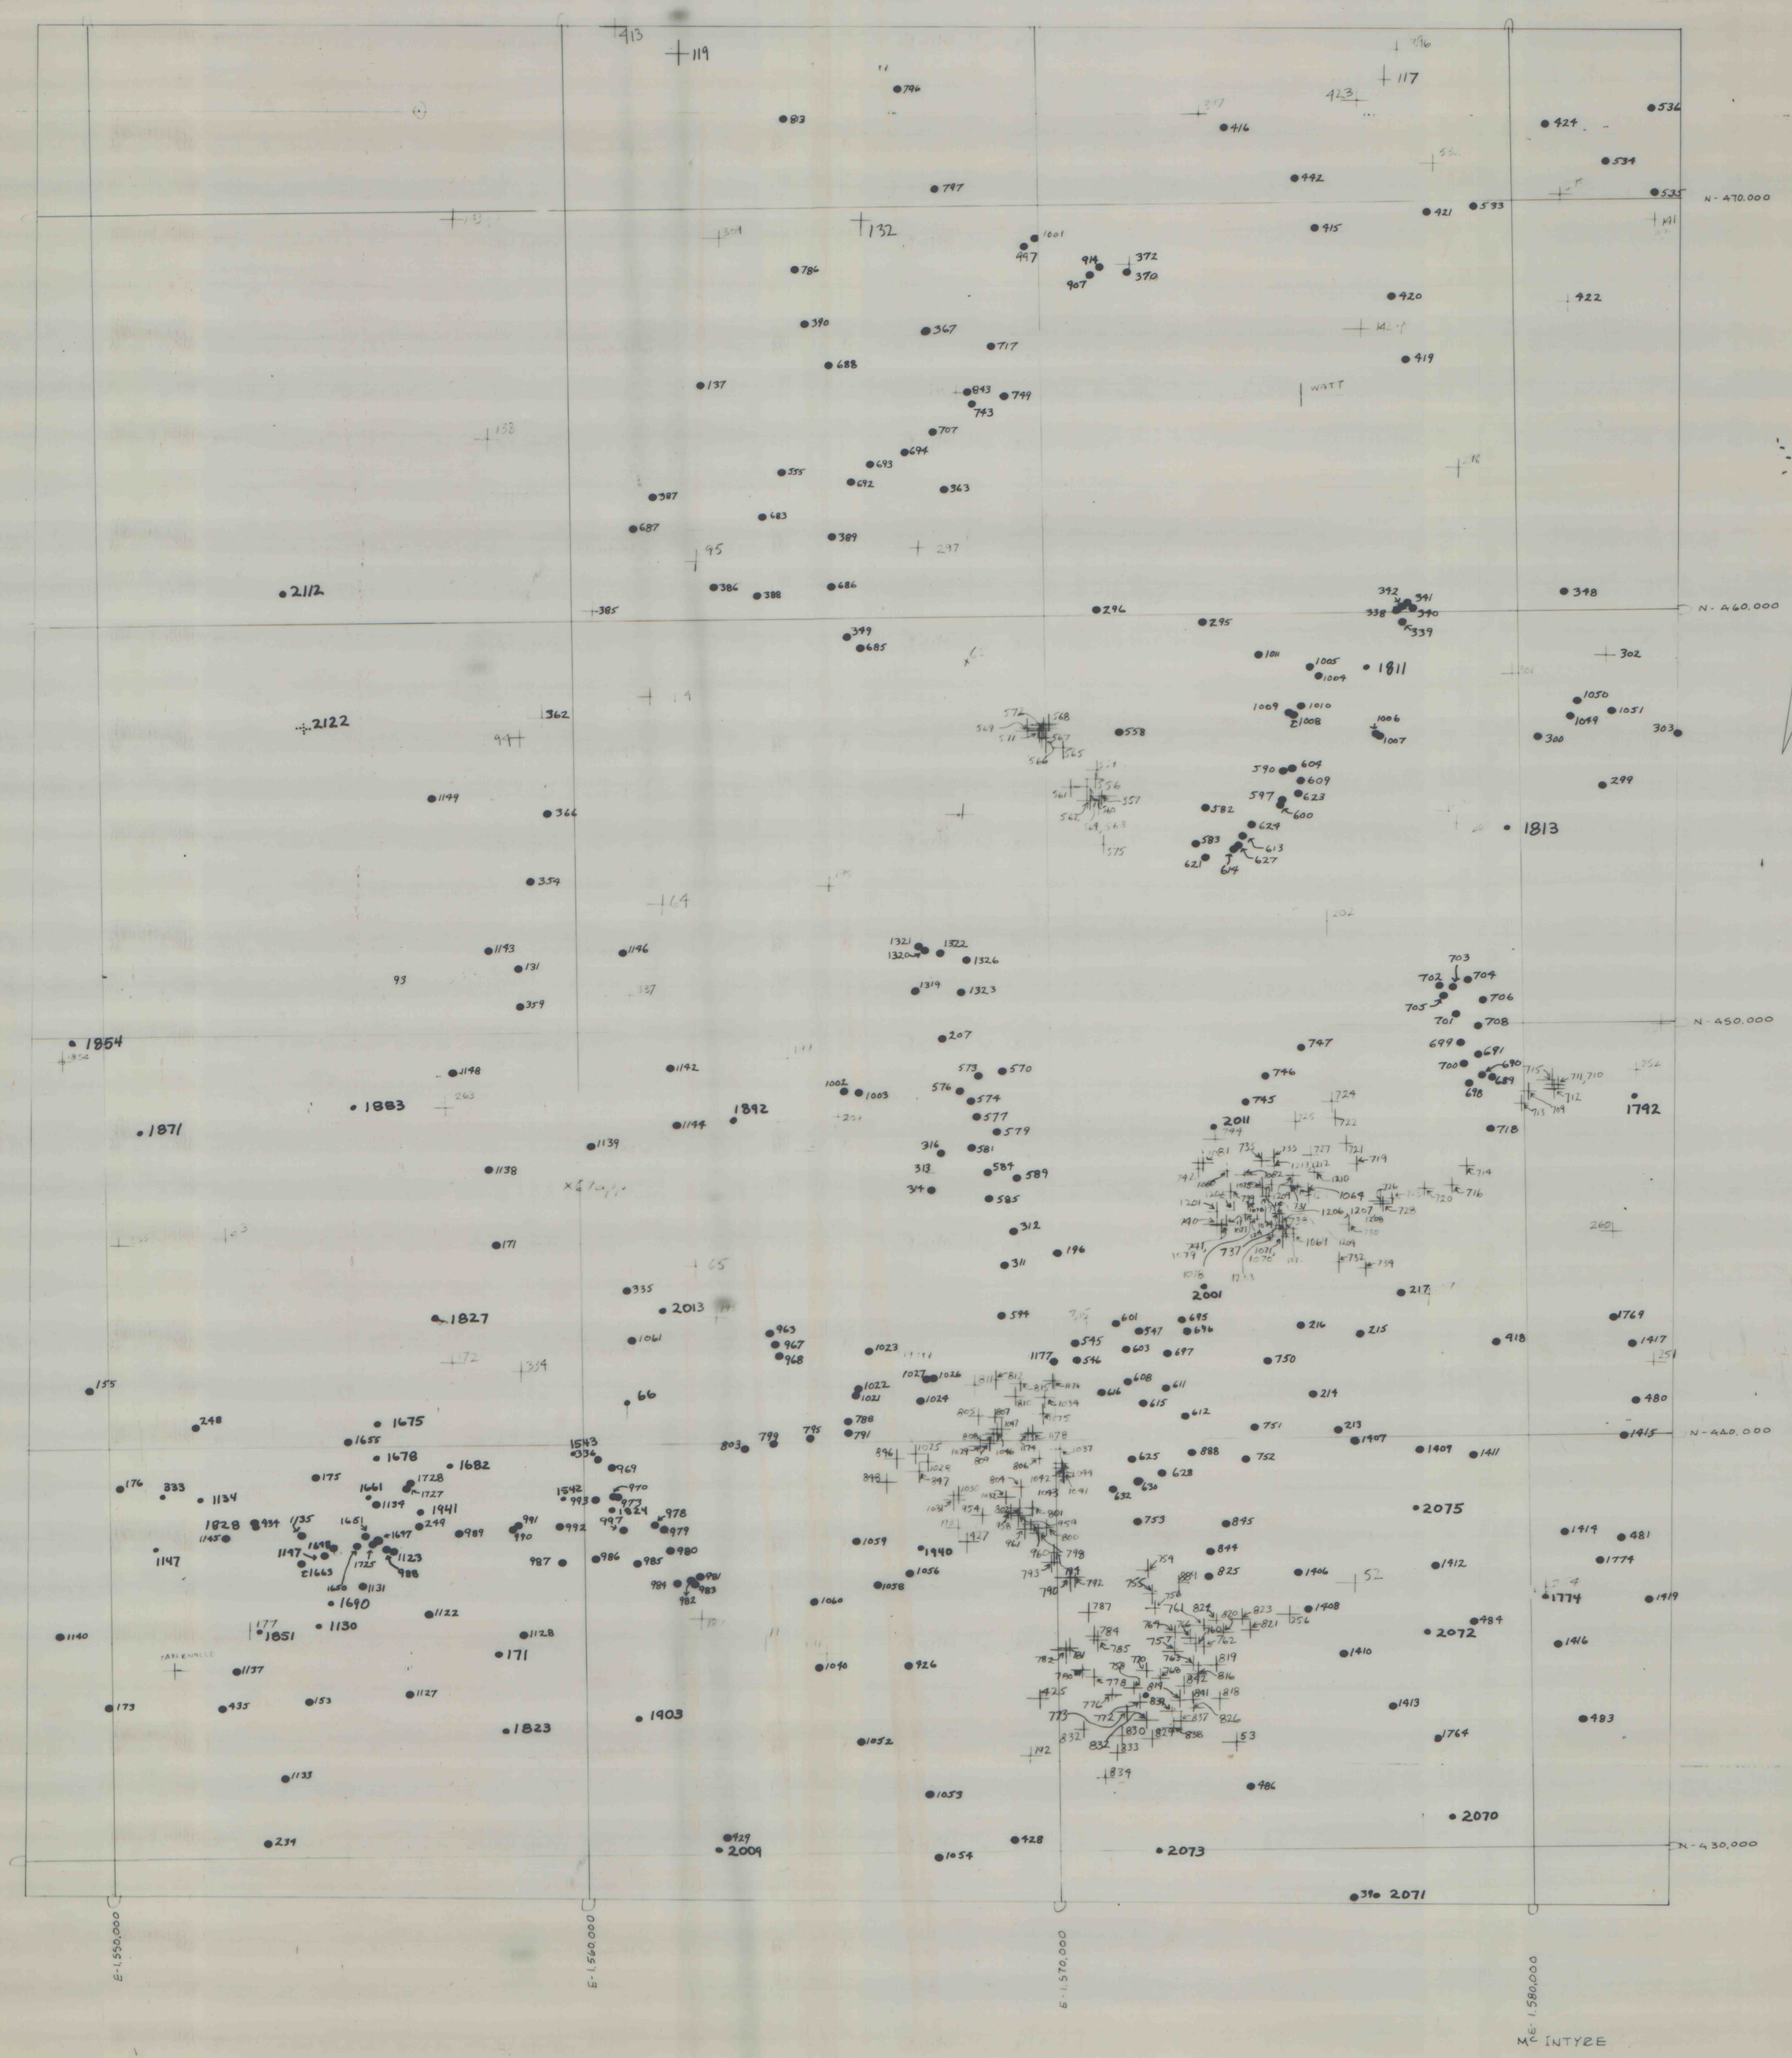
N-470,000
N-460,000
N-450,000
N-440,000
N-430,000
E-1,550,000
E-1,560,000
E-1,570,000
E-1,580,000
McINTYRE
WATT

IMAPS
#13681