

MAHONING SEAM

Chan.	9	Strip Pt	Sul.	Fusion	BSI
H	8"	23.8	.53	2800	Non H
B	15"	2.5	.43	2535	"
C	17"	4.3	.42	2800	"
D	7"	15.6	.78	2800	"

"E" Vn.

Chan.	#1	Test Pt	8' Surface	BSI
H	7"	23.9	.37	2300
B	7 1/2"	15.3	.40	2170
C	15 1/2"	14.8	.57	2345
D	9"	30.4	.87	2410

Chan.	#2	15' Highwall	Sul.	Fusion	BSI
H	8"	3.3	.63	2570	1
B	8 1/2"	2.5	.60	2425	2 1/2
C	19 1/2"	6.5	.77	2675	6 1/2
D	1"	23.8	1.10	2680	2 1/2
E	4 1/2"	13.2	1.10	2700	8

Chan.	#5	250' inby drift	Sul.	Fusion	BSI
H	7 1/2"	38.1	1.60	2725	2 1/2
B	5"	14.1	1.25	2800	6 1/2
C	28 1/2"	5.4	1.60	2290	4 1/2
D	10"	15.5	3.50	2275	3 1/2
E	4"	21.7	1.60	2675	3 1/2

Chan.	#6	600' inby drift	Sul.	Fusion	BSI
H	7"	24.9	3.60	2450	4
B	28"	7.7	3.25	2330	5 1/2
C	24"	20.3	5.15	2330	5 1/2
D	3 1/2"	62.5	1.30	2800	5 1/2
E	6 1/2"	22.2	4.80	2325	5 1/2

Chan.	#7	drift	Sul.	Fusion	BSI
H	2"	16.6	5.35	2280	4
B	28"	6.9	3.40	2025	6
C	11 1/2"	17.5	2.90	2420	2 1/2
D	3 1/2"	31.0	3.15	2560	2 1/2

Chan.	#8	400' inby drift	Sul.	Fusion	BSI
H	7"	41.8	4.05	2260	2 1/2
B	4"	16.0	3.70	2290	5 1/2
C	27"	5.9	2.90	1985	4 1/2
D	4"	15.9	2.35	2430	2
E	3 1/2"	34.6	5.10	2335	5 1/2
F	7"	15.7	4.05	2215	3 1/2
G	3 1/2"	27.7	2.65	2450	3 1/2

Chan.	#11	285' inby drift	Sul.	Fusion	BSI
H	7"	44.8	1.50	2775	1
B	4"	22.4	1.10	2800	8 1/2
C	25"	4.8	1.70	2320	5 1/2
D	7"	11.0	2.00	2470	Non H
E	4"	65.4	1.10	2800	3
F	5"	27.7	3.45	2510	3

Chan.	#13	strip	Sul.	Fusion	BSI
H	10 1/2"	33.9	1.10	2800	1
B	5"	12.4	1.05	2720	2 1/2
C	31"	5.0	1.10	2350	6 1/2
D	11"	11.7	1.20	2665	6 1/2
E	4 1/2"	24.8	1.90	2725	3

Chan.	#14	300' inby drift	Sul.	Fusion	BSI
H	7"	18.8	7.65	2090	4 1/2
B	25"	8.2	4.50	2140	5 1/2
C	13"	13.7	2.75	2365	3 1/2
D	4"	30.2	3.25	2570	3

Chan.	#15	225' inby drift	Sul.	Fusion	BSI
H	7 1/2"	41.9	1.50	2800	1
B	4"	33.0	1.85	2750	3
C	4 1/2"	8.3	1.75	2400	4 1/2
D	24 1/2"	4.3	1.20	2400	5
E	13"	12.3	.92	2800	7 1/2
F	4"	28.8	1.00	2800	3 1/2

Chan.	#7	740' inby drift	Sul.	Fusion	BSI
H	10"	42.8	4.00	2620	1 1/2
B	2 1/2"	35.3	3.50	2600	4 1/2
C	5"	11.5	3.30	2400	5
D	14"	5.5	3.25	2165	5 1/2
E	13"	4.6	1.85	2325	3 1/2
F	13"	15.7	2.75	2475	3 1/2
G	5"	20.7	1.85	2700	3 1/2

Chan.	#19	75' inby high wall	Sul.	Fusion	BSI
H	8 1/2"	43.4	.61	2800	Non H
B	6"	20.5	.76	2770	1 1/2
C	11 1/2"	5.8	1.55	2325	7 1/2
D	17 1/2"	4.4	1.40	2260	3 1/2
E	12"	13.7	.87	2800	4
F	11"	11.8	1.05	2800	2 1/2

"D" Vn.

Chan.	#3	75' inby drift	Sul.	Fusion	BSI
H	7"	24.4	1.30	2800	Non H
B	27"	79.8	.60	2670	4 1/2
C	19"	23.6	2.20	2800	8
D	38 1/2"	8.7	1.90	2400	6
E	5"	22.8	3.10	2540	6


"C" Vn.

Chan.	#10	400' inby drift	Sul.	Fusion	BSI
H	8"	27.9	10.00	2090	5 1/2
B	7"	6.9	3.60	2100	5 1/2
C	21 1/2"	5.4	2.40	2175	5 1/2
D	2"	10.9	1.75	2625	3 1/2
E	6 1/2"	10.5	3.00	2320	4 1/2

Chan.	#12	350' inby drift	Sul.	Fusion	BSI
H	5"	7.8	3.70	2120	4 1/2
B	28"	7.0	2.70	2200	5
C	2 3/4"	22.9	3.85	2310	5

"B" Vn.

Chan.	#4	330' inby drift	Sul.	Fusion	BSI
H	7 1/2"	3.1	.77	2365	BSI
B	11"	3.6	.73	2800	7
C	15"	63.9	.27	2800	Non H
D	14"	6.8	1.05	2800	"
E	3"	5.6	2.50	2370	"

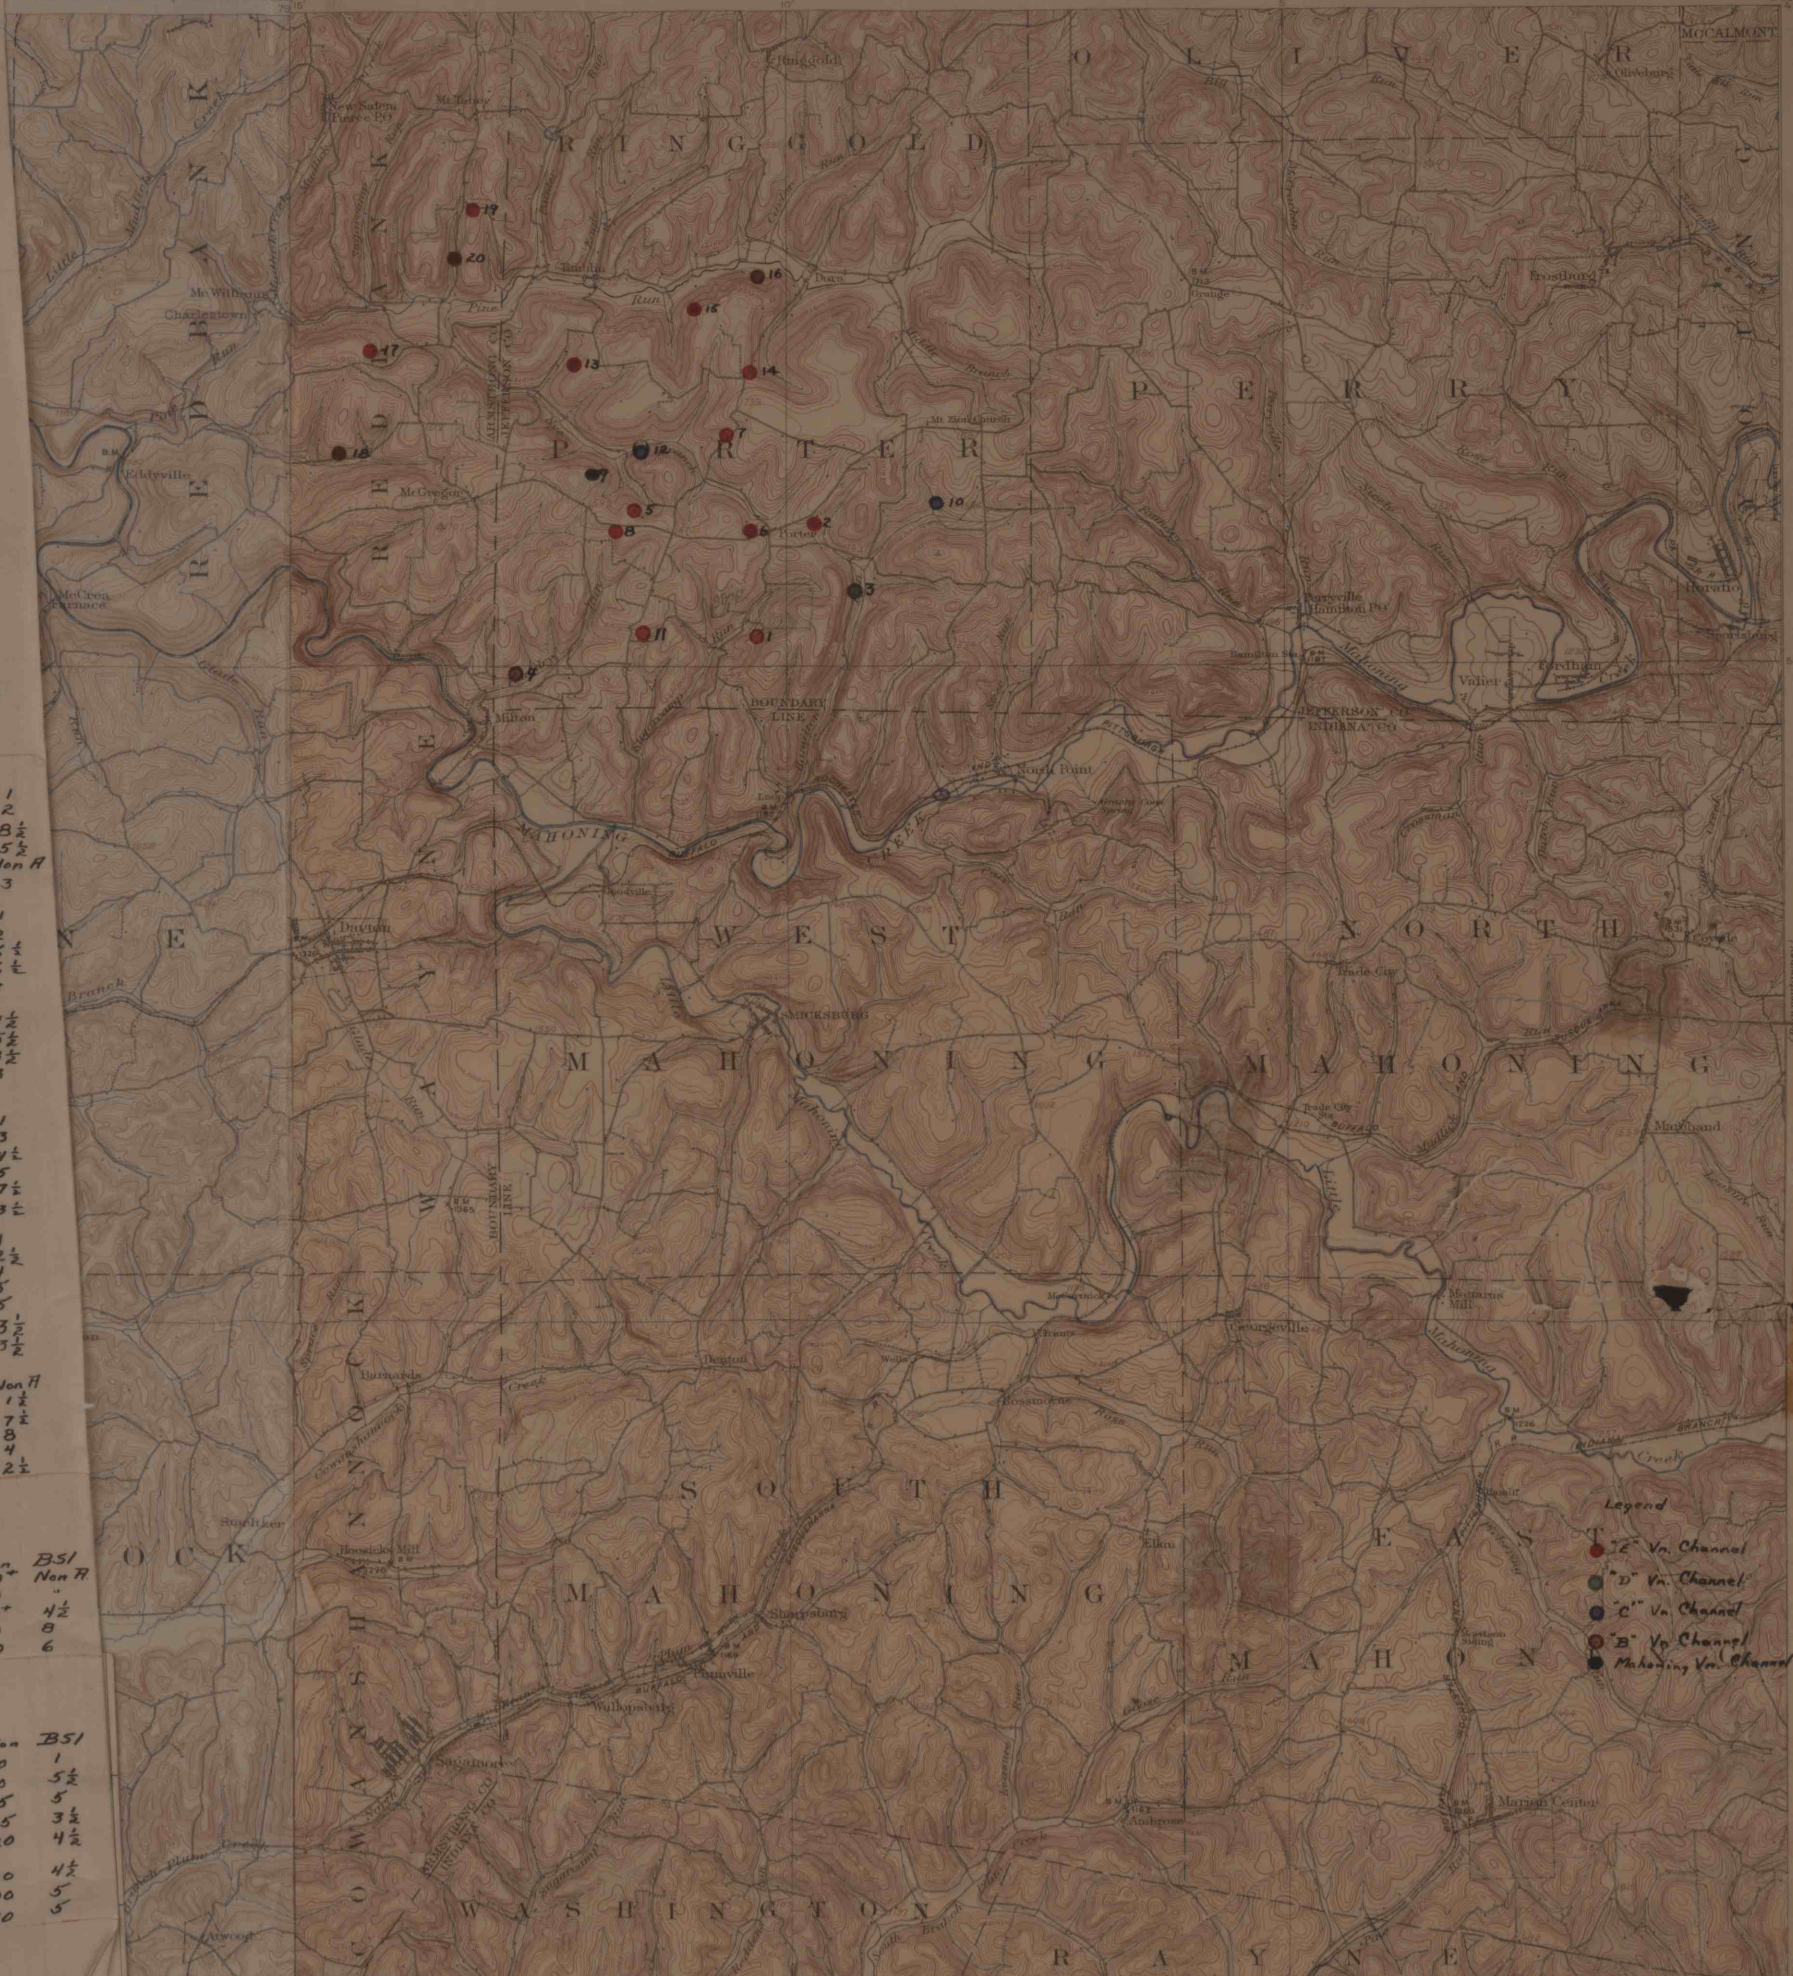

- Legend
 - Mahoning Vn. Channel