


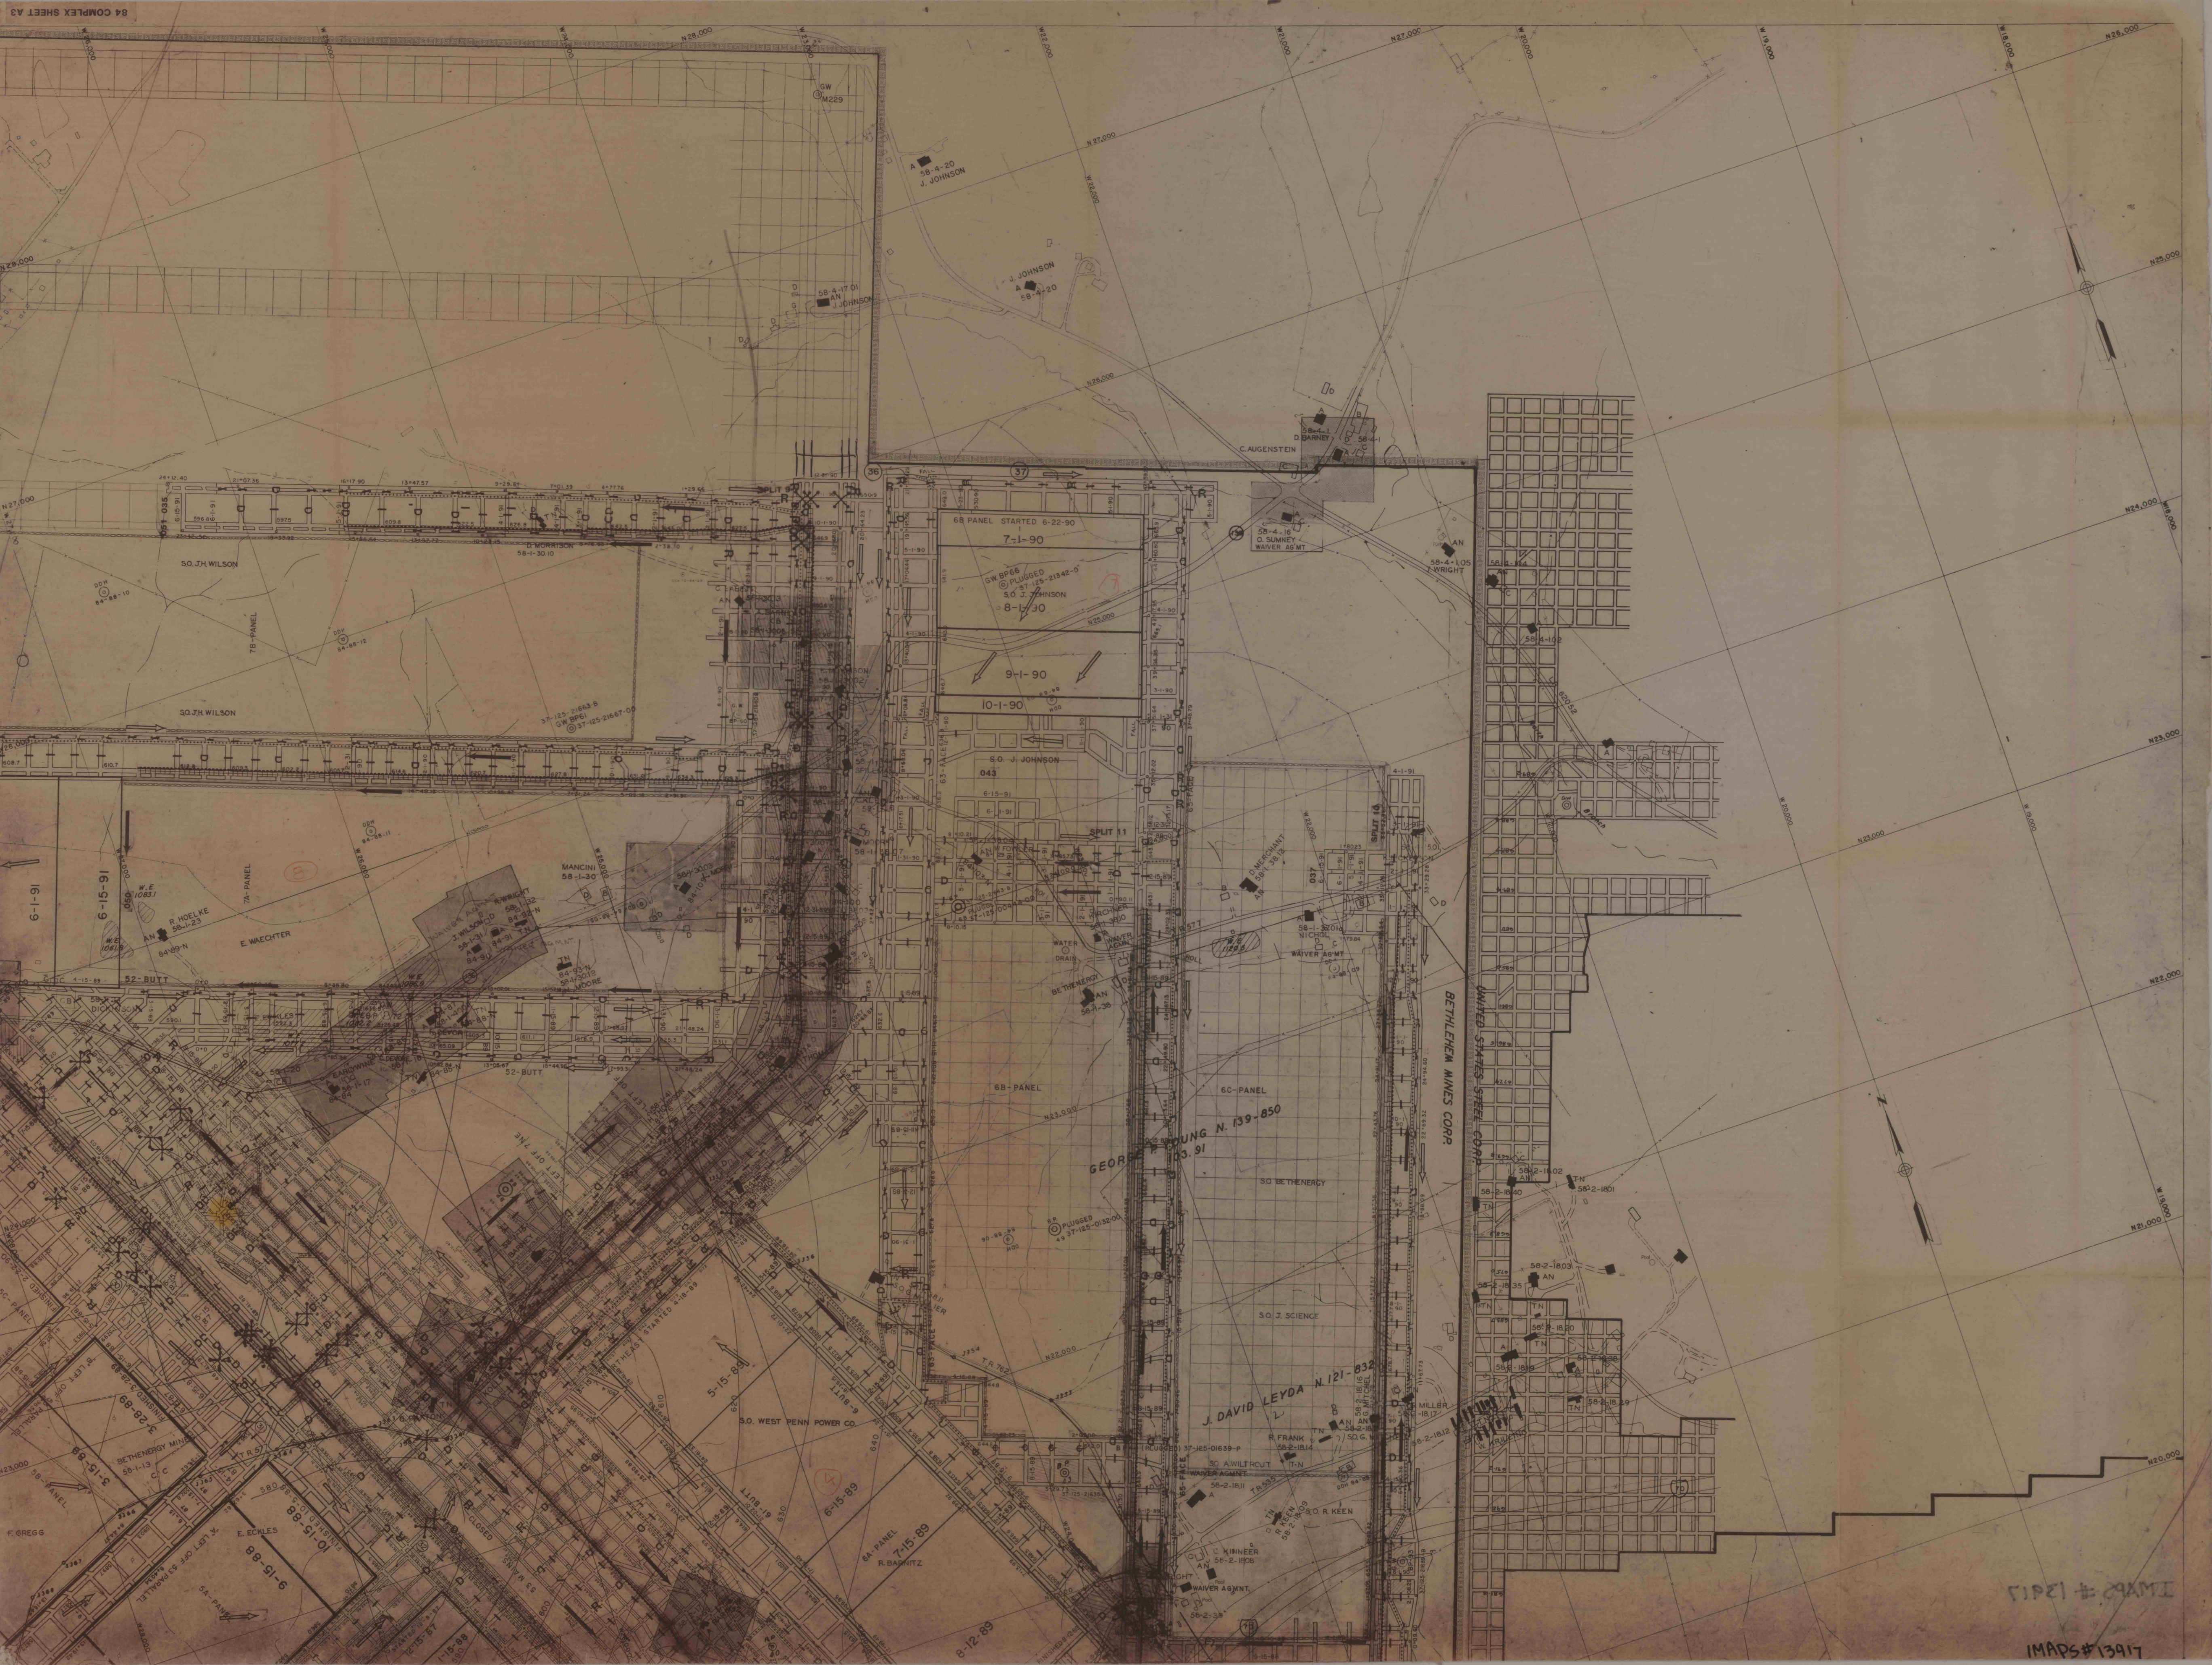


IMAPS#13917