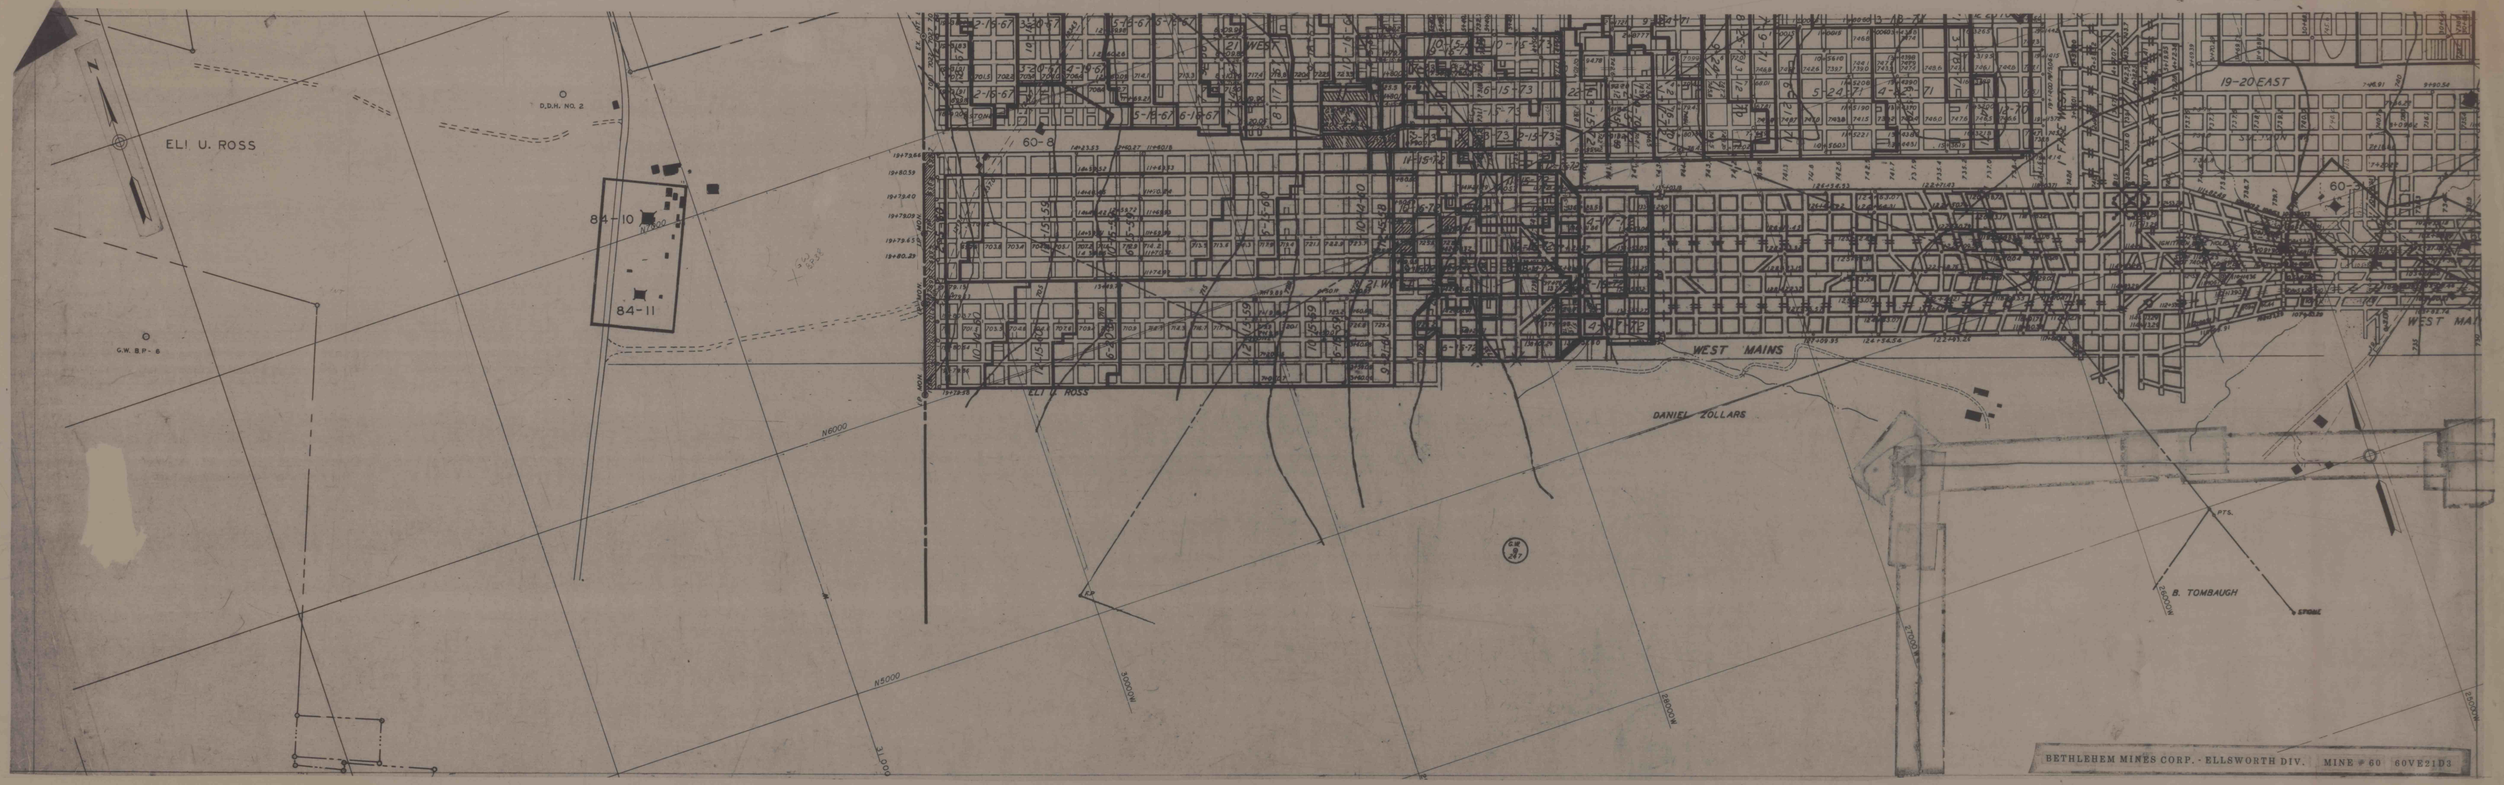
ELI U. ROSS
D.D.H. NO. 2
84-10
84-11
G.W. BP-8
N6000
N5000
WEST MAINS
DANIEL ZOLLARS
19-20 EAST
B. TOMBAUGH
PTS.
BETHLEHEM MINES CORP. - ELLSWORTH DIV.
MINE # 60 60VE21D3

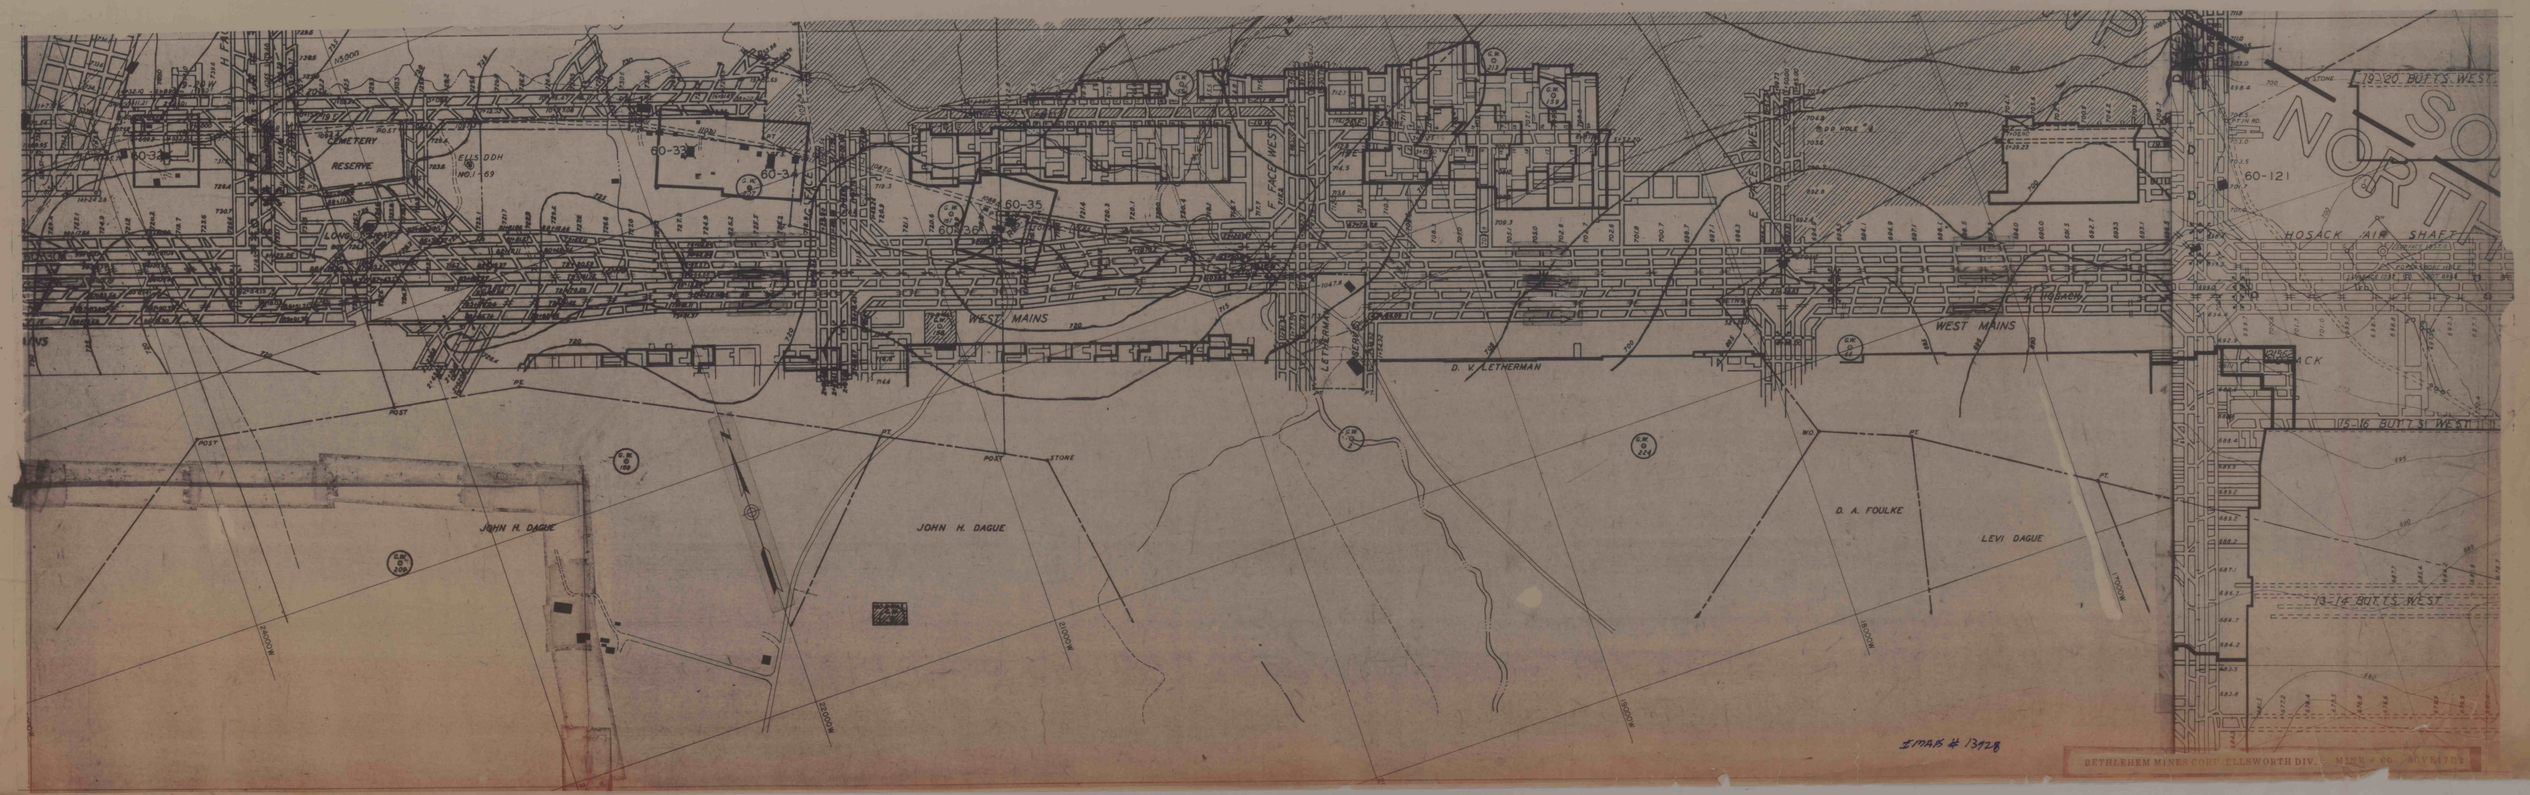
CEMETERY
RESERVE
ELLS DDH NO. 1-69
60-32
60-33
60-34
60-35
60-36
WEST MAINS
F. FACE WEST
D. V. LETHERMAN
D. A. FOULKE
LEVI DAGUE
JOHN H. DAGUE
POST
STONE
19-20 BUTTS WEST
60-121
HOSACK AIR SHAFT
15-16 BUTTS WEST
13-14 BUTTS WEST
NORTH
IMAB # 13128
BETHLEHEM MINES CORP. ELLSWORTH DIV.