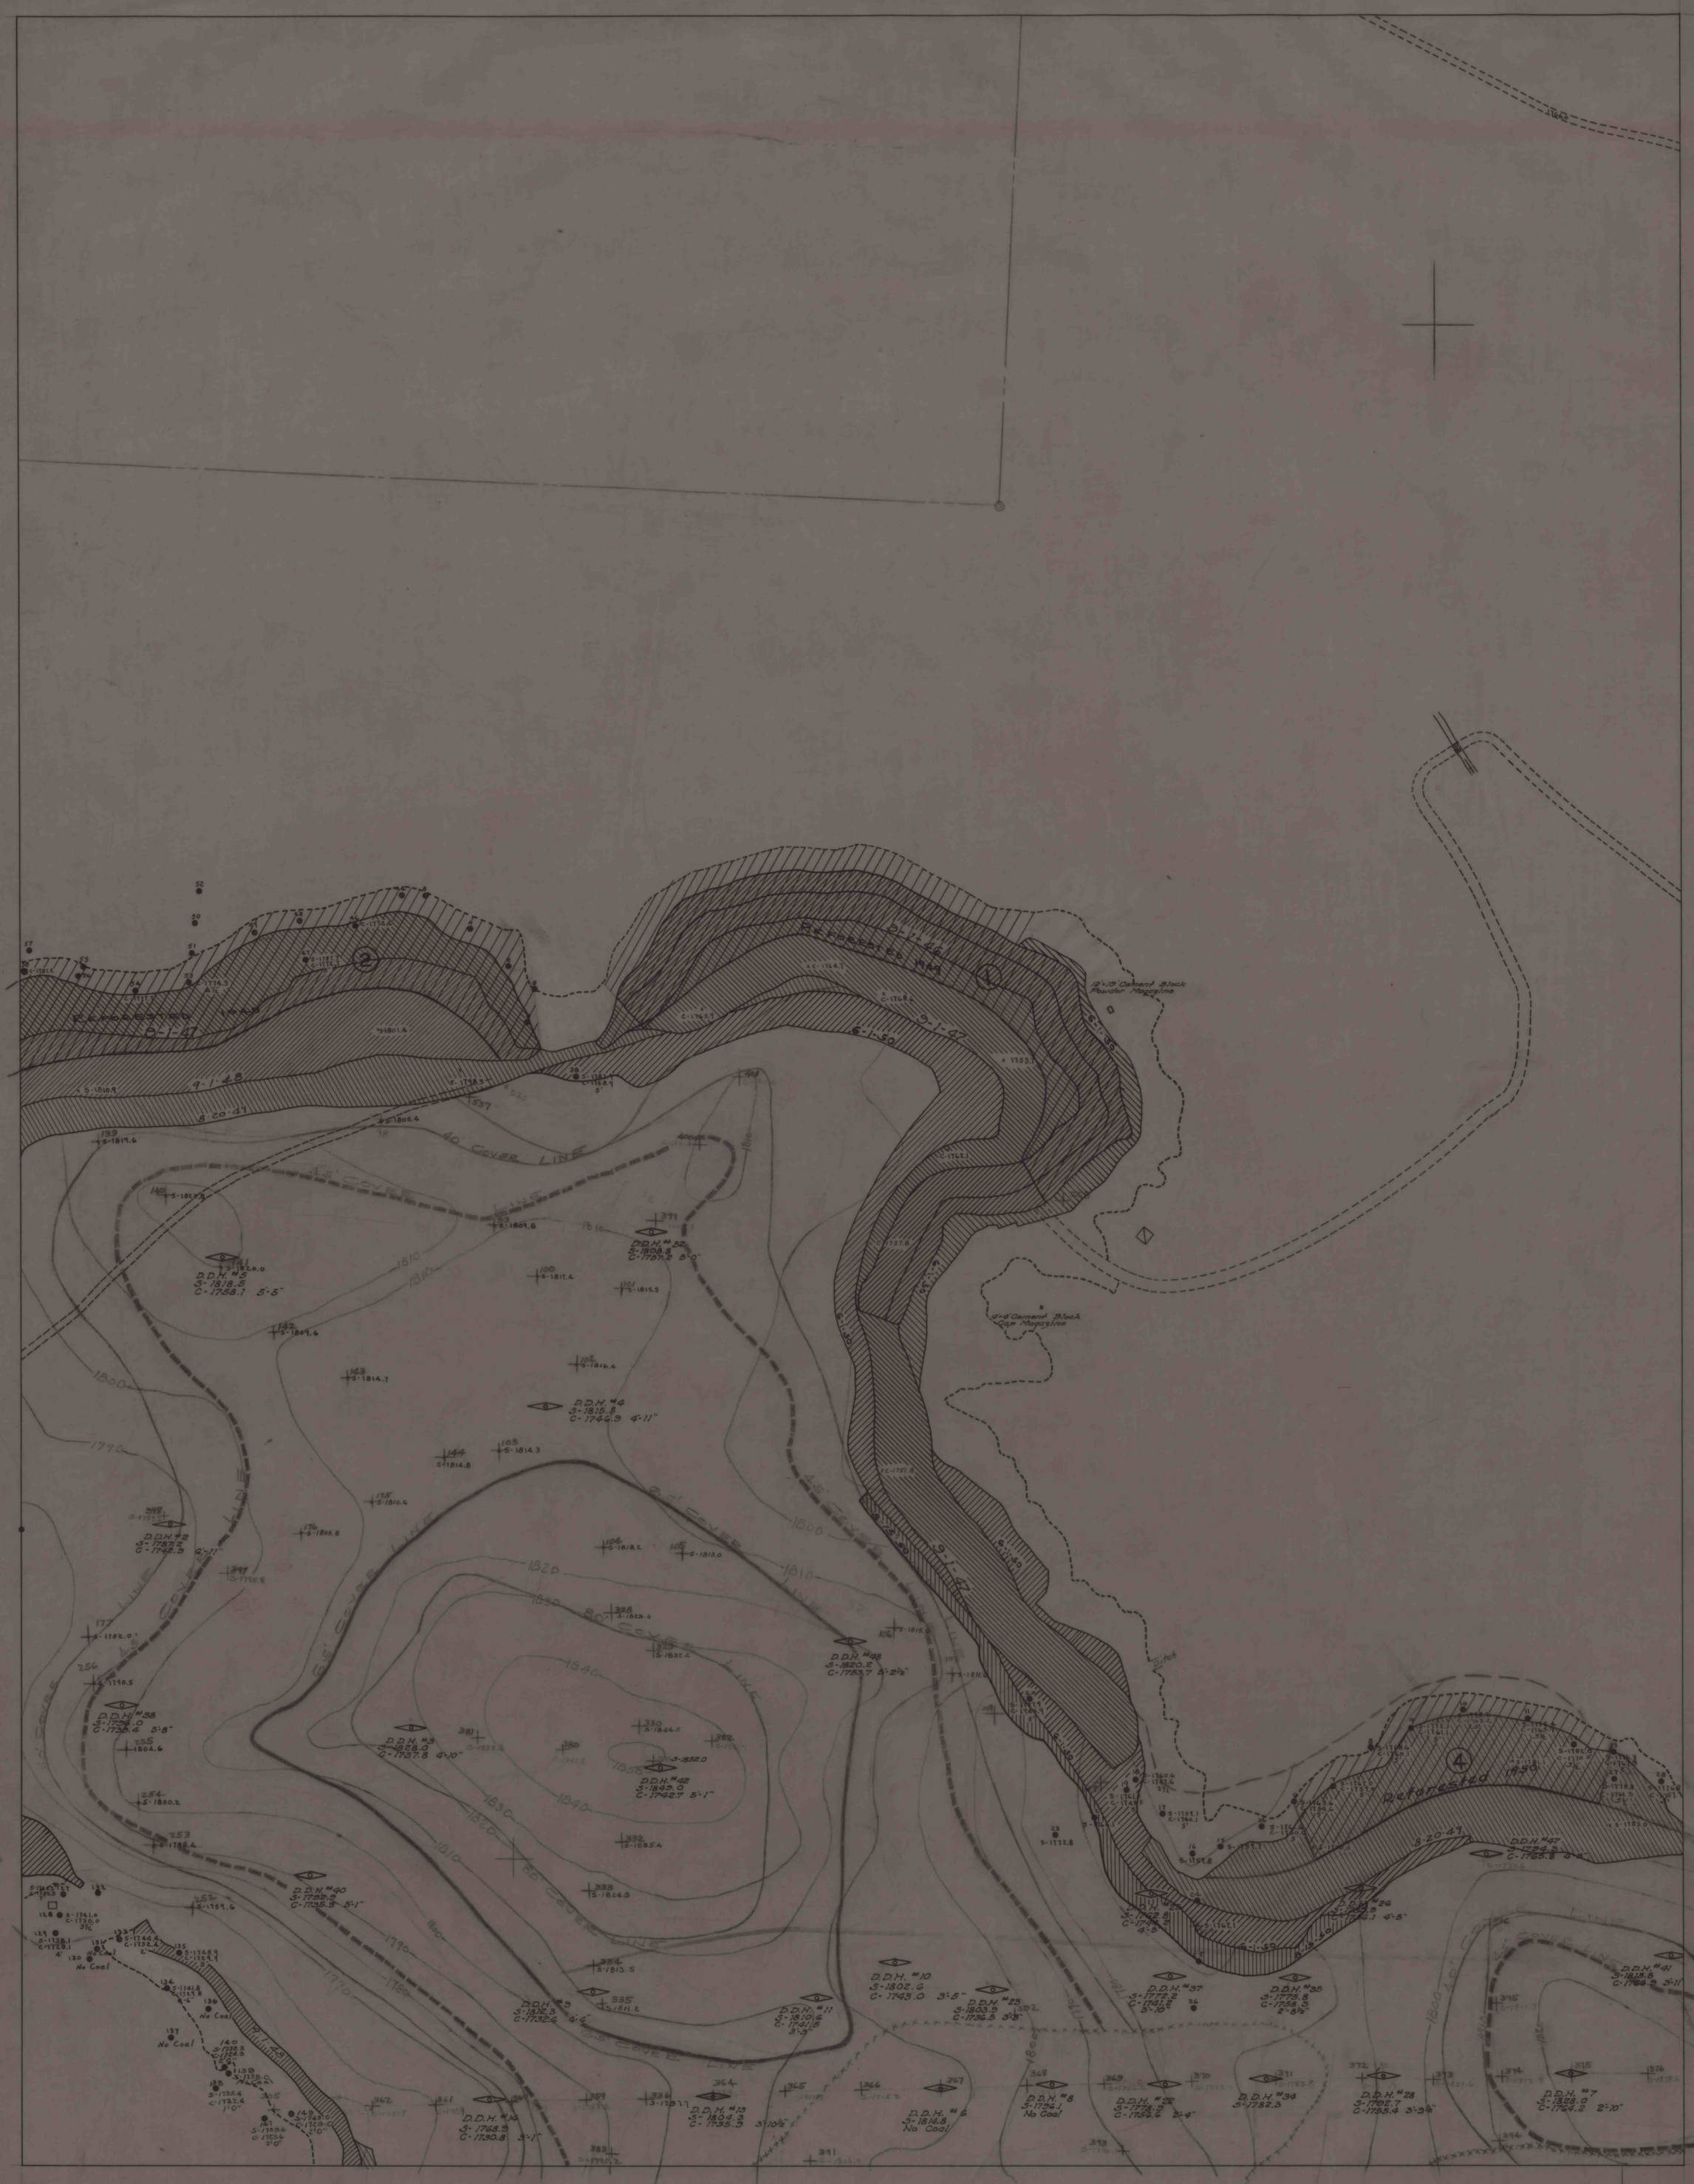
Beech Creek
12'x19' Cement Block Powder Magazine
9'x9' Cement Block Cap Magazine
40' COVER LINE
45' COVER LINE
50' COVER LINE
D.D.H. #5
S-1818.5
C-1758.1 5'-5"
D.D.H. #4
S-1815.5
C-1746.9 4'-11"
D.D.H. #2
S-1782.2
C-1742.3 6'-11"
D.D.H. #38
S-1756.0
C-1736.4 5'-8"
D.D.H. #3
S-1828.0
C-1737.8 4'-10"
D.D.H. #42
S-1843.0
C-1742.7 5'-1"
D.D.H. #40
S-1792.9
C-1735.3 5'-1"
D.D.H. #9
S-1812.3
C-1732.6 4'-4"
D.D.H. #14
S-1768.9
C-1730.8 3'-1"
D.D.H. #13
S-1804.3
C-1735.3 3'-10½"
D.D.H. #11
S-1810.6
C-1741.5 3'-3"
D.D.H. #10
S-1802.6
C-1743.0 3'-5"
D.D.H. #23
S-1803.9
C-1736.5 3'-8"
D.D.H. #6
S-1814.8
No Coal
D.D.H. #8
S-1796.1
No Coal
D.D.H. #48
S-1820.2
C-1753.7 5'-2½"
D.D.H. #52
S-1808.8
C-1752.2 5'-0"
D.D.H. #47
S-1794.3
C-1765.8 2'-8"
D.D.H. #26
S-1762.5
C-1744.1 4'-5"
D.D.H. #37
S-1772.2
C-1741.2
3'-10"
D.D.H. #35
S-1775.8
C-1758.3
2'-6½"
D.D.H. #34
S-1782.3
D.D.H. #28
S-1792.7
C-1735.4 3'-9½"
D.D.H. #41
S-1818.8
C-1764.9 3'-11"
D.D.H. #7
S-1828.0
C-1764.2 2'-10"
No Coal
Ditch
DWG - 70
