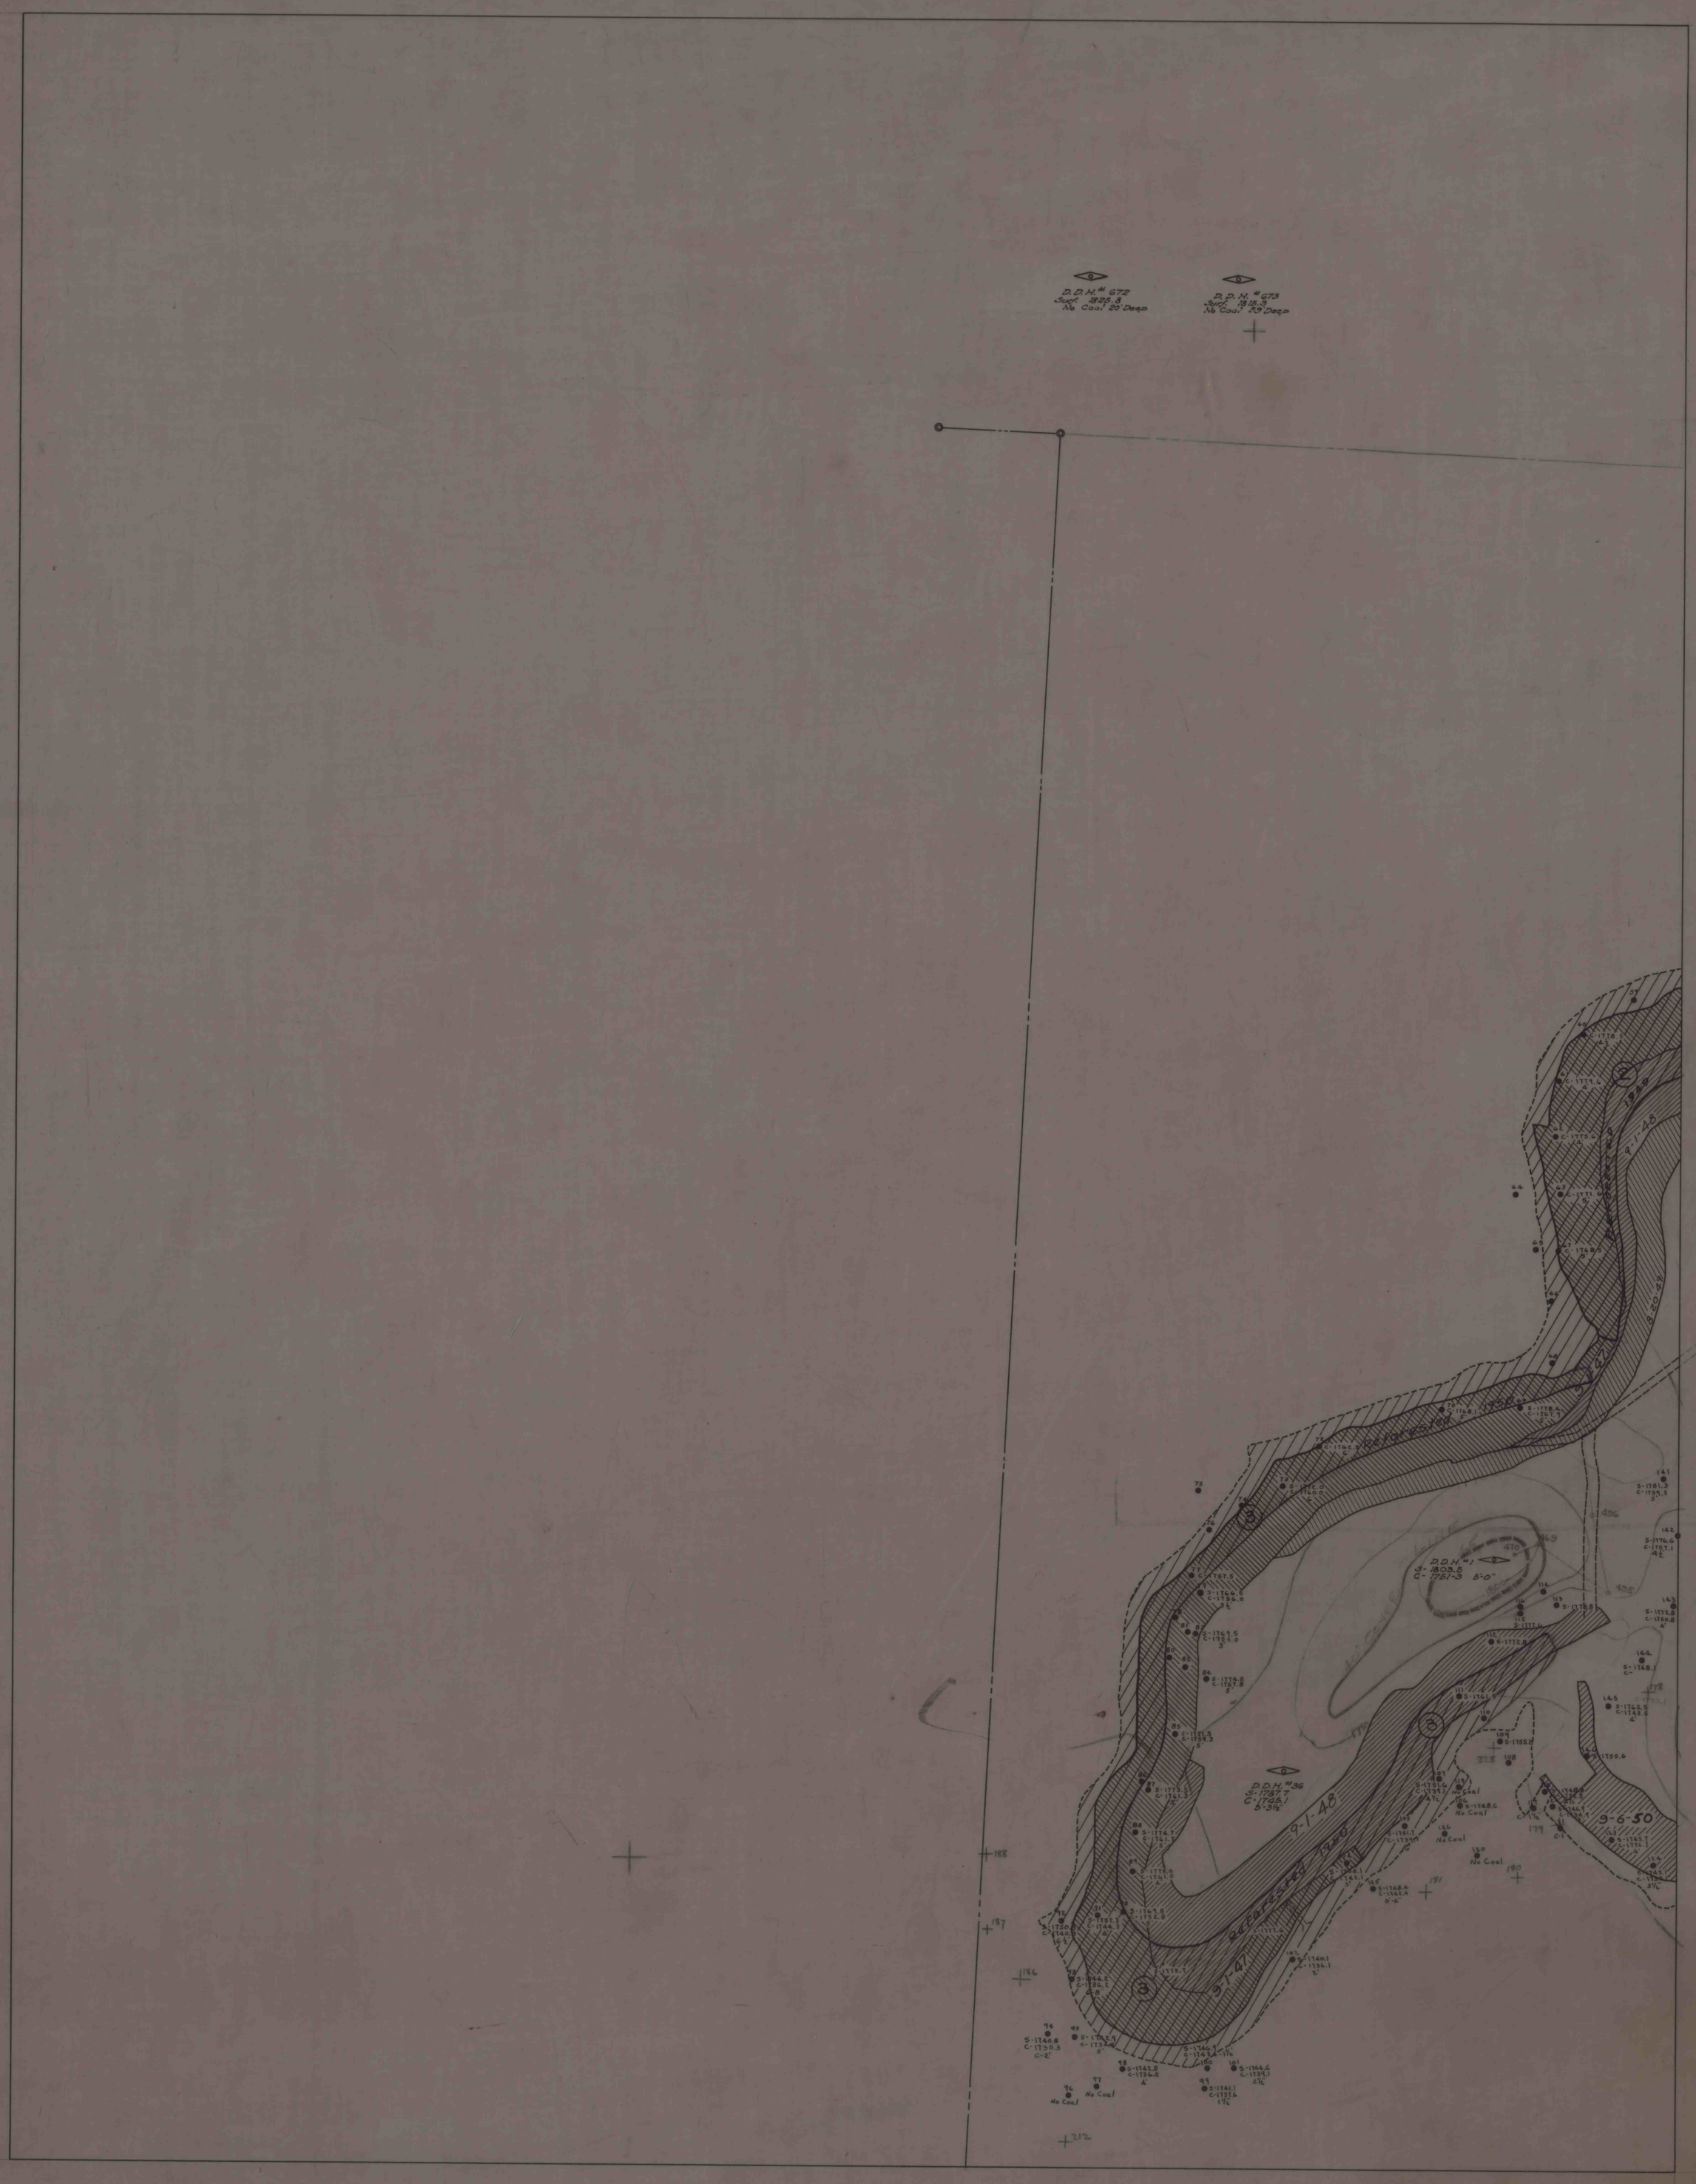
D.D.H. # 672
Surf. 1825.8
No Coal 20' Deep
D.D.H. # 673
Surf. 1815.3
No Coal 29' Deep
Beech Creek
9-1-48
9-20-49
9-6-50
Reforested 1940
D.D.H. #1
S-1803.5
C-1751.3 5'-0"
D.D.H. #36
S-1787.7
C-1795.1
5'-3½"
No Coal

IMAPS # 13937