


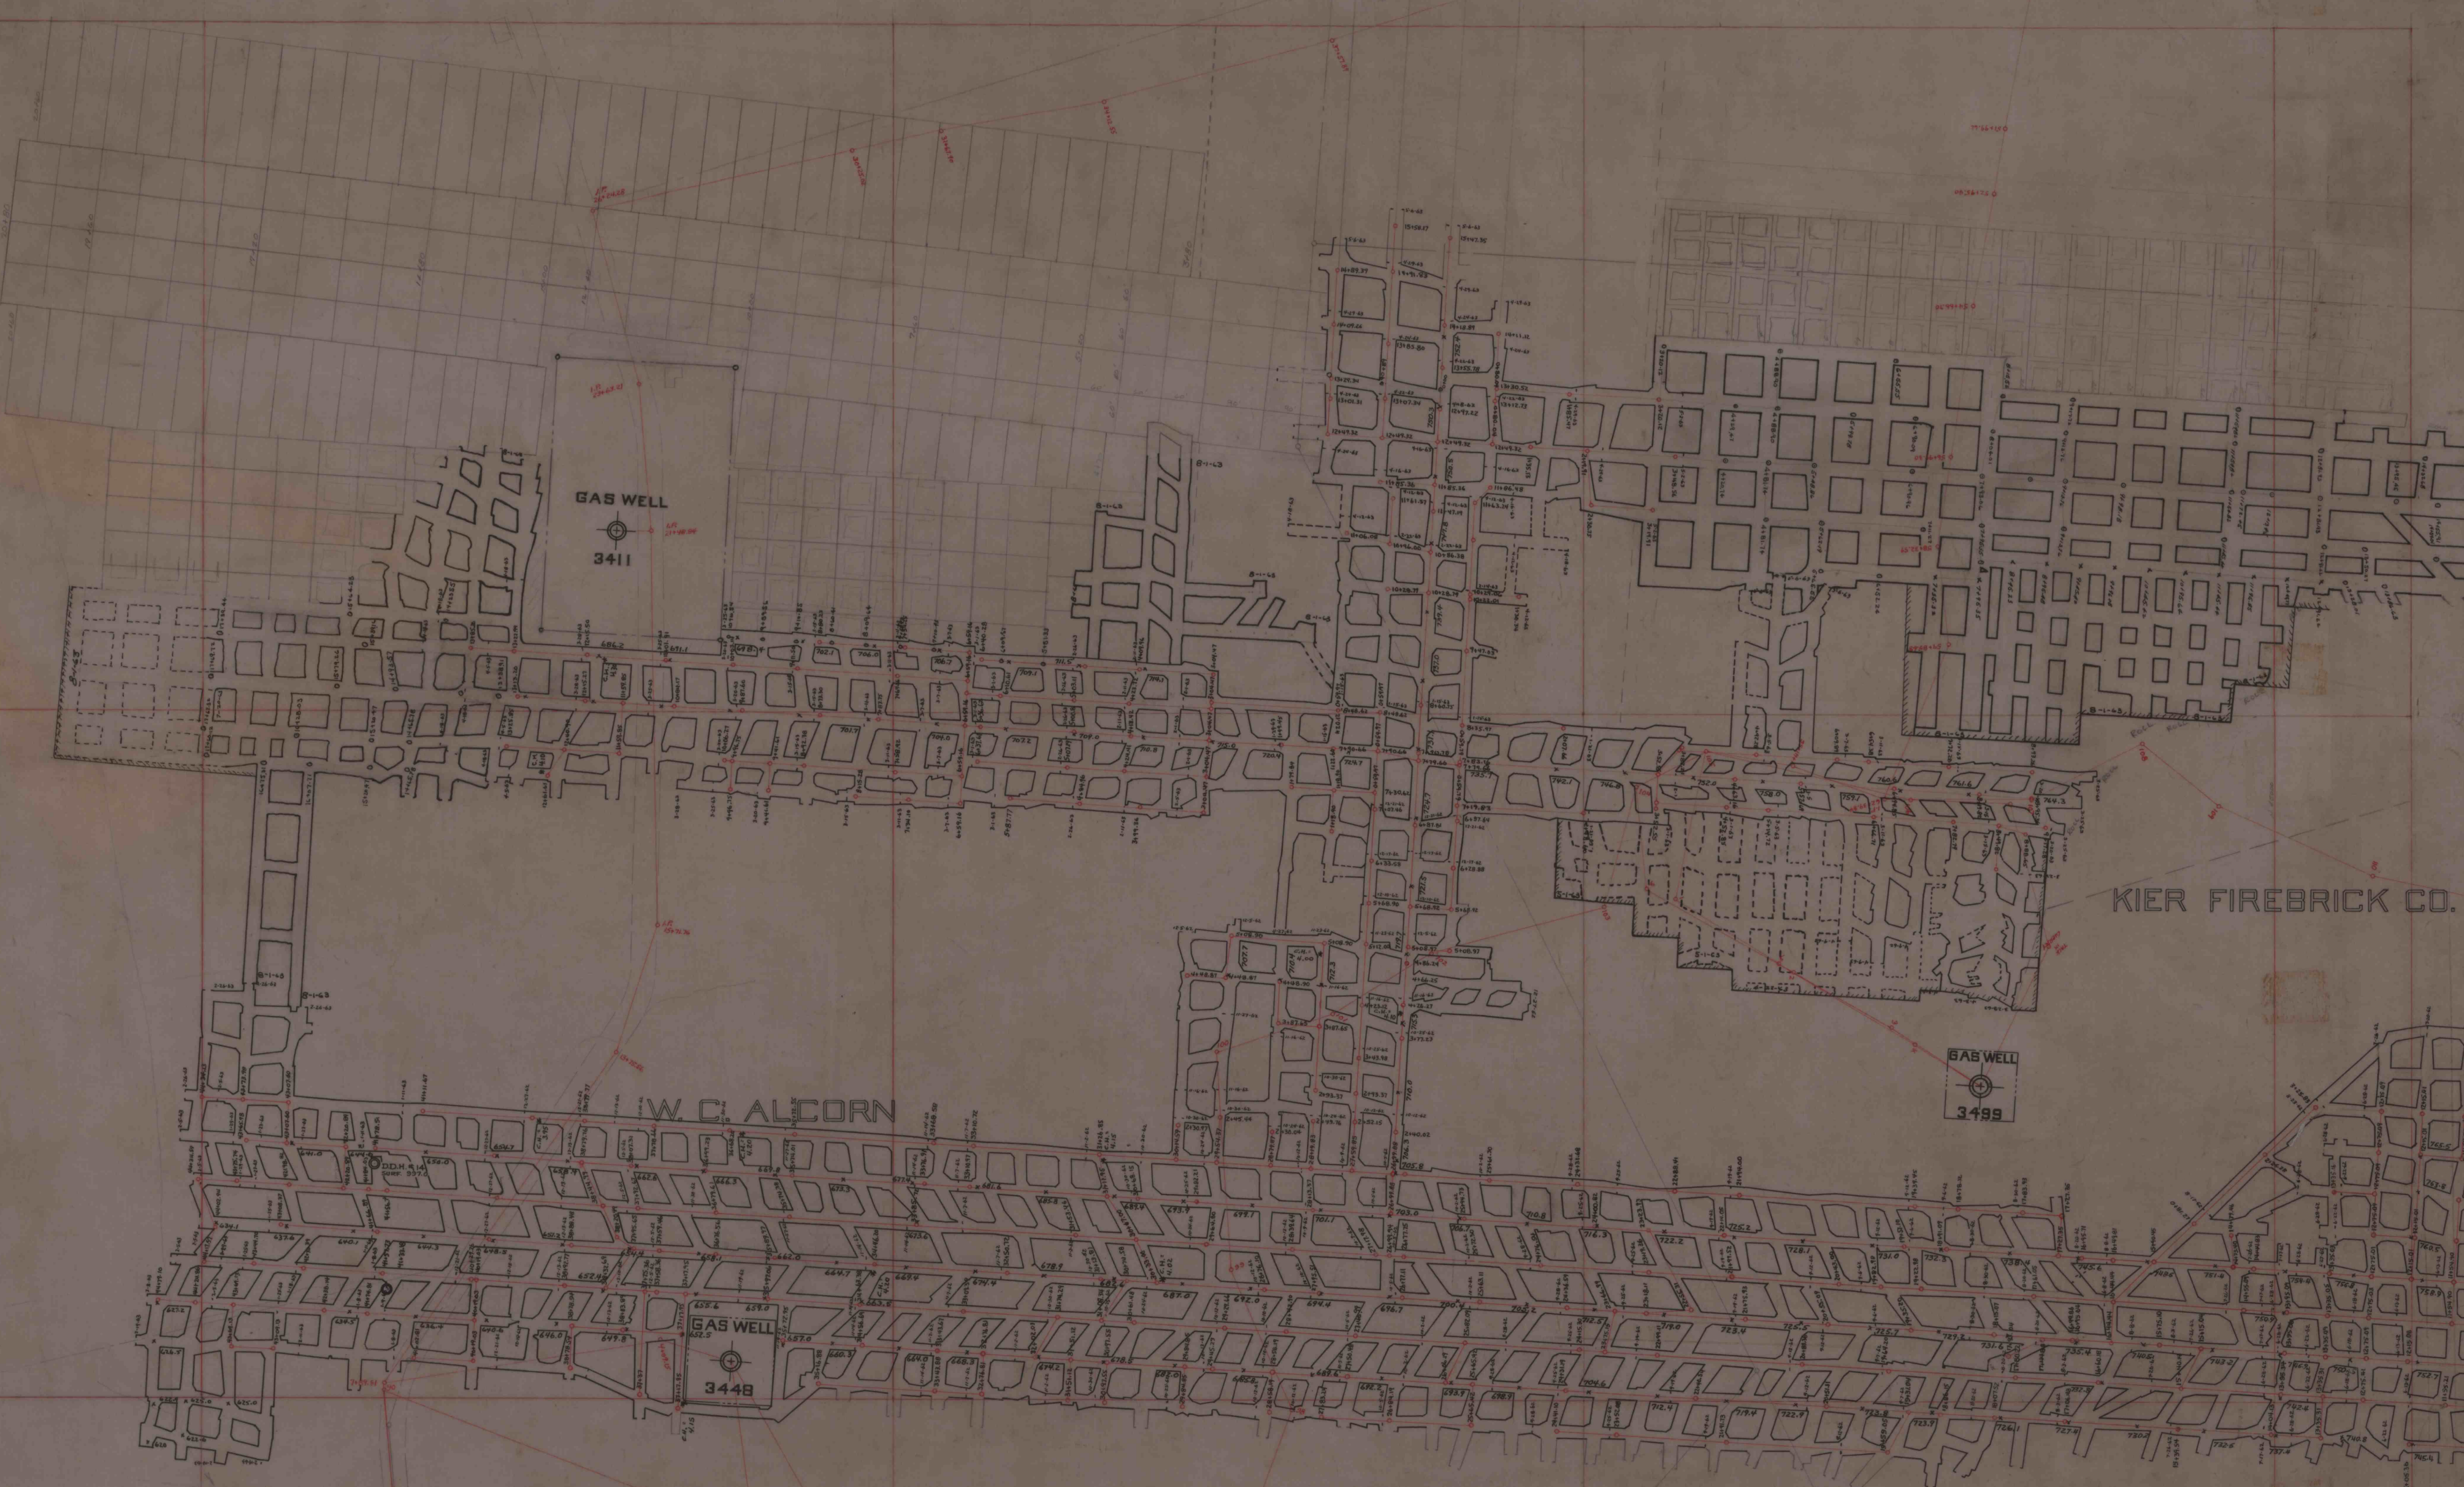

GAS WELL
3411

GAS WELL
3499

GAS WELL
3448

W. C. ALCORN

KIER FIREBRICK CO.

J.M. YOCKEY

KIER'S D.D.H. #201
SURF. 275.7
B.C. 445.5


U.M. LEARN

IMAPS # 13942