


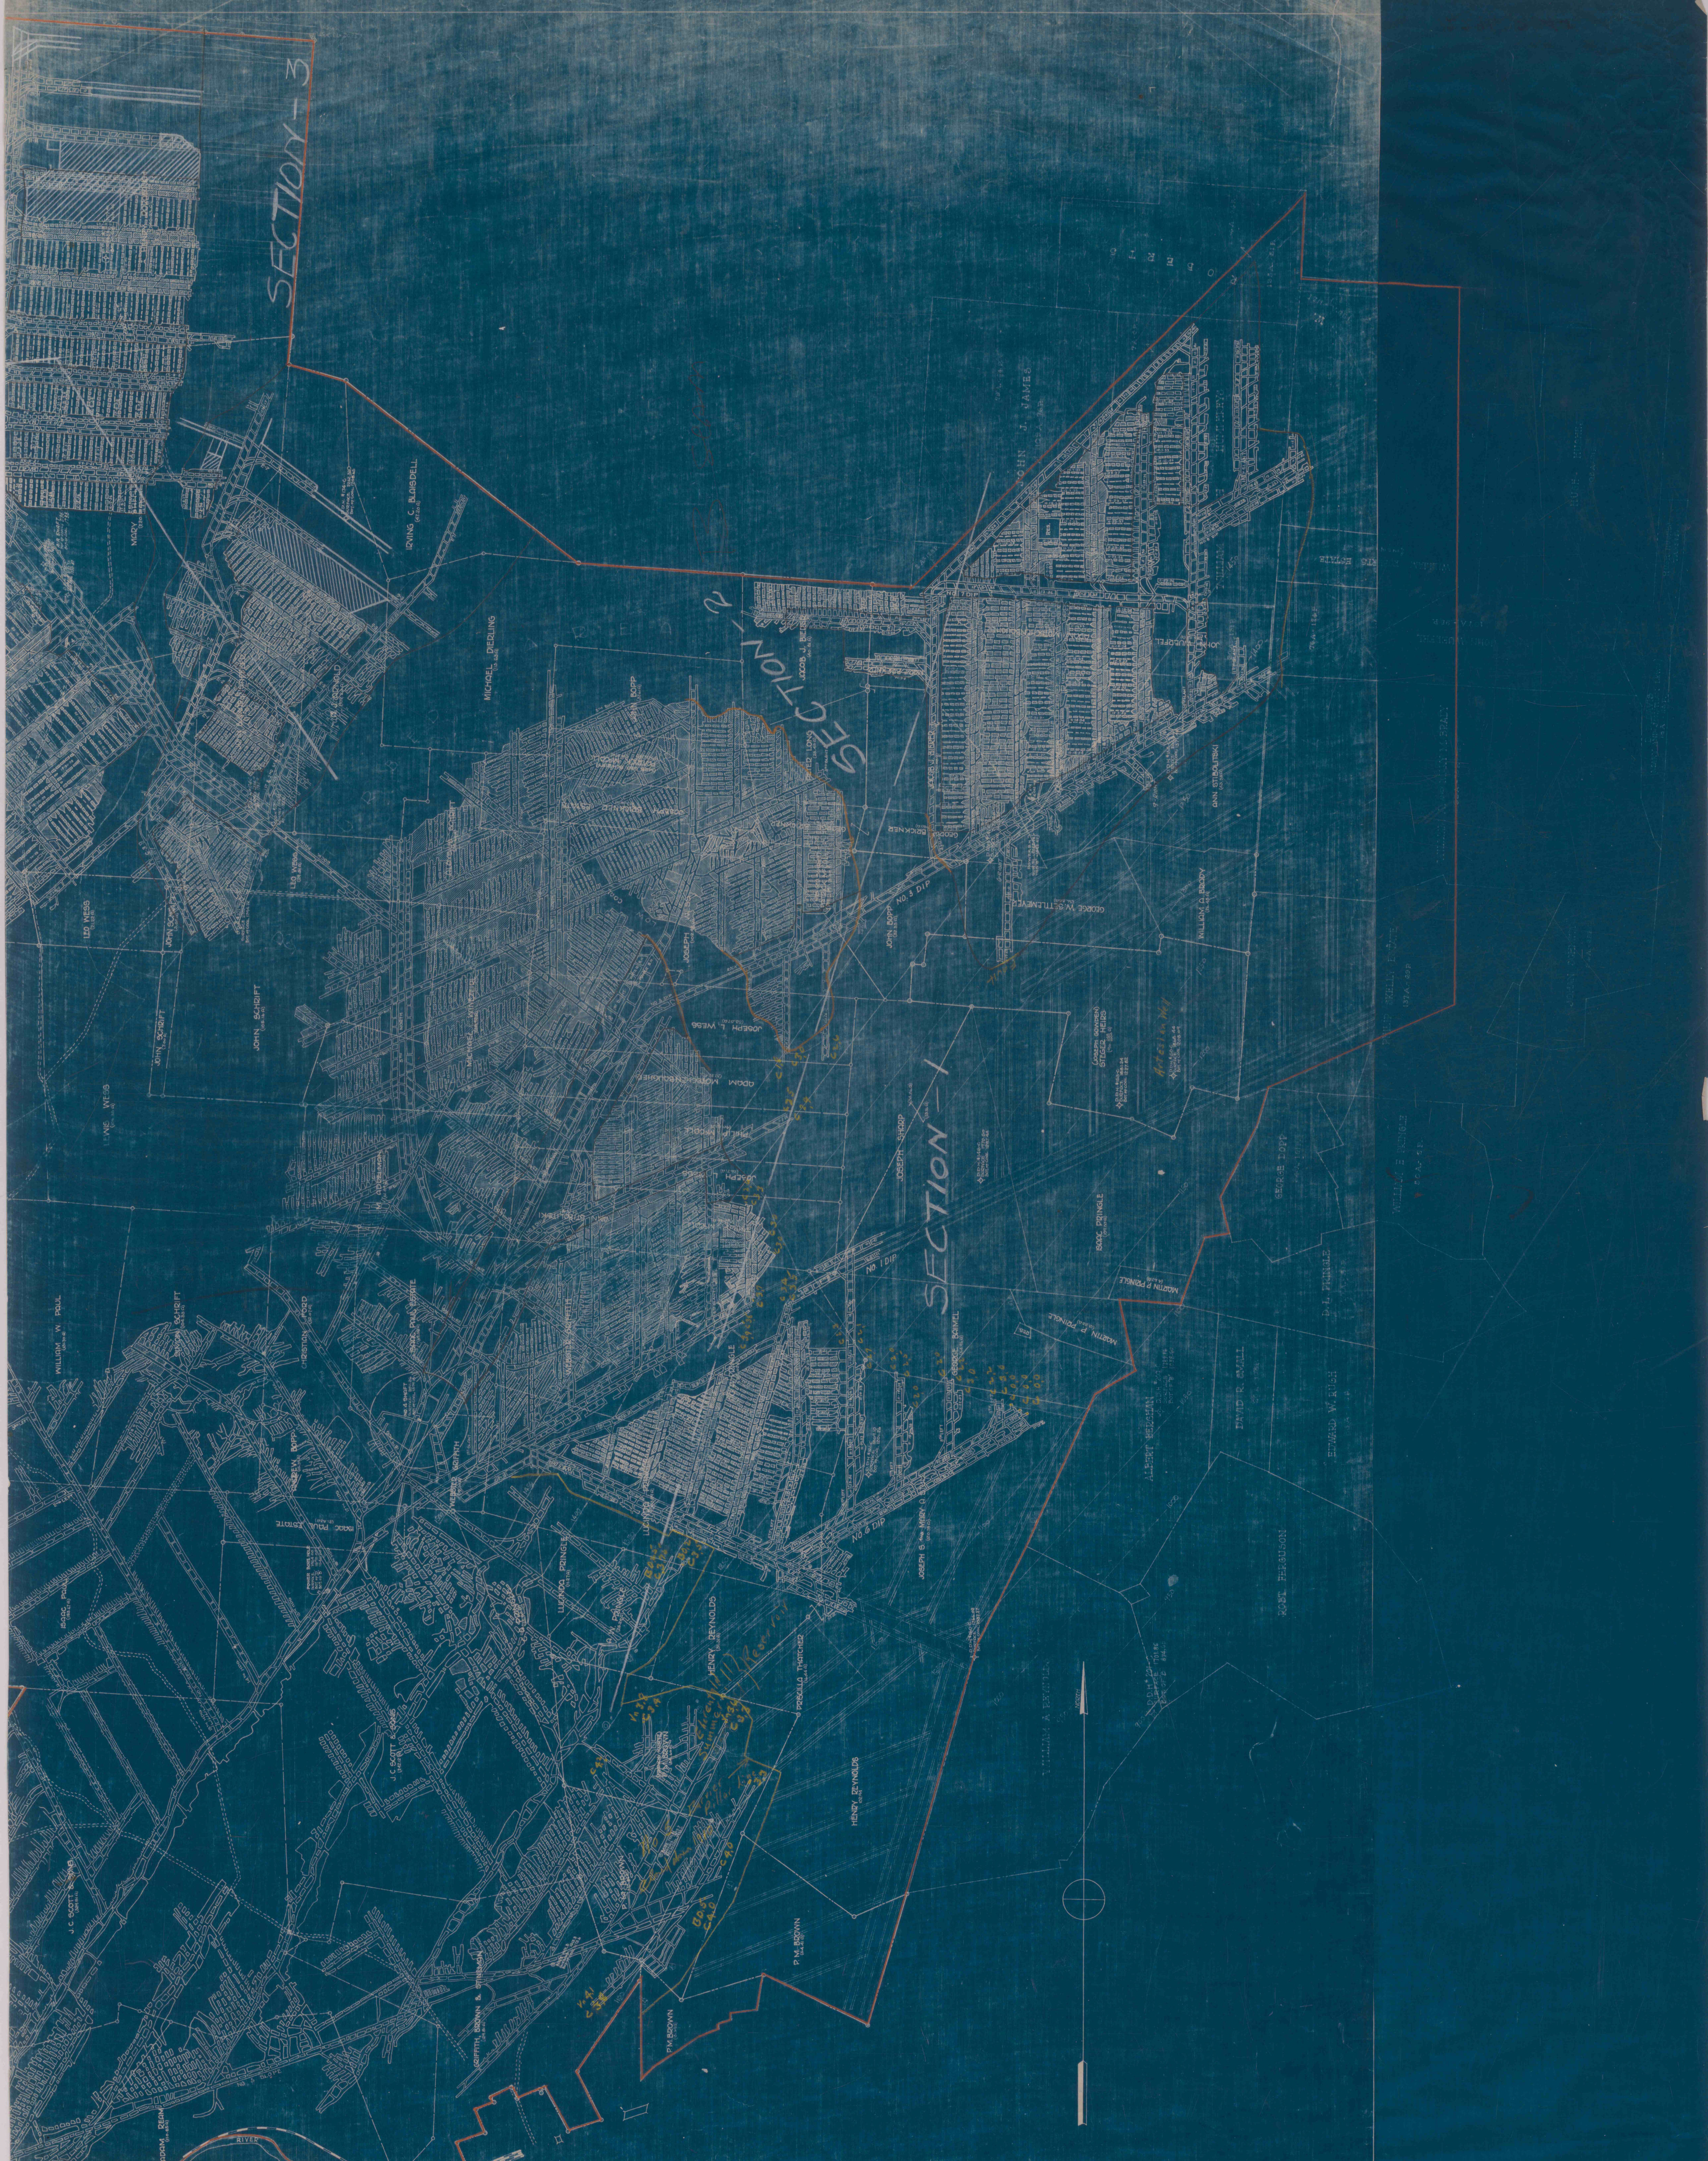

PENNSYLVANIA COAL AND COKE CORPORATION
EHRENFELD No 3 COLLIERY
CRESSON, CAMBRIA CO., PENNSYLVANIA

SCALE 1"=400'