


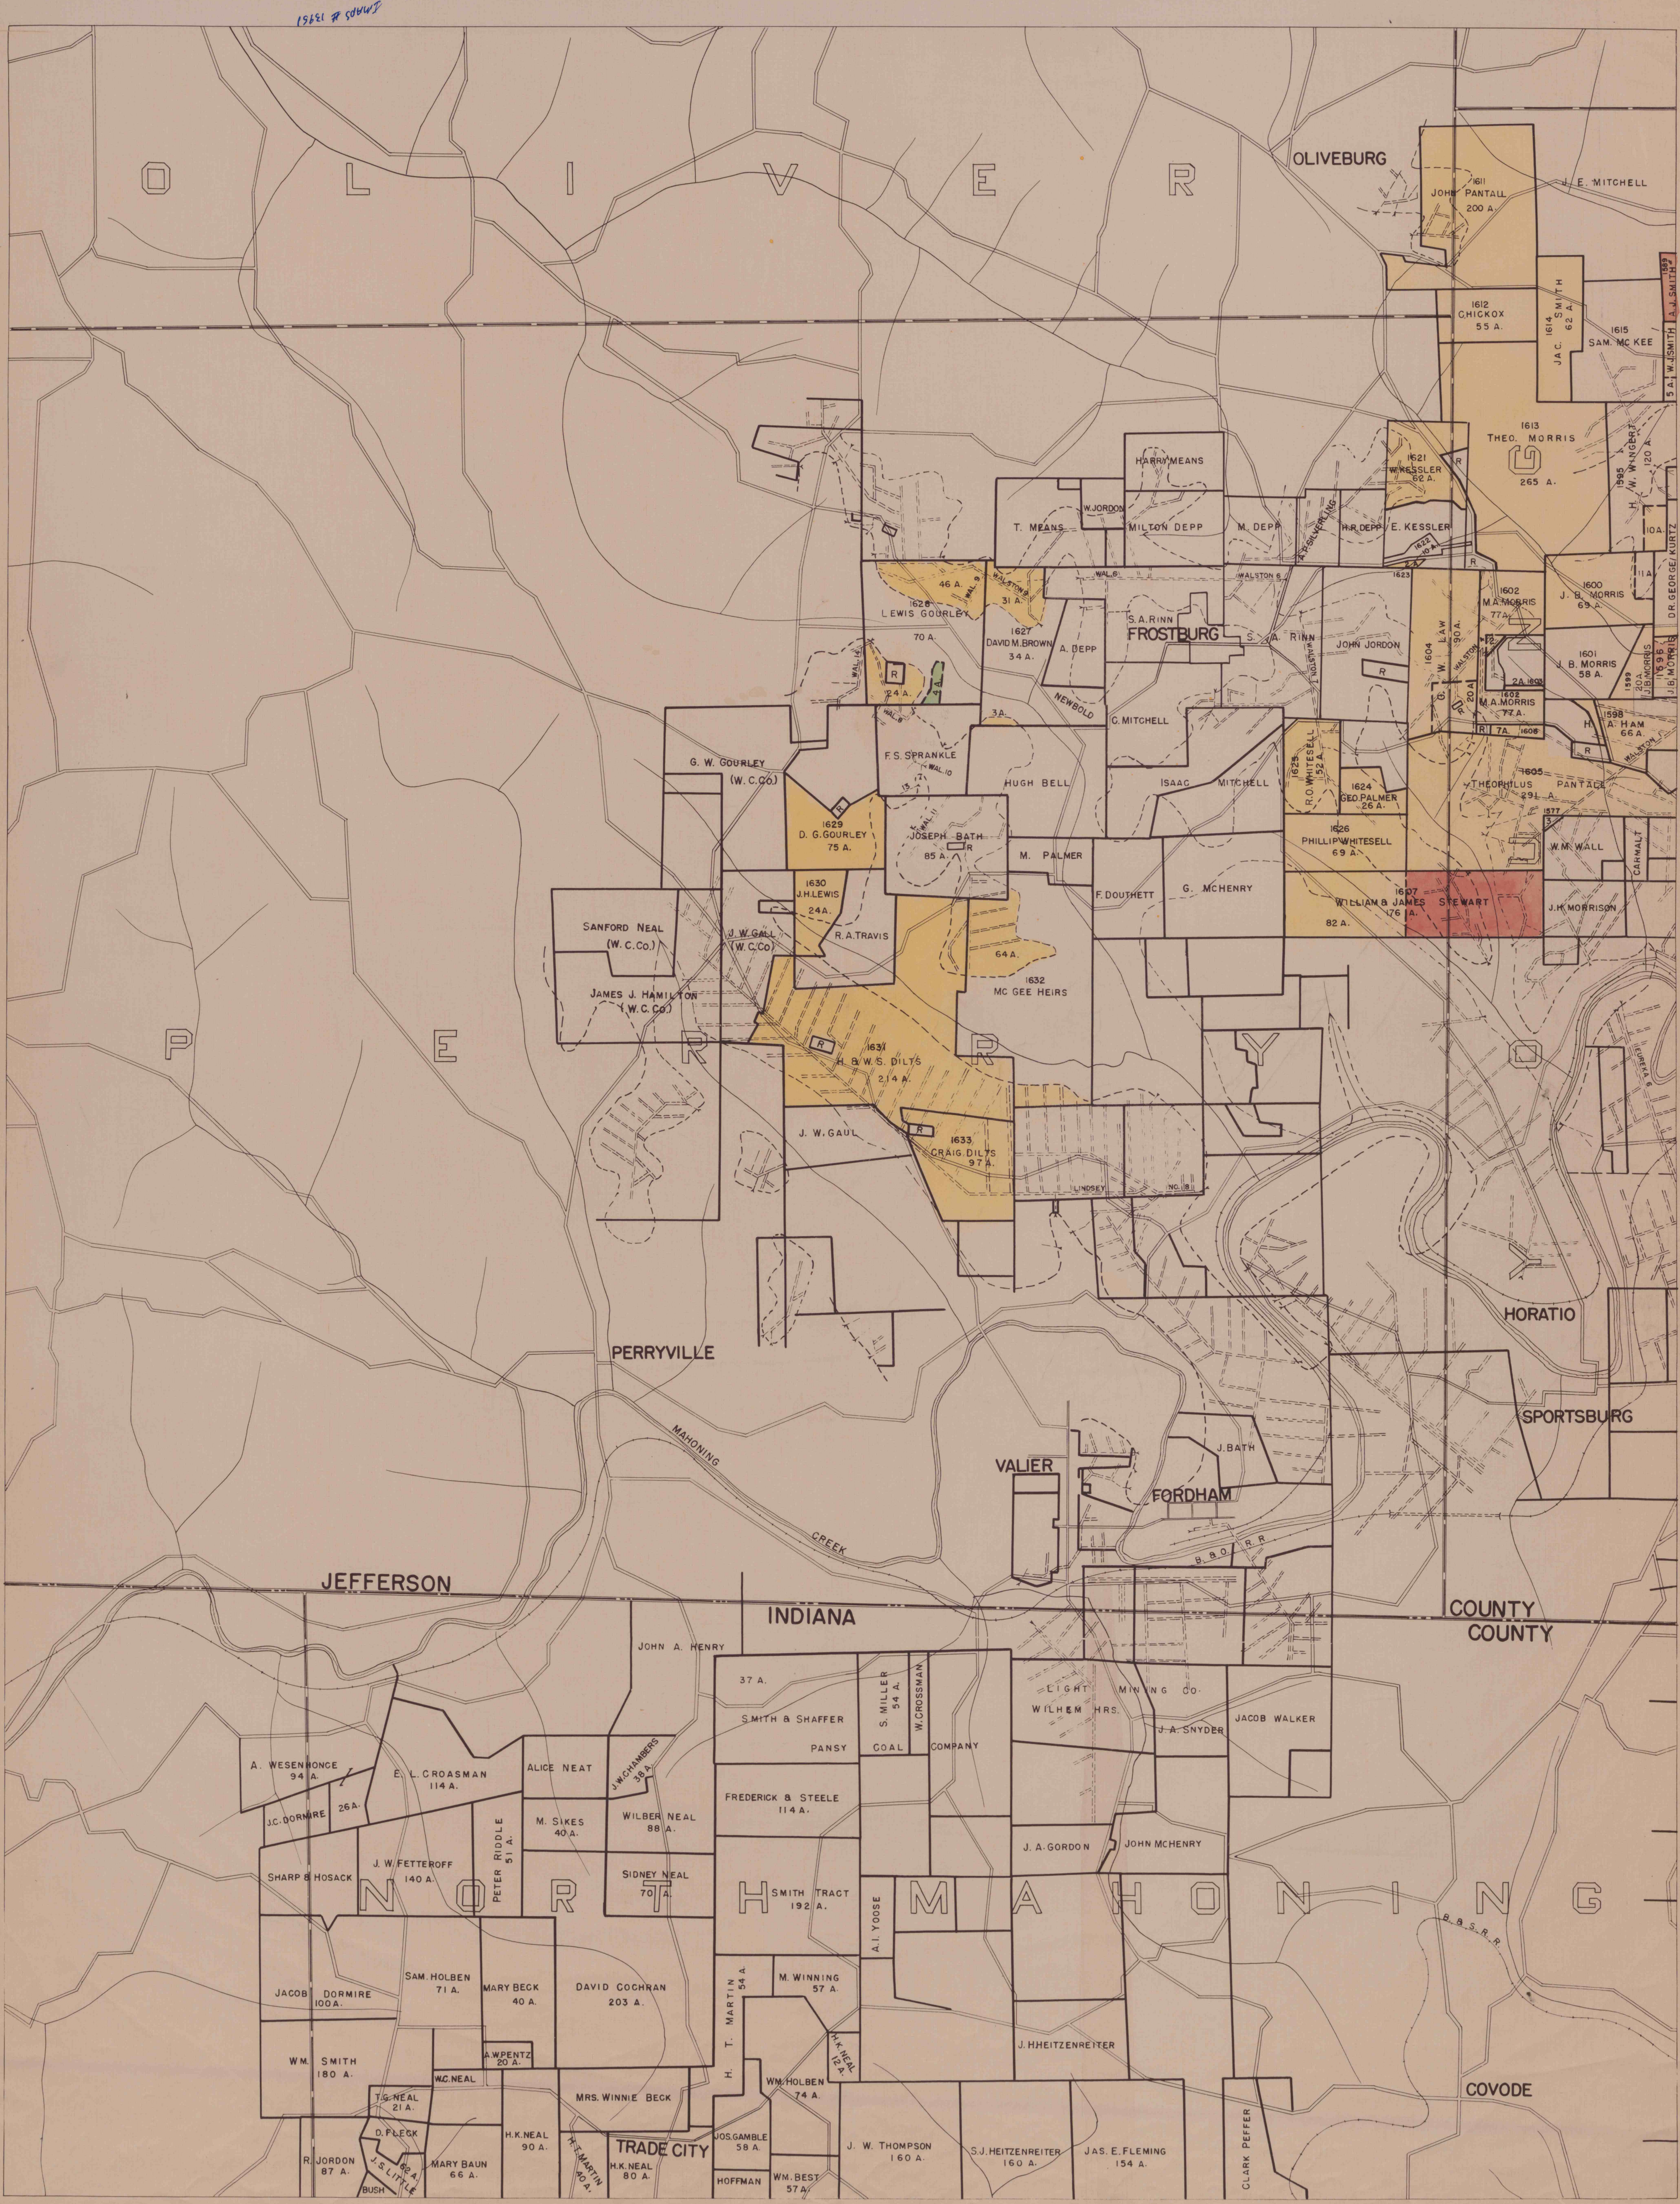

SMICKSBURG QUADRANGLE (UPPER RIGHT) "D" SEAM

JMAPS # 13951

SMICKSBURG QUADRANGLE (UPPER RIGHT) "D" SEAM