


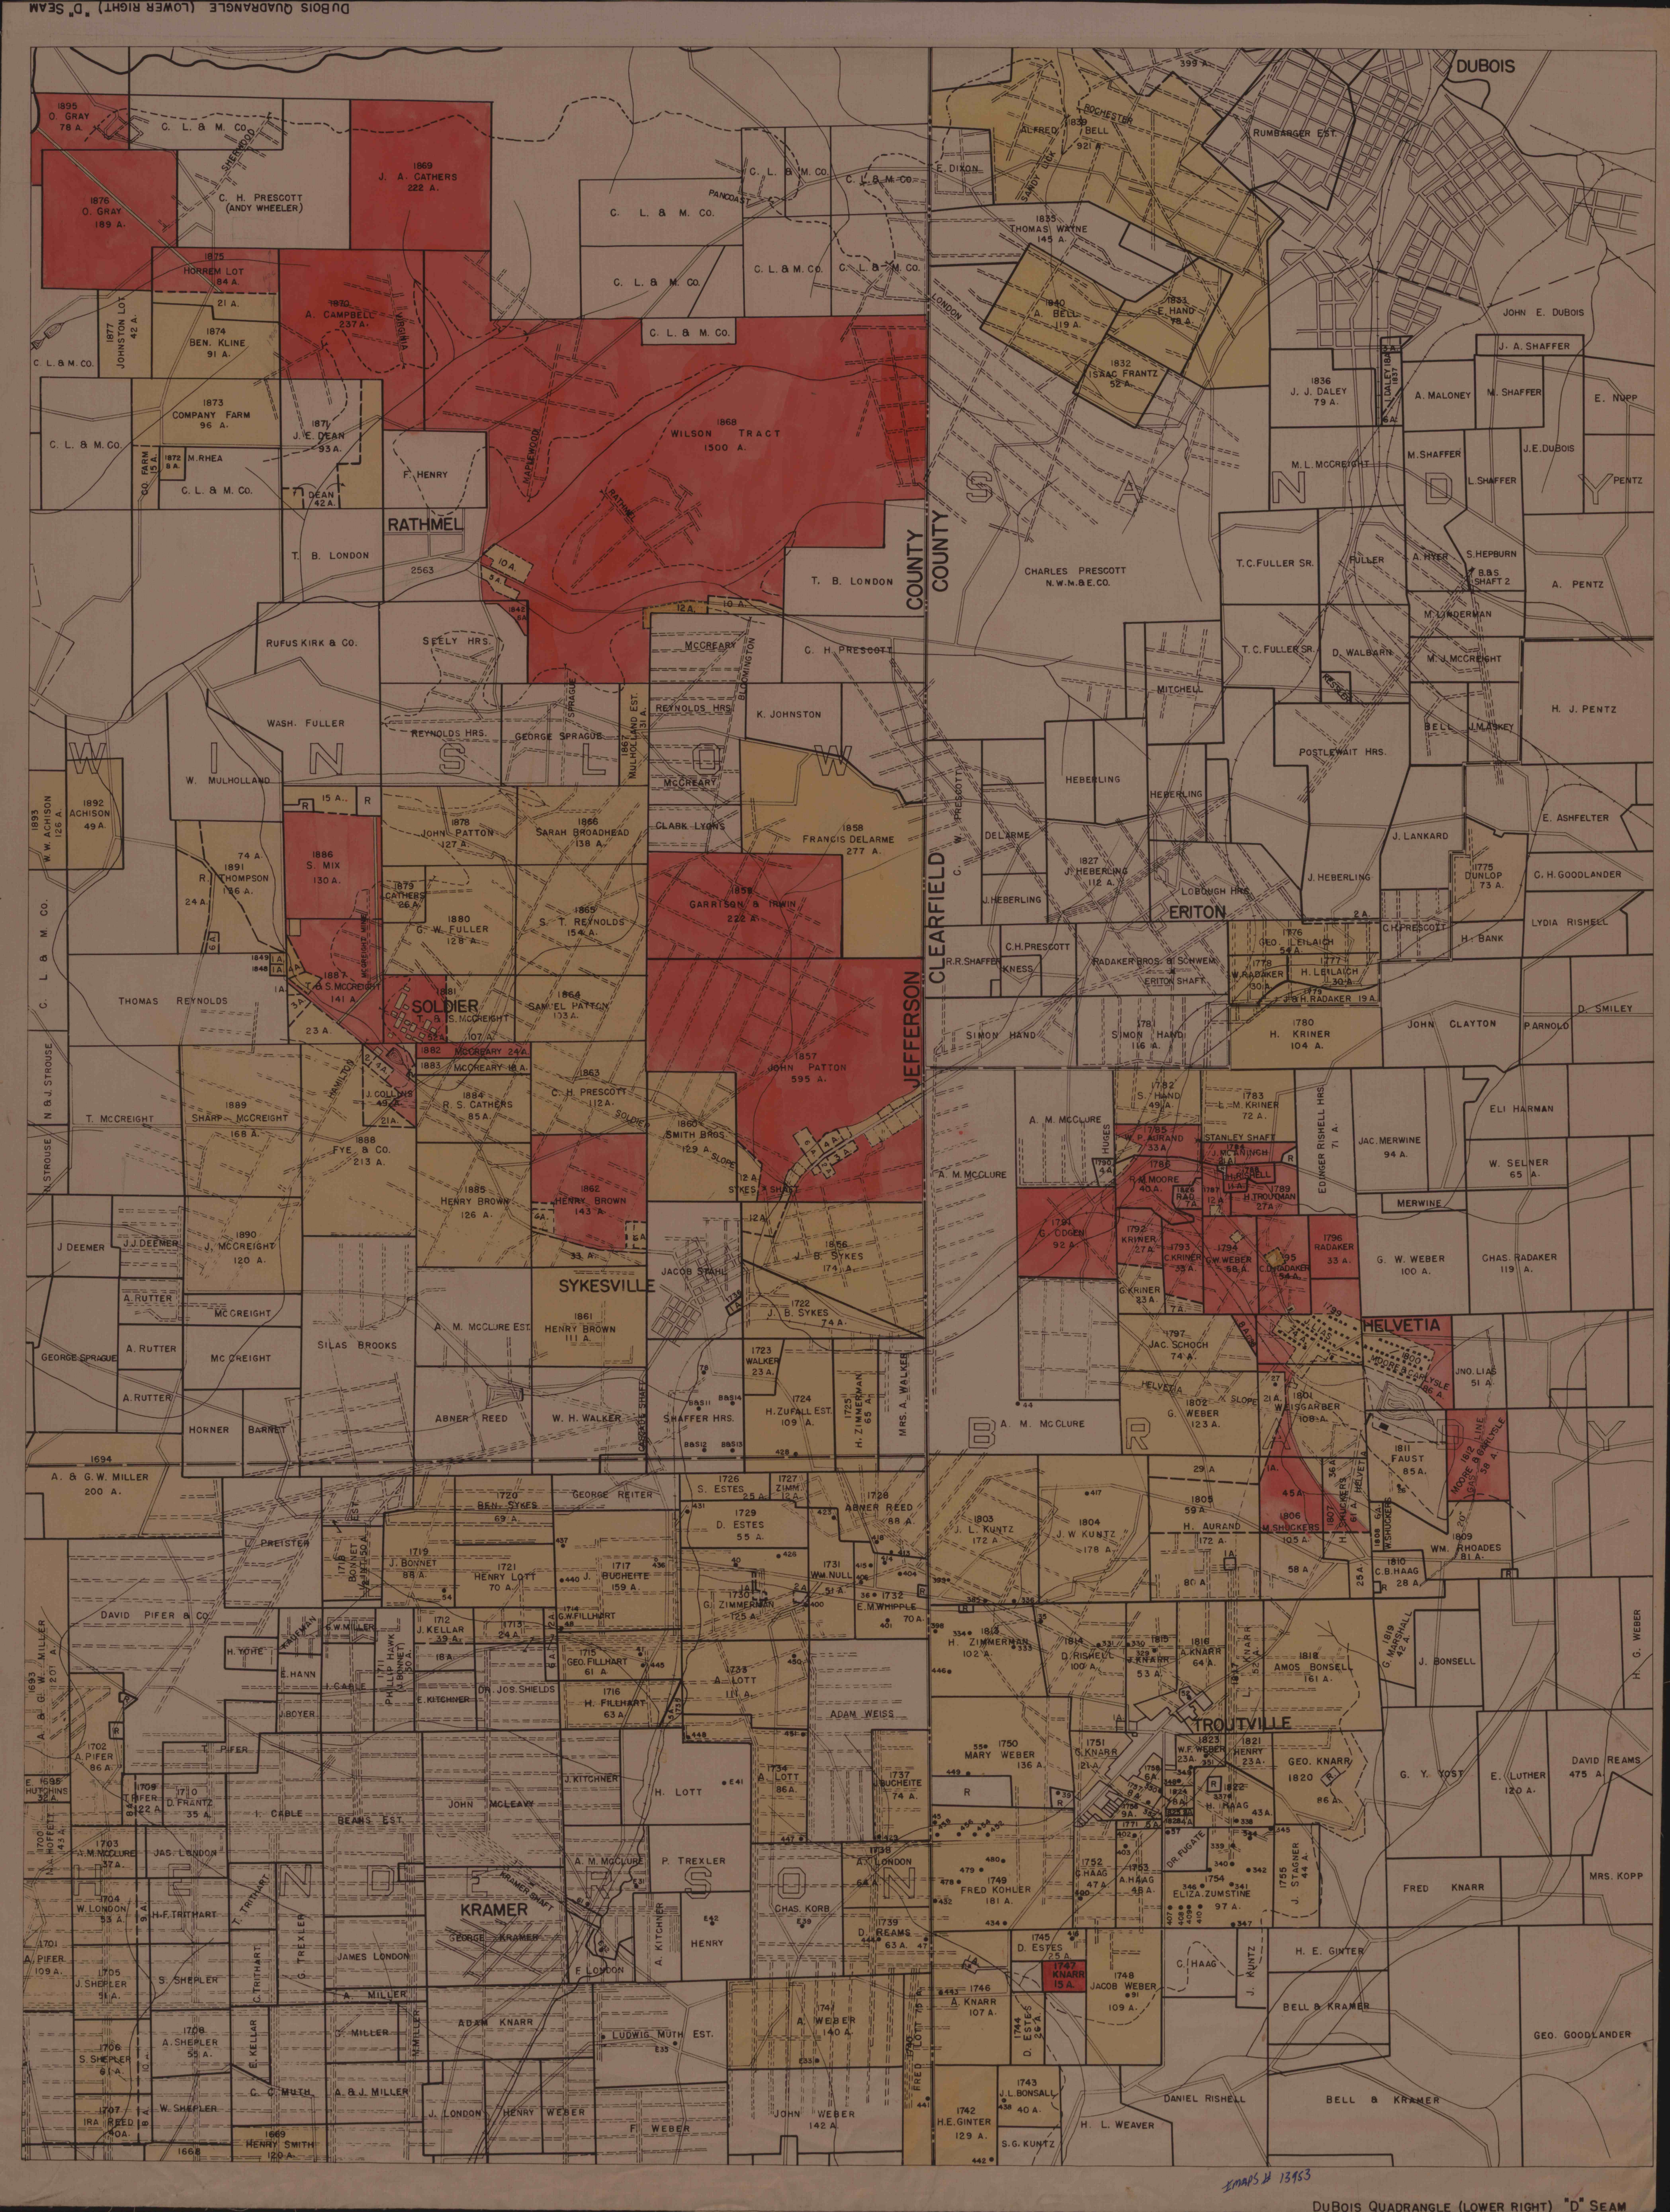

MAPS 13953