


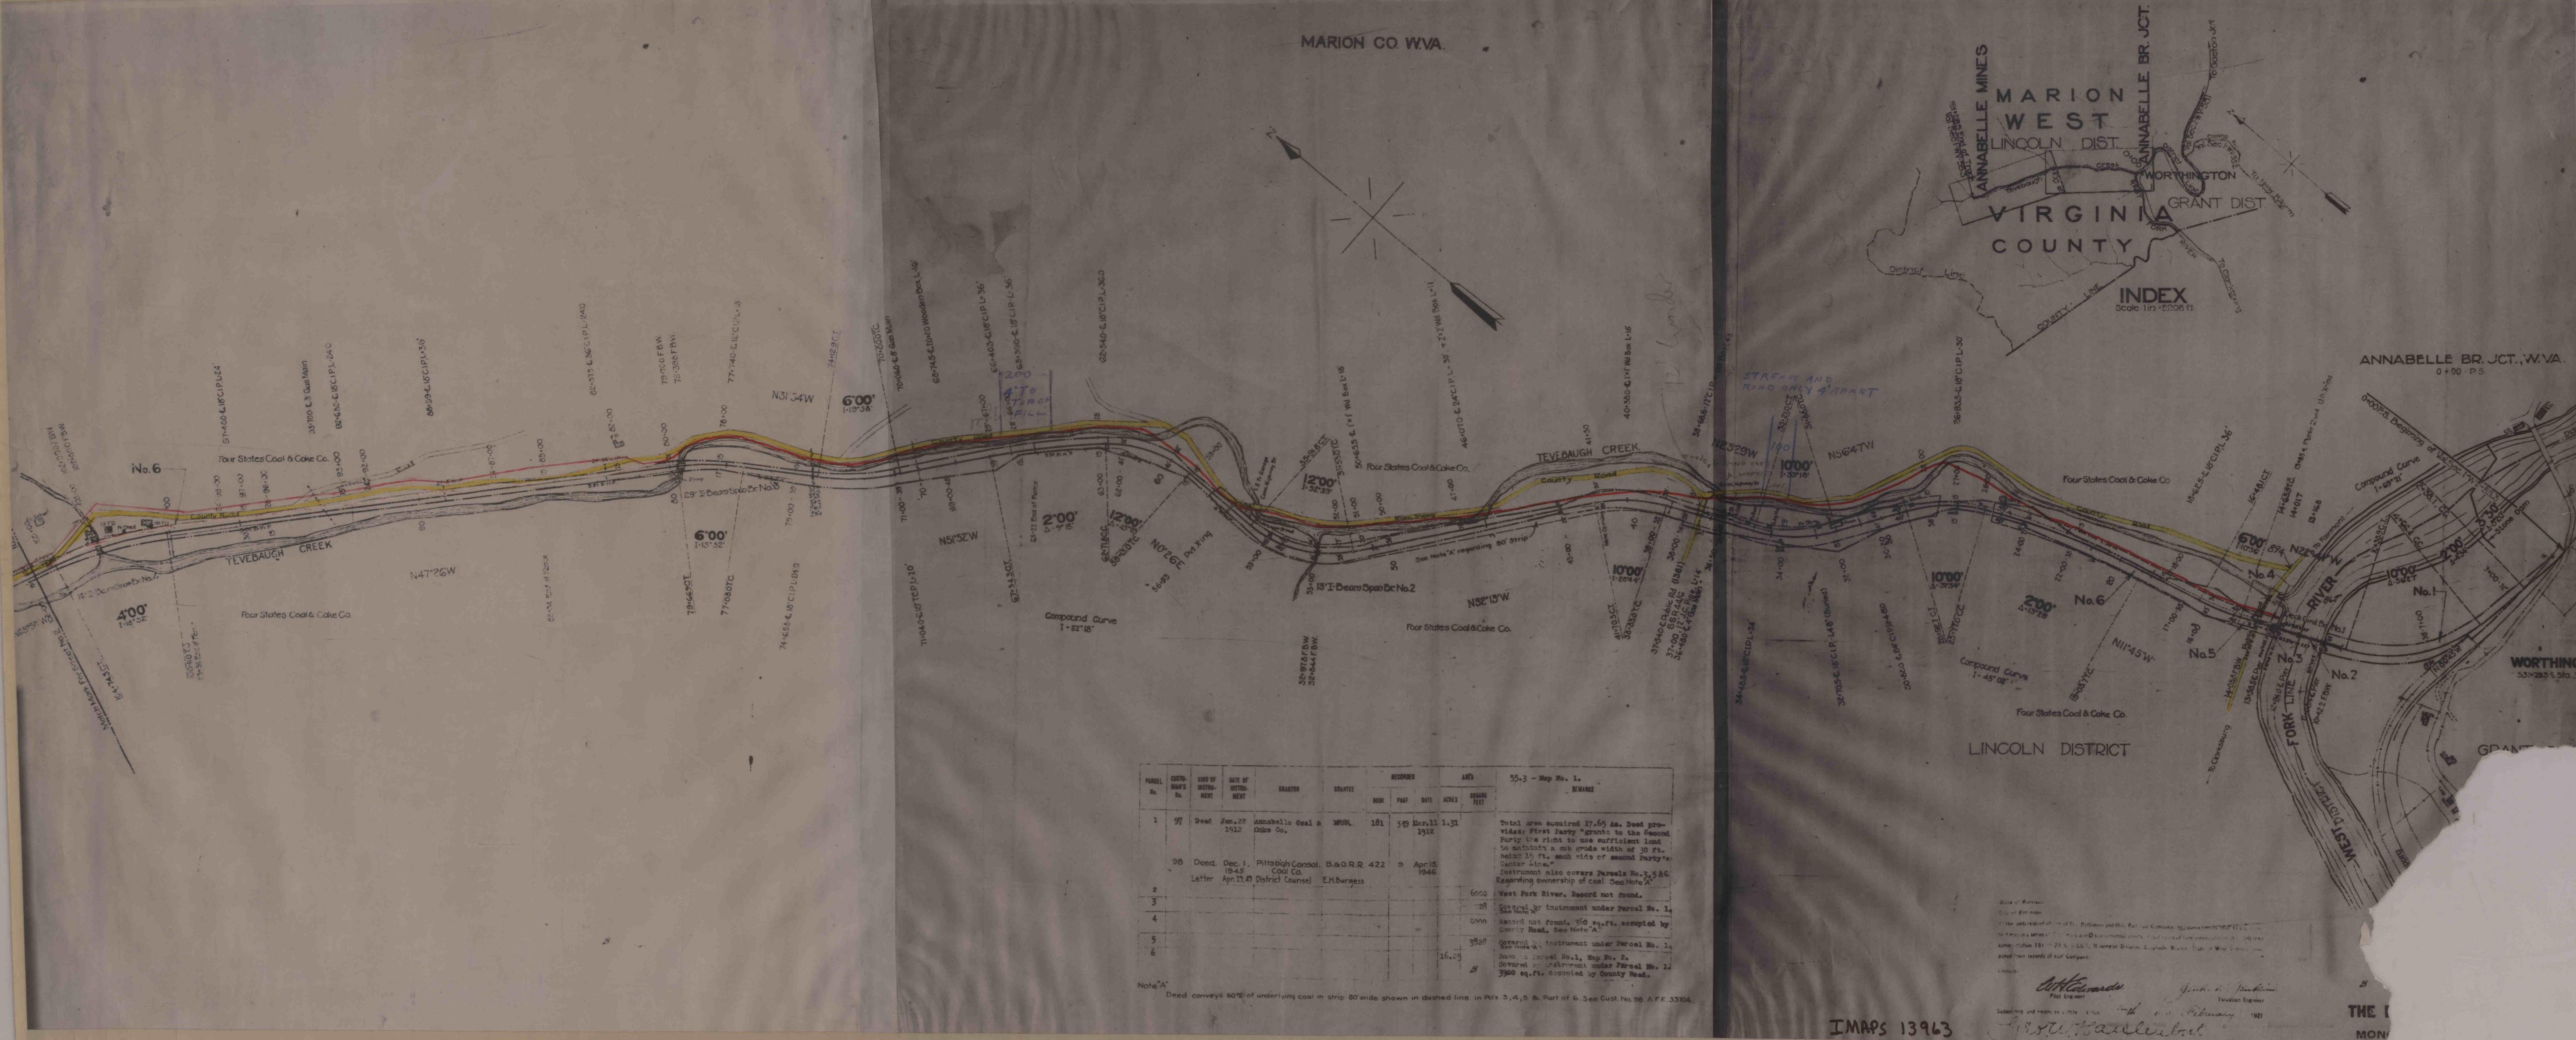

IMAPS 13963