


NO. OF SHEETS	DESCRIPTION
Sept. 1923	Retirement of 35 from stub end of T-6080(2). P.S. at sta. 109+36.0, old L-342; present L-307.

MARION CO. WVA.
MORGAN DIST.

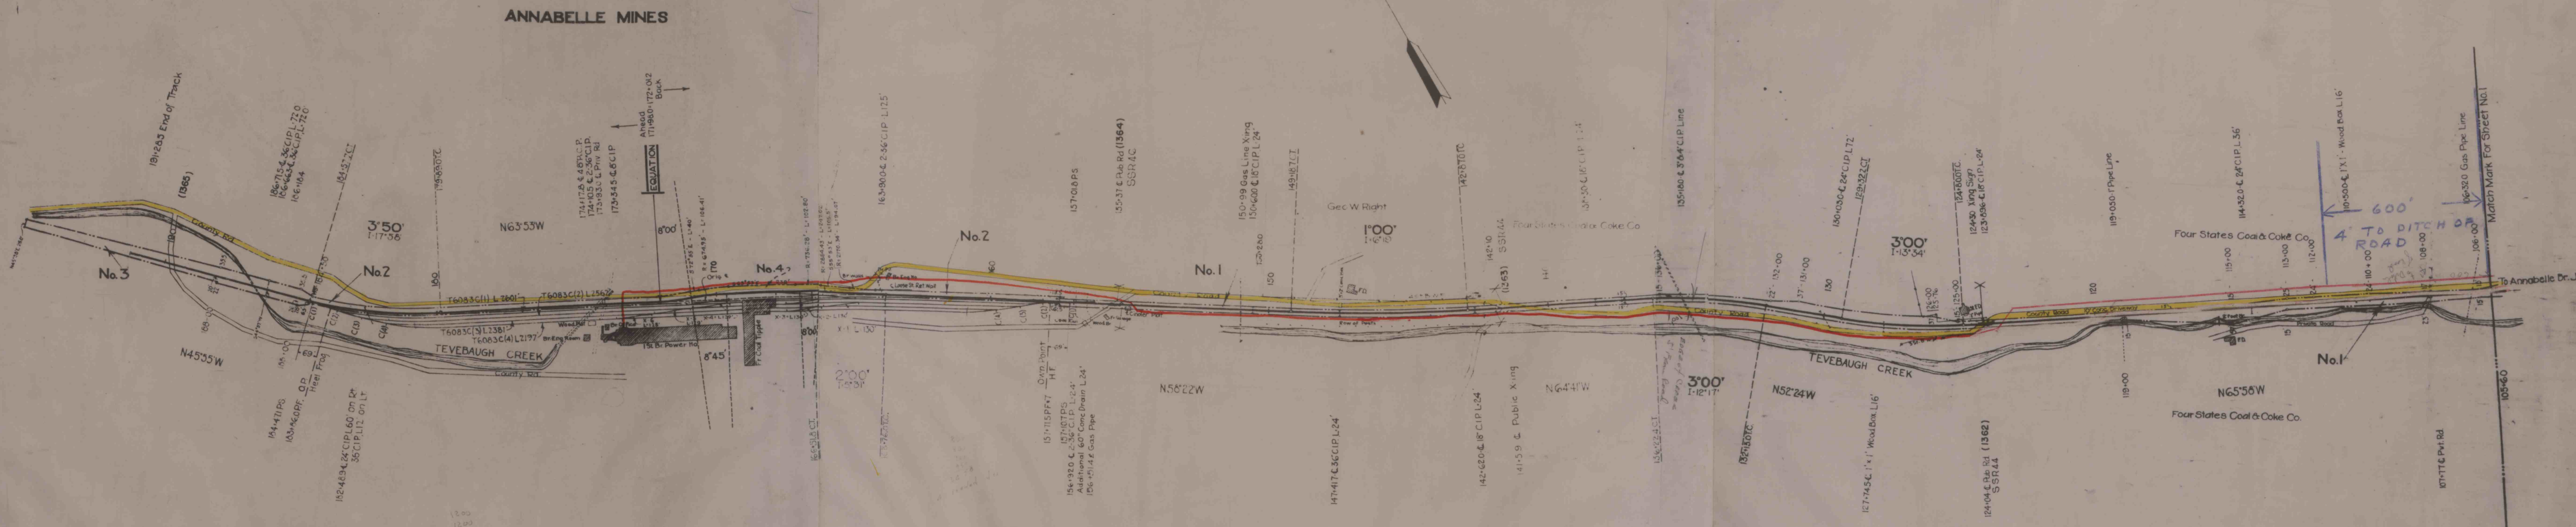

PARCEL NO.	CUSTOMER'S NO.	KIND OF INSTRUMENT	DATE OF INSTRUMENT	GRANTOR	GRANTEE	RECORDED BOOK	RECORDED PAGE	RECORDED DATE	AREA ACRES	AREA SQUARE FEET	REMARKS
1									1.85	40000	Same as Parcel No. 6, Map No. 1.
2									1.85	40000	500 sq. ft. occupied by Public Road.
3	115	Deed	Jan. 23 1912	Four States Coal & Coke Co.	MORGAN	101	346	Mar. 11 1912			Total area required 2.75 Ac. Deed provides first party "Grant" to second party the right to use adjoining land to maintain a sub-grade 11.5 ft. of ft. being 5.5 ft. on the southerly side and 17.5 ft. on the northerly side of the center line of "Main Branch."
4	114	Deed	Sept. 5 1920	Welsh & Pittsburgh Coal Co.	B. & O. R. R.	194	131	Sept. 28 1920	0.24		Sub-grade 11.5 ft. on the southerly side and 17.5 ft. on the northerly side of the center line of "Main Branch."

Sheet No. 2 of 2 primary and 0 supplemental sheets of The Baltimore and Ohio Railroad Company.
Y-55-3, Monongah Division, Annabelle Branch, from survey station 105+60 to survey station 101+28.5.

D.H. Edwards
Field Engineer

RIGHT-OF-WAY AND TRACK
THE BALTIMORE AND OHIO RAILROAD
OPERATED BY
THE BALTIMORE AND OHIO RAILROAD
MONONGAH DIVISION
ANNABELLE
STATION 105+60 TO STATION 101+28.5
SCALE: 1 IN. = 200 FT.
JUNE 30 1923
OFFICE OF VALUATION ENGINEER
BALTIMORE