


LED OR RETIRED	DESCRIPTION
Sept 1923	Reirement of 35' from subband of T-6000(2) PS at sta 169+56.0, old L=342, present L=307

MARION CO. WVA.
INCOLN DIST.

ANNABELLE MINES

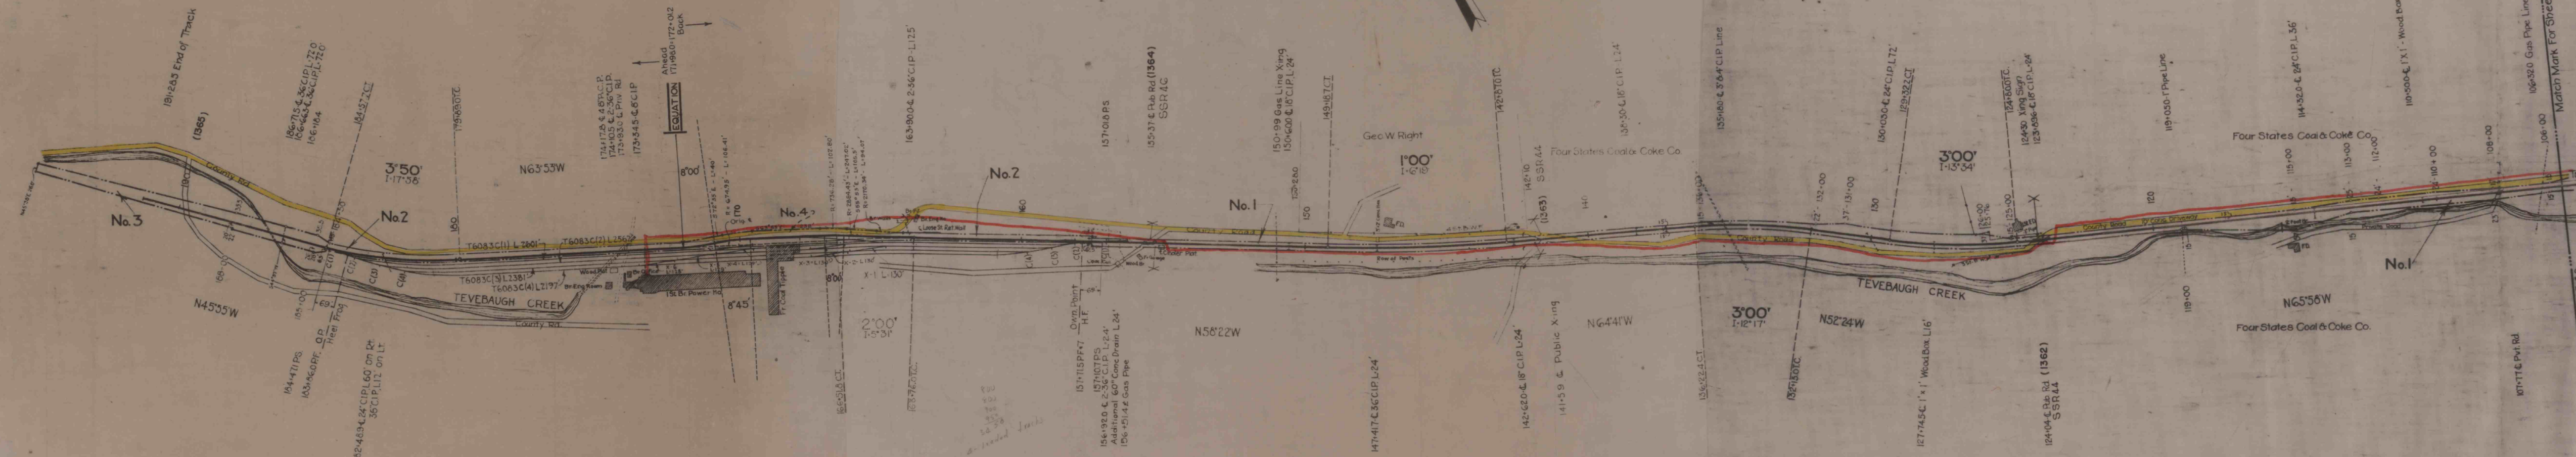

PARCEL No.	CUSTO- DIAN'S No.	KIND OF INSTRU- MENT	DATE OF INSTRU- MENT	GRANTOR	GRANTEE	RECORDED		AREA	REMARKS
						BOOK	PAGE		
1								1.83	Same as Parcel No. 6, Map No. 1.
2								40000	500 sq. ft. occupied by Public Road.
3	115	Deed	Jun. 22 1912	Four States Coal & Coke Co.	MORRIS	181	346	Mar. 11 1912	Total area acquired 2.75 Ac. Deed provides first party "grant to second party the right to use sufficient land to maintain a sub-grade width of 24 ft. being 6.5 ft. on the southerly side and 19.5 ft. on the northerly side of the center line of Tevebaugh Creek Branch."
4	114	Deed	Sept. 15 1950	Rochester & Pittsburgh Coal Co.	B. & O. R.R.	494	131	Sept. 28 1950	Ac. 37.273

RIGHT-OF-WAY AND TRACK
THE BALTIMORE AND OHIO RAILROAD
OPERATED BY
THE BALTIMORE AND OHIO RAILROAD
MONONGAH DIVISION
AN
STATION 105+60 TO STATION
SCALE: 1 IN. = 200 FT.
JUL
OFFICE OF VALUATION ENGINEER
BALTIMORE, MD.

Sheet No. 2 of 2 primary and 0 supplemental sheets of The Baltimore and Ohio Railroad Company,
V-553, Monongah Division, Annabelle Branch, from survey station 105+60 to survey station
191+28.5.

W. H. Edwards
Civil Engineer