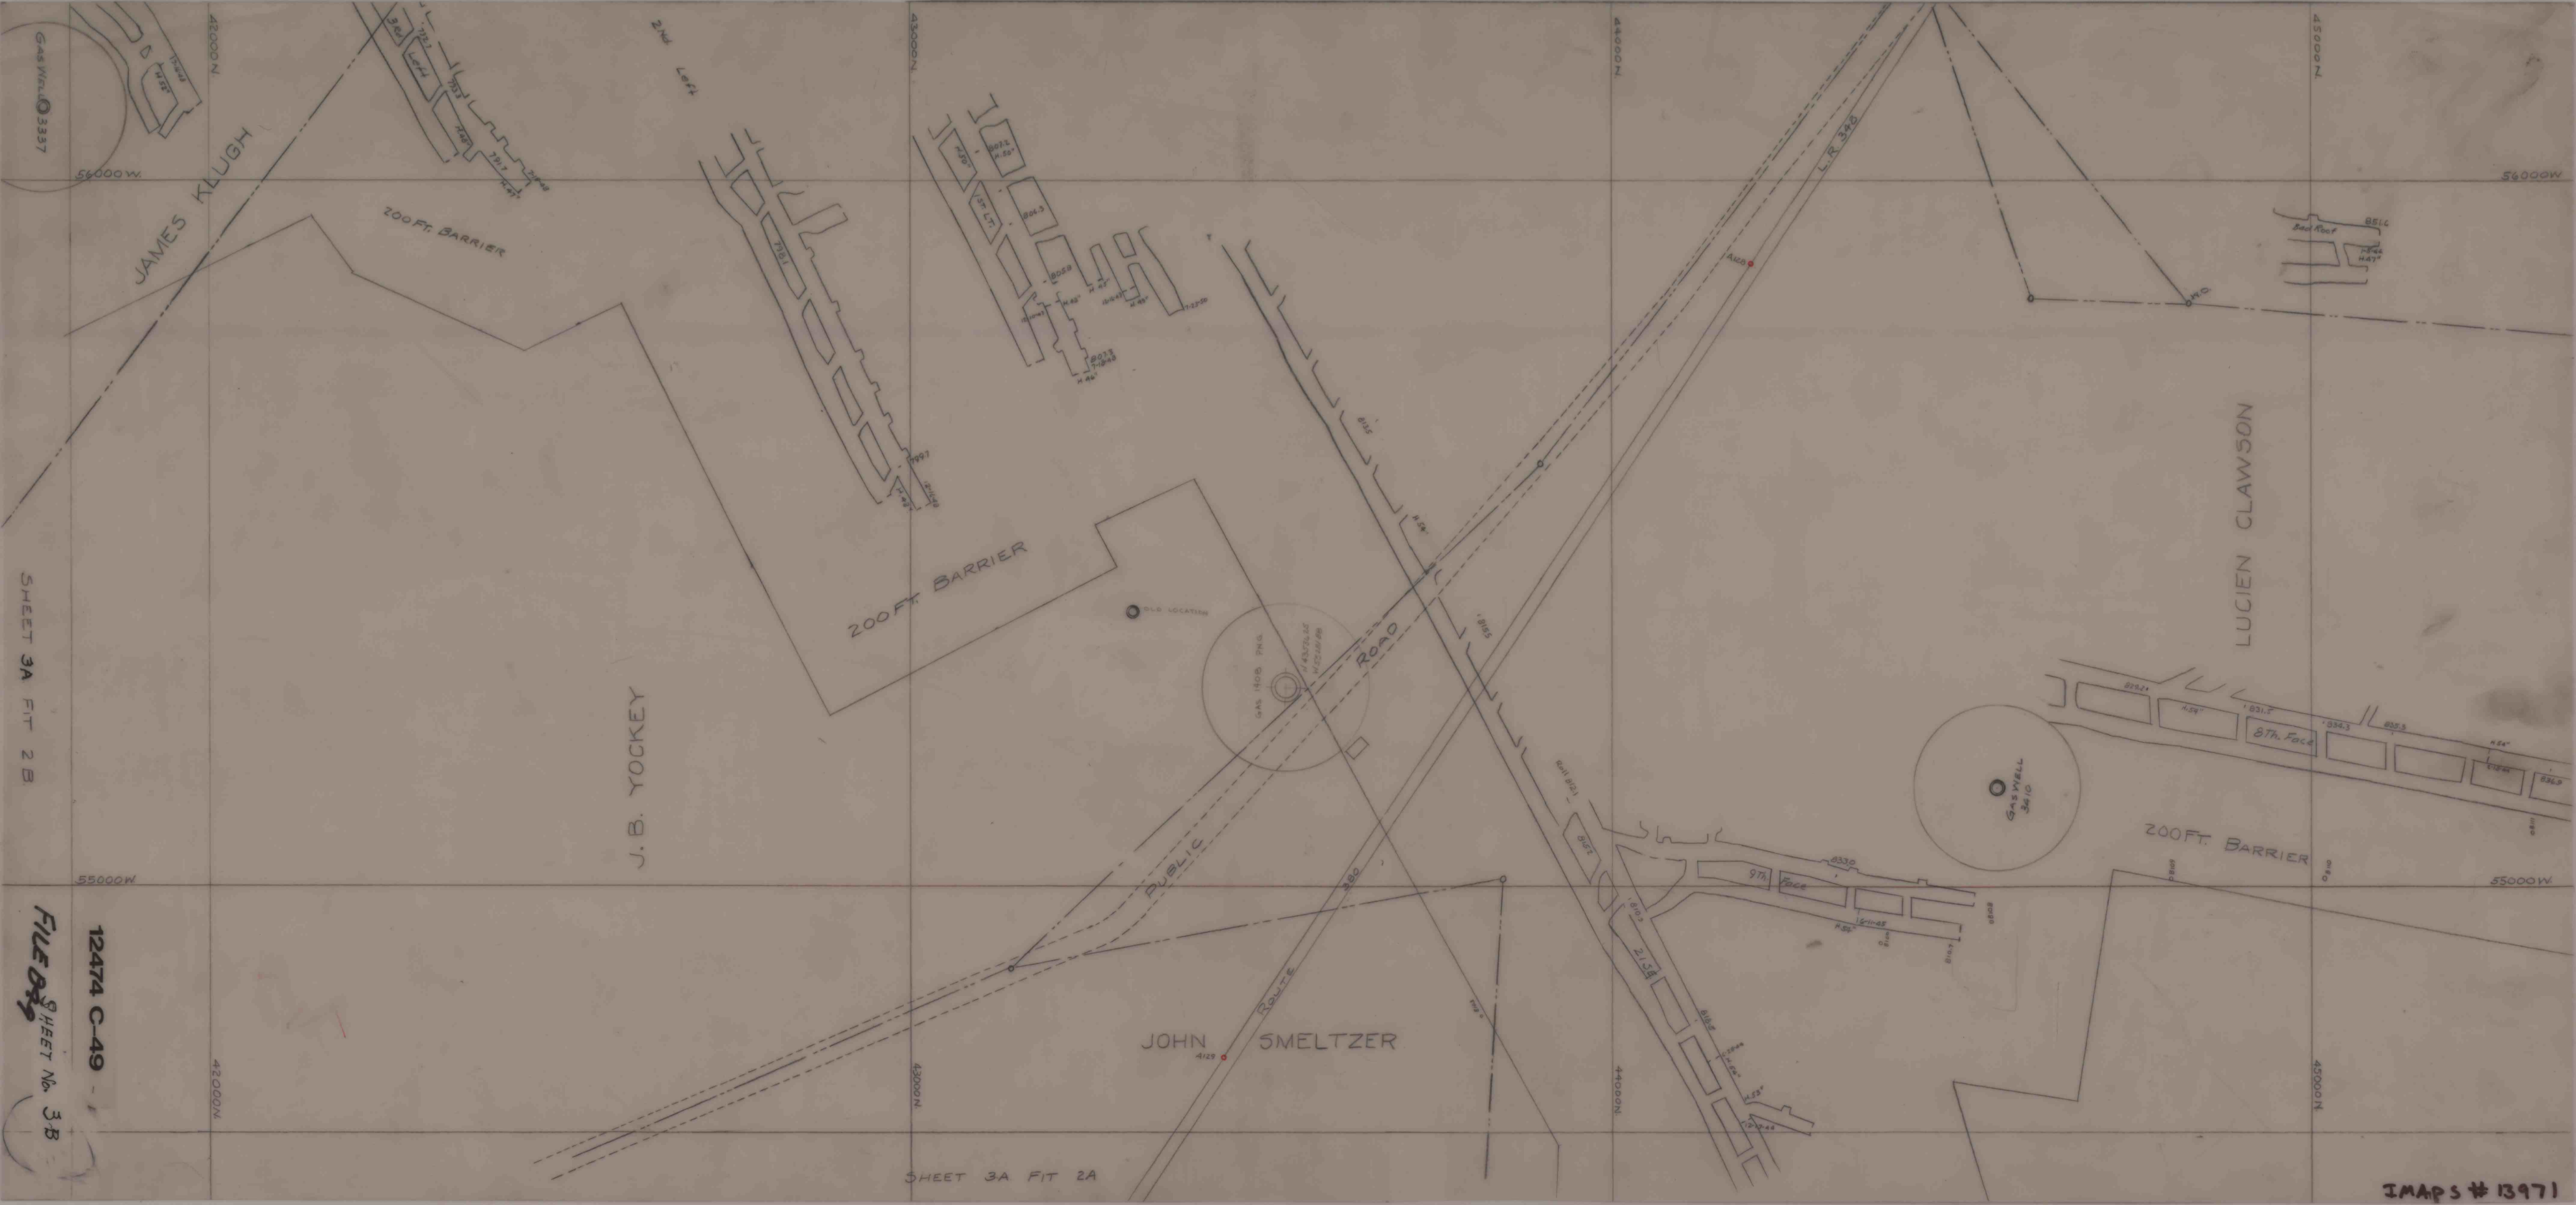
JAMES KLUGH
200 Ft. BARRIER
2ND LEFT
J. B. YOCKEY
200 FT. BARRIER
PUBLIC ROAD
JOHN SMELTZER
L.R. 328
LUCIEN CLAWSON
8Th. FACE
9Th. FACE
GASWELL 3610
200 Ft. BARRIER
BELL
Bad Roof
42000 N
43000 N
44000 N
45000 N
56000 W
55000 W
SHEET 3A FIT 2B
SHEET 3A FIT 2A
12474 C-49
FILE 8
SHEET No. 3B
IMAPS # 13971