


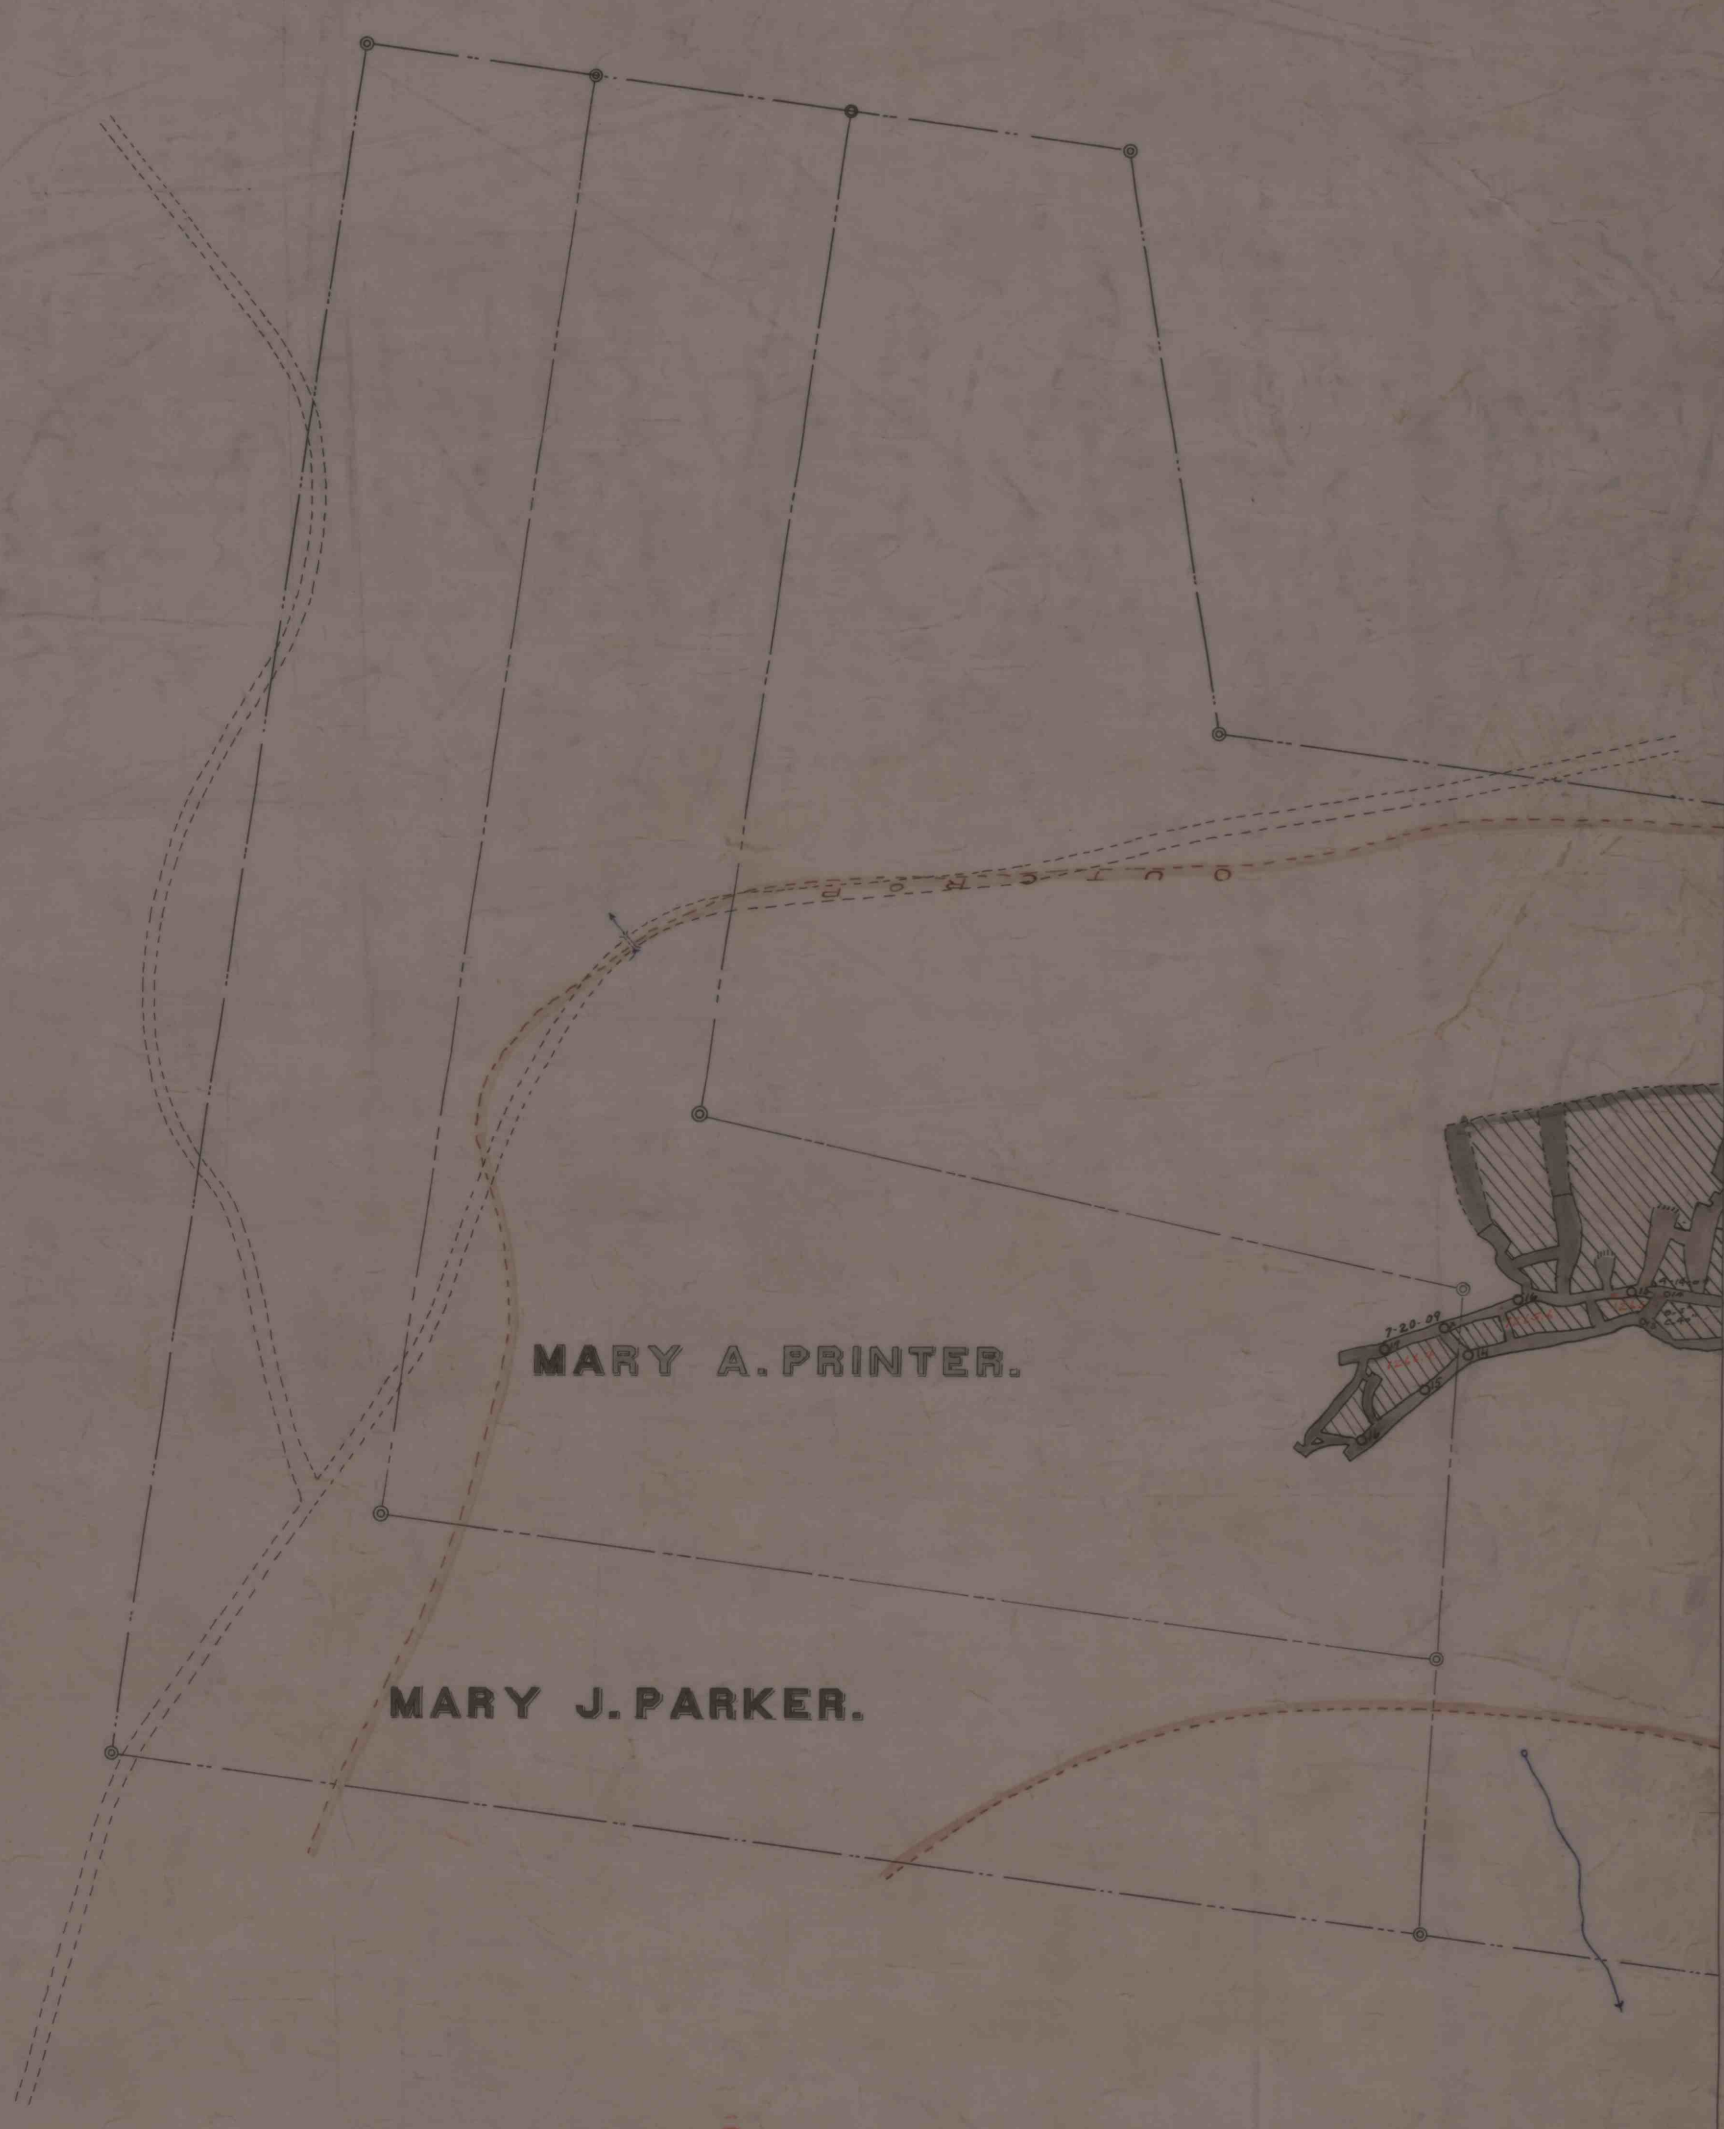

MARY A. PRINTER.

MARY J. PARKER.