


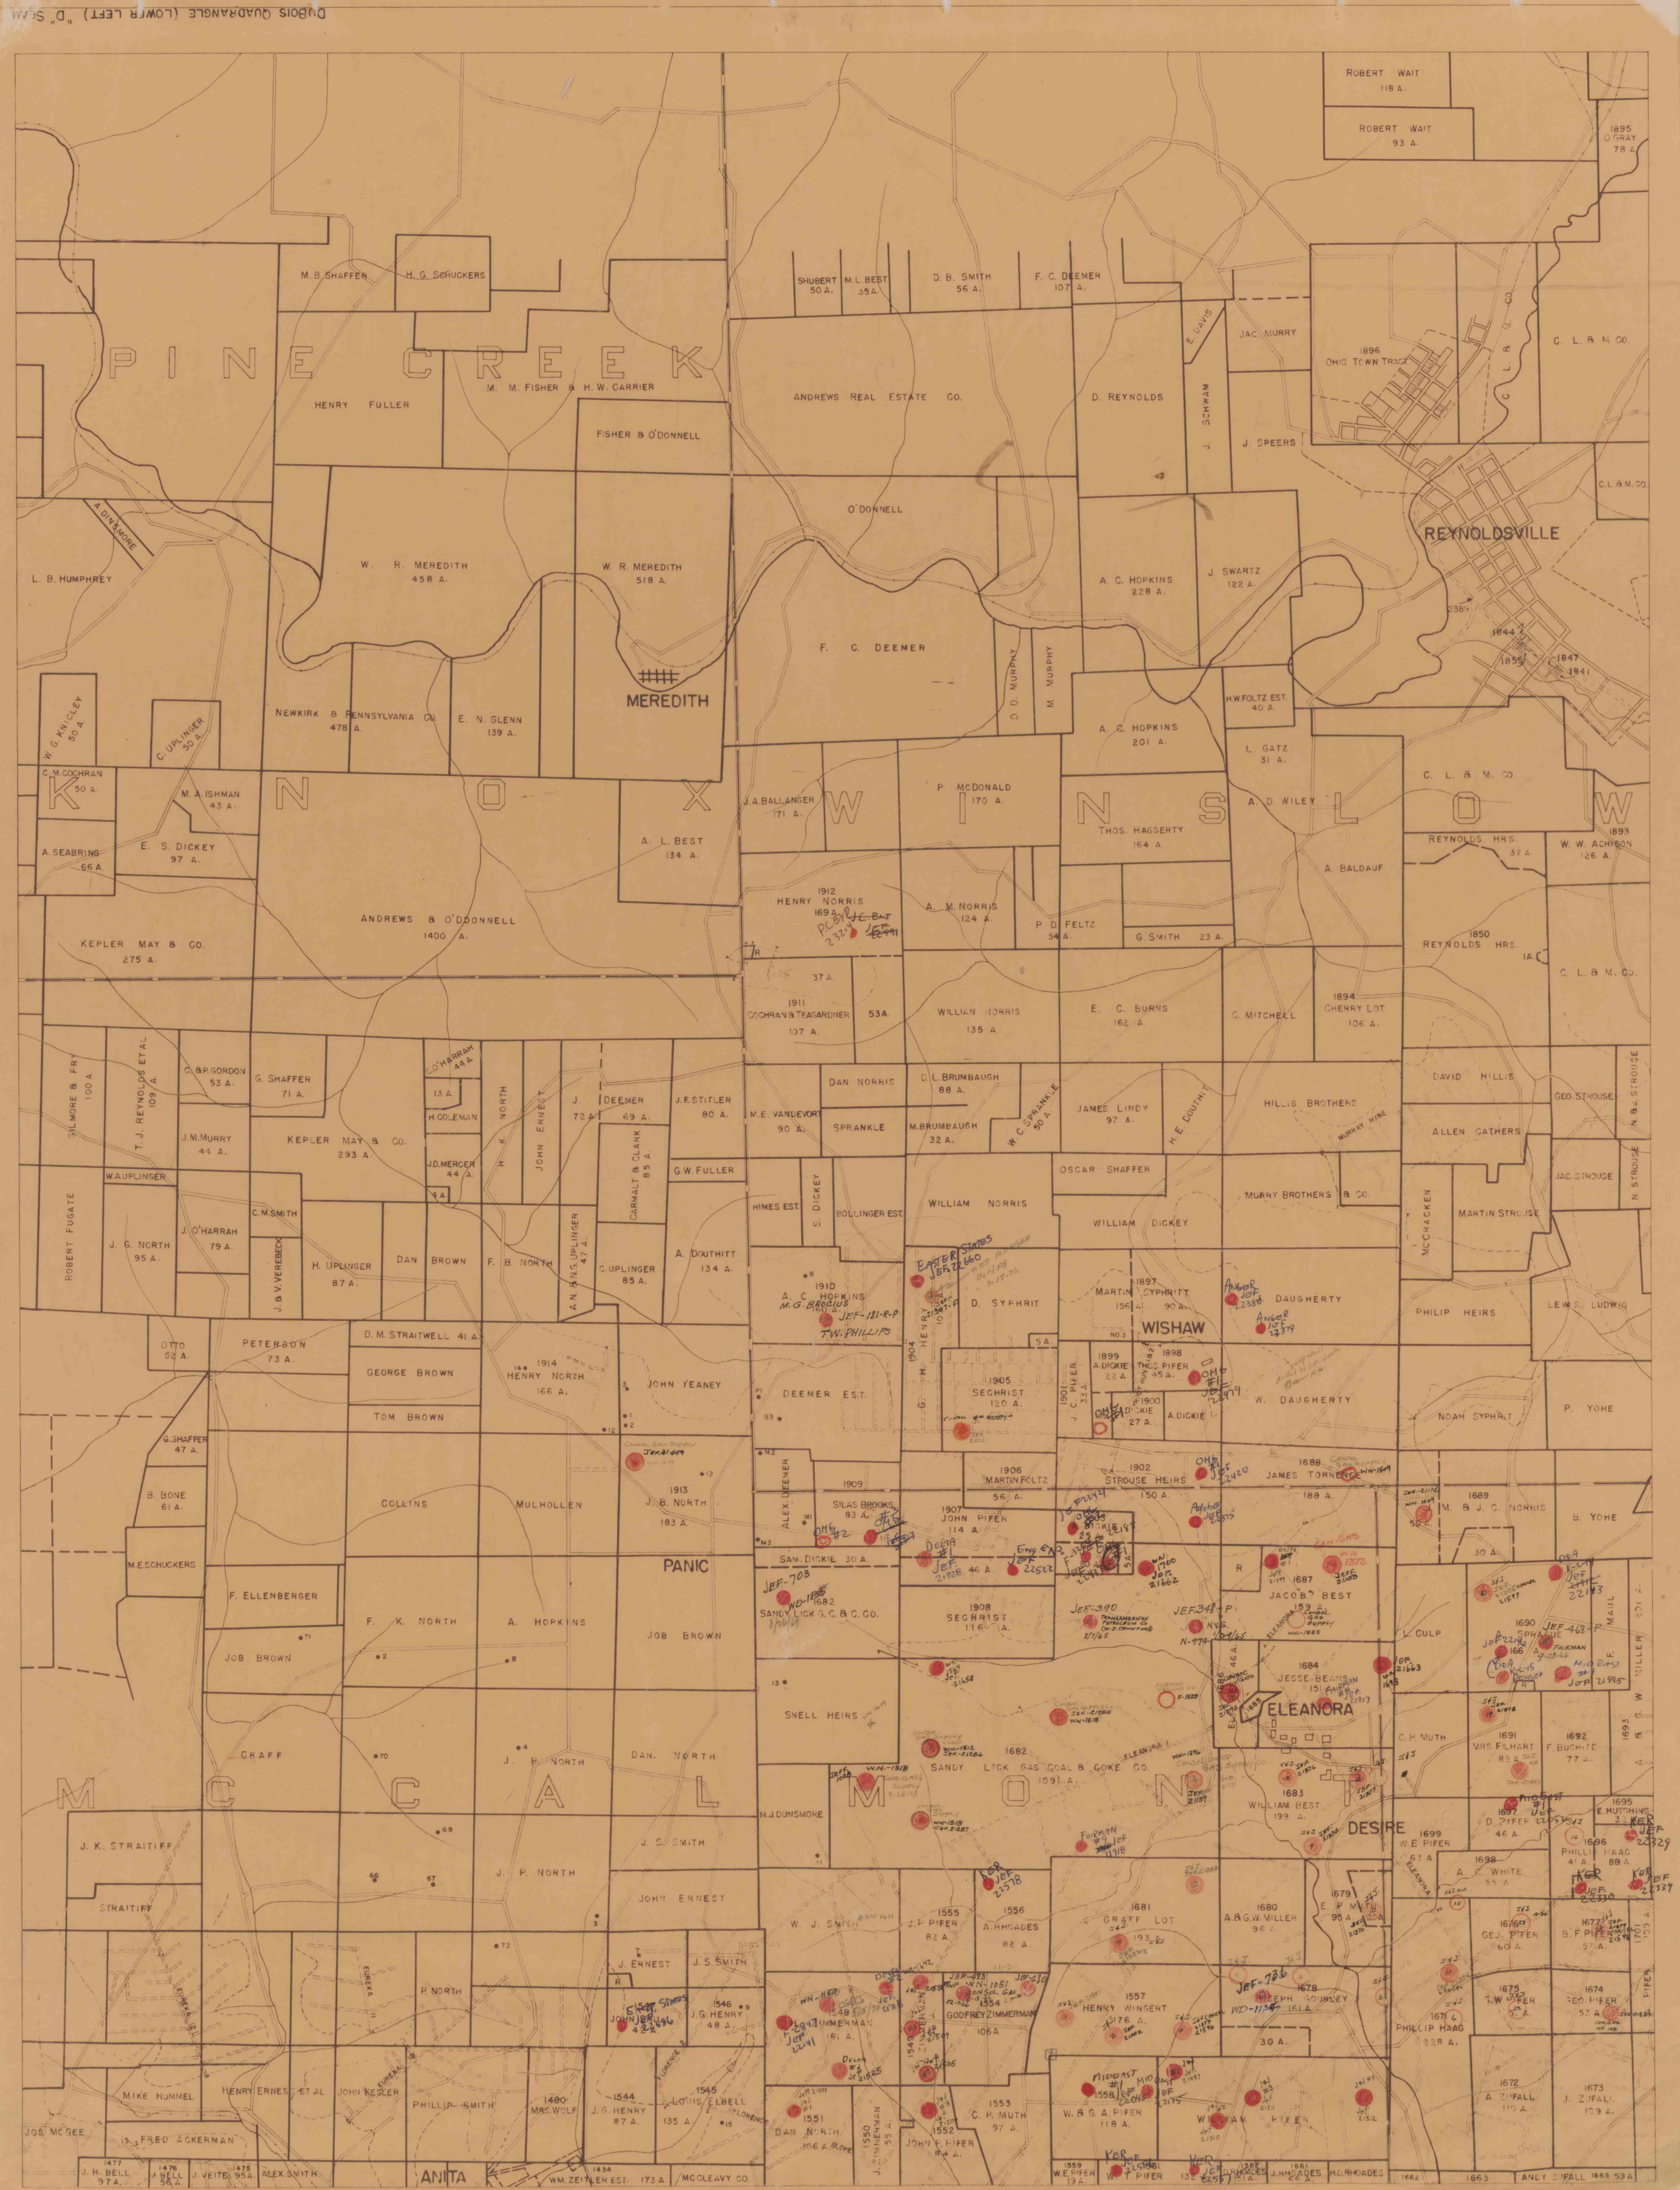

IMAP # 14057