


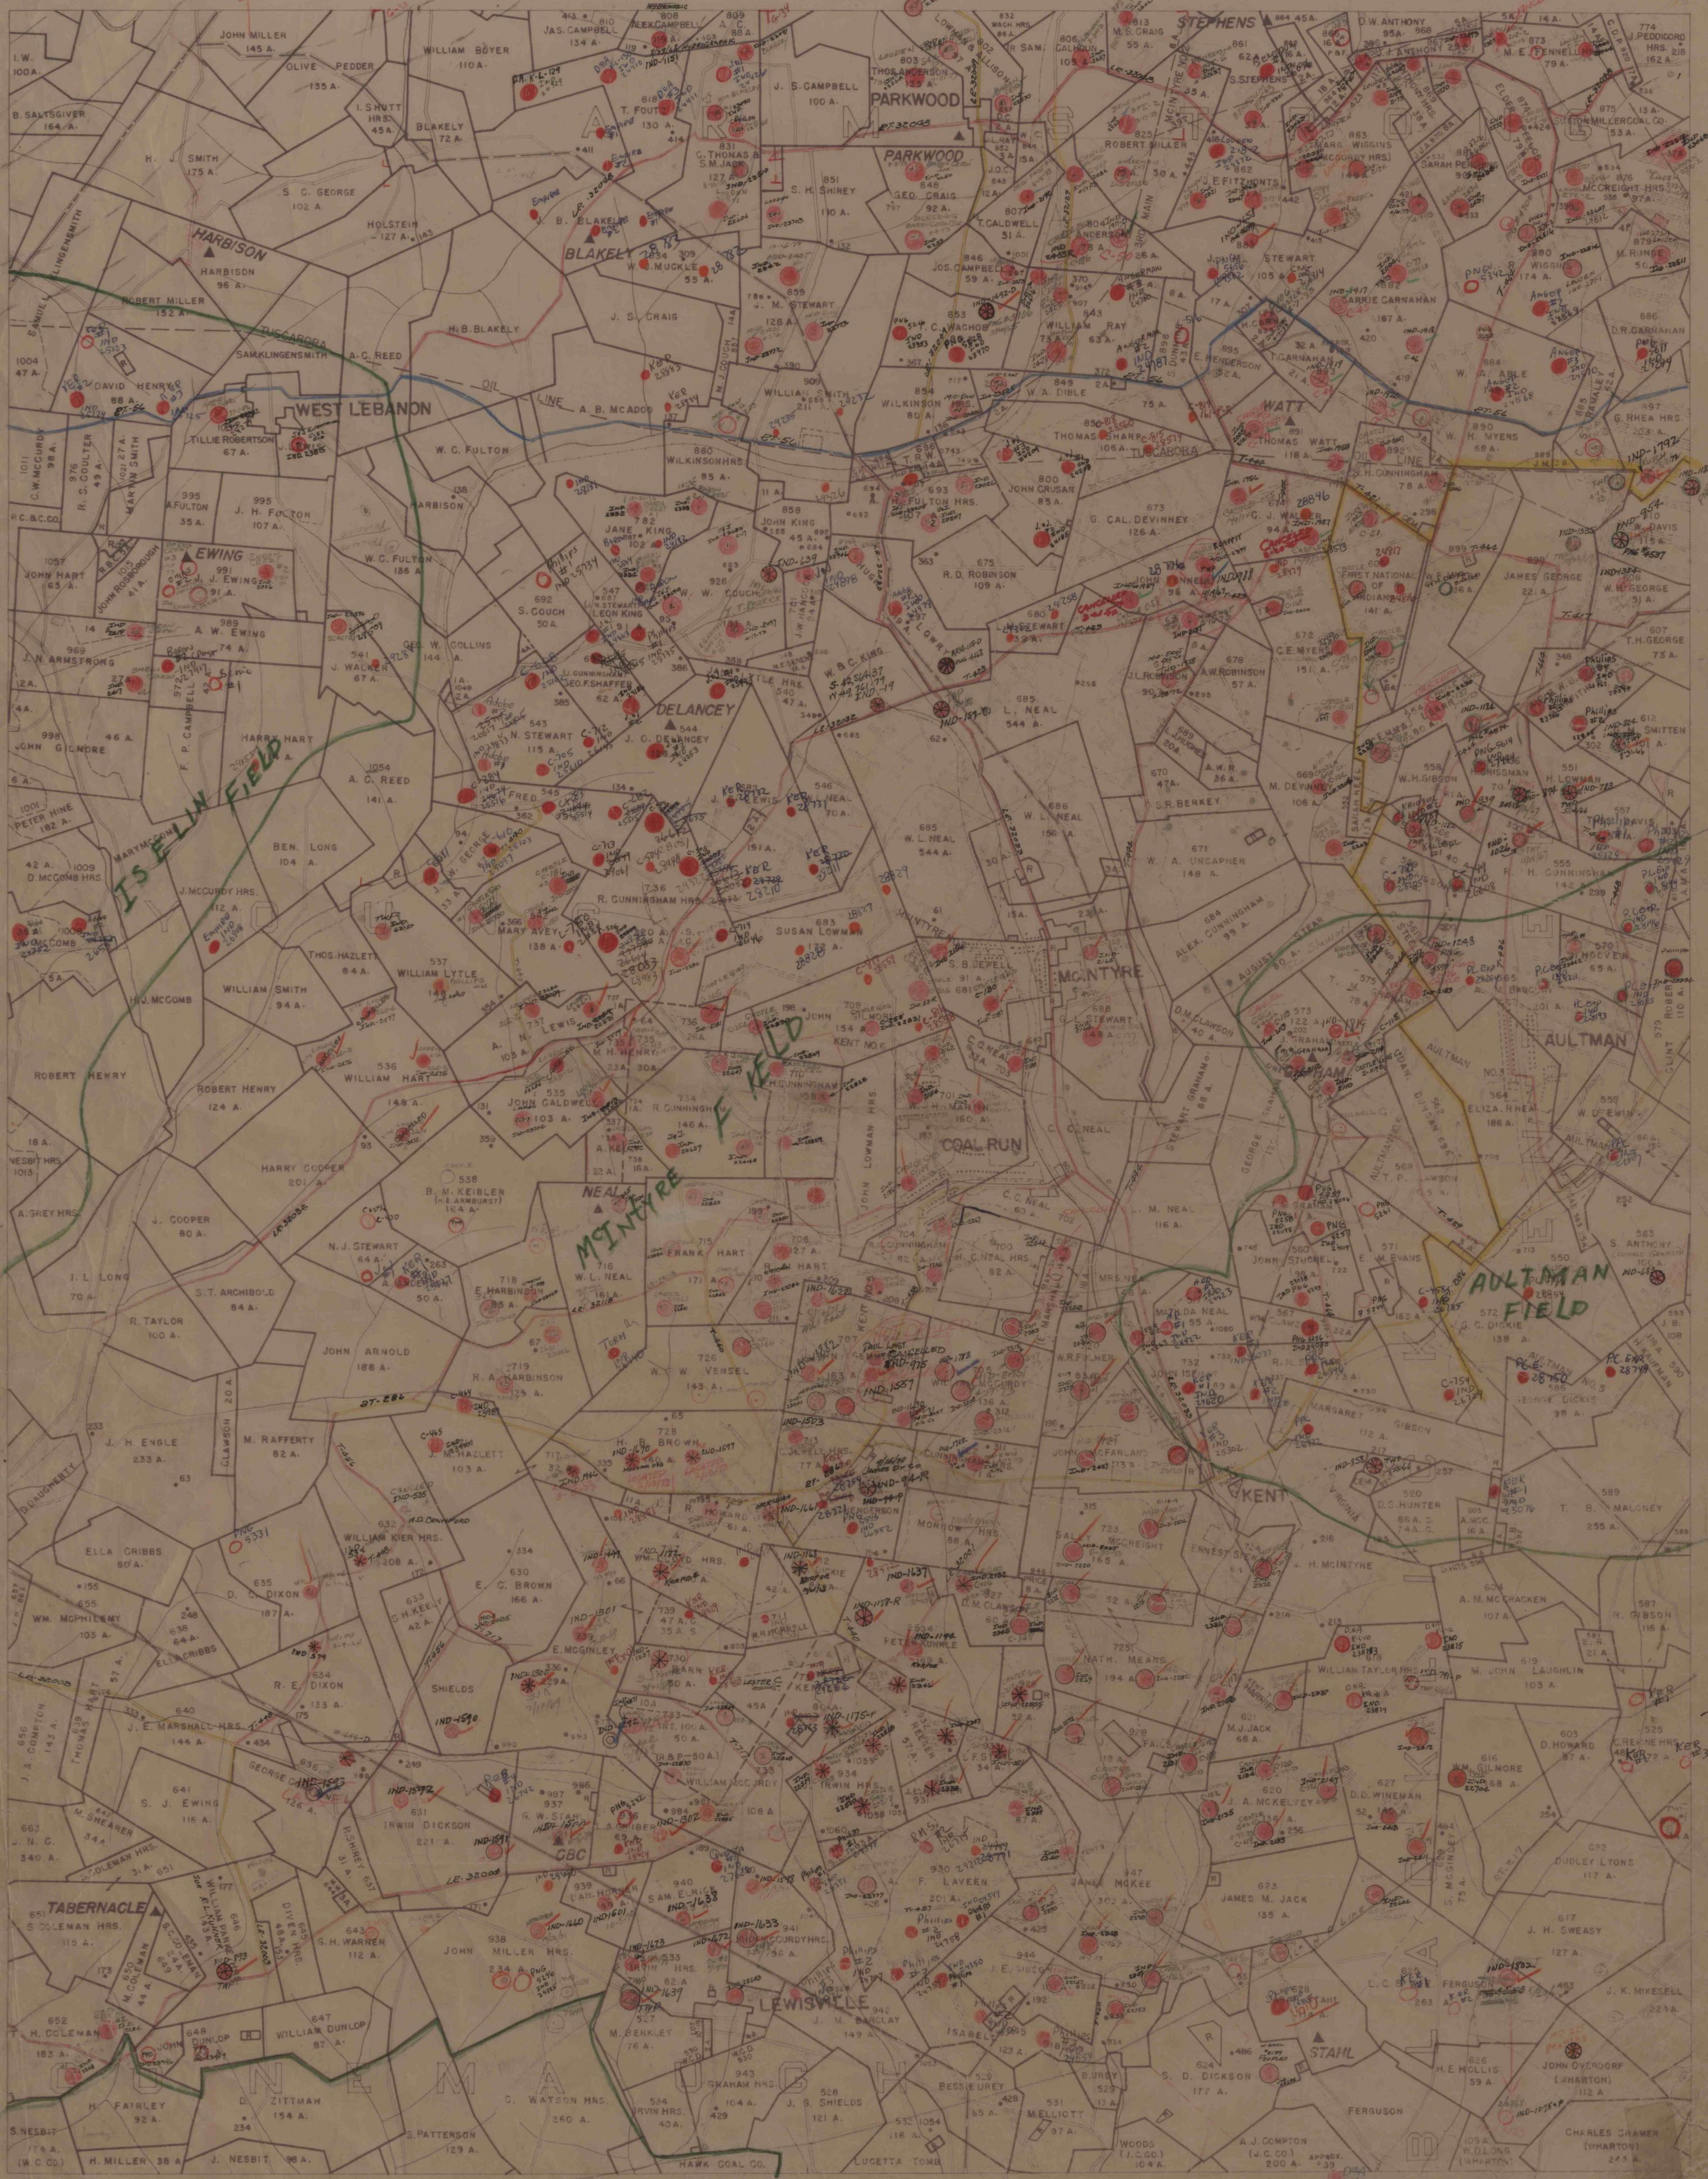

IMAPS # 14065