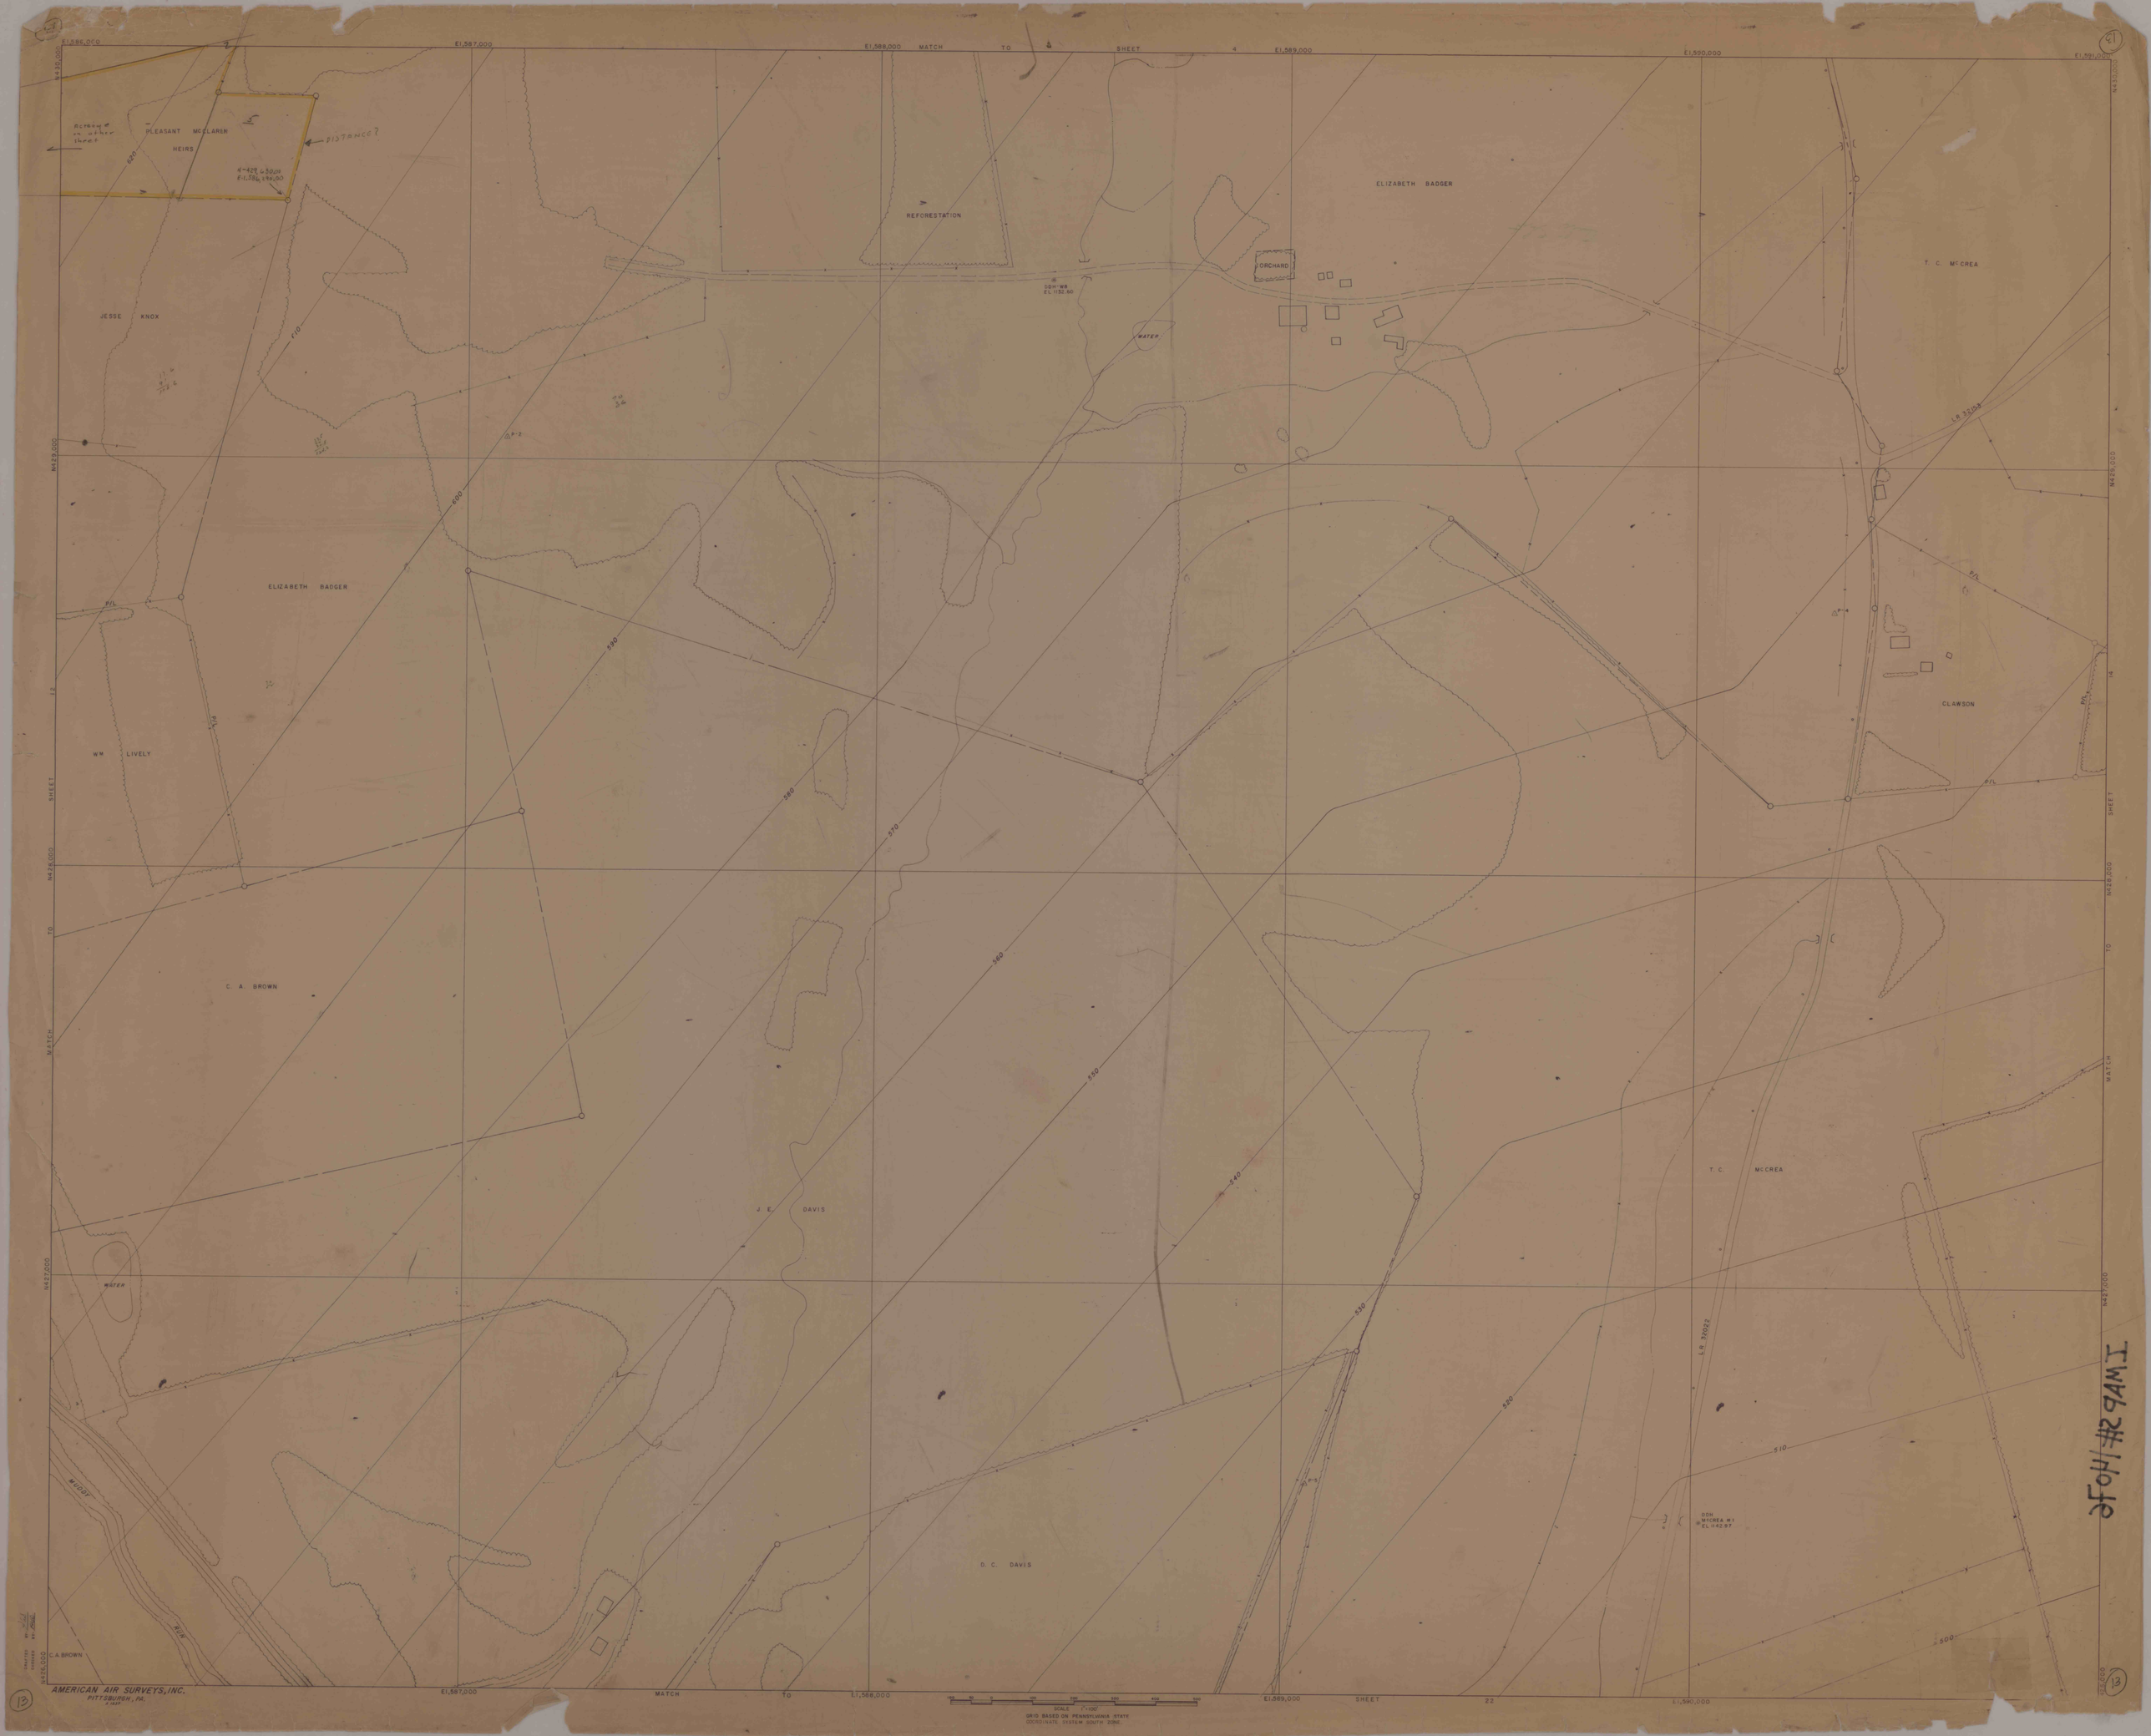
E1,586,000
E1,587,000
E1,588,000 MATCH TO SHEET 4
E1,589,000
E1,590,000
E1,591,000
N430,000
N429,000
N428,000
N427,000
N426,000
MATCH TO SHEET 12
MATCH TO SHEET 14
MATCH TO SHEET 22
PLEASANT MCLAREN HEIRS
Acreage in other sheet
DISTANCE?
JESSE KNOX
ELIZABETH BADGER
REFORESTATION
ORCHARD
DDH-W8
EL 1132.60
WATER
T. C. MCCREA
L.R. 32052
CLAWSON
WM LIVELY
C. A. BROWN
J. E. DAVIS
D. C. DAVIS
DDH
MCCREA #1
EL 1142.97
MUDDY RUN
P/L
P-2
P-3
P-14
620
610
600
590
580
570
560
550
540
530
520
510
500
SCALE 1"=100'
GRID BASED ON PENNSYLVANIA STATE COORDINATE SYSTEM SOUTH ZONE.
AMERICAN AIR SURVEYS, INC.
PITTSBURGH, PA.
