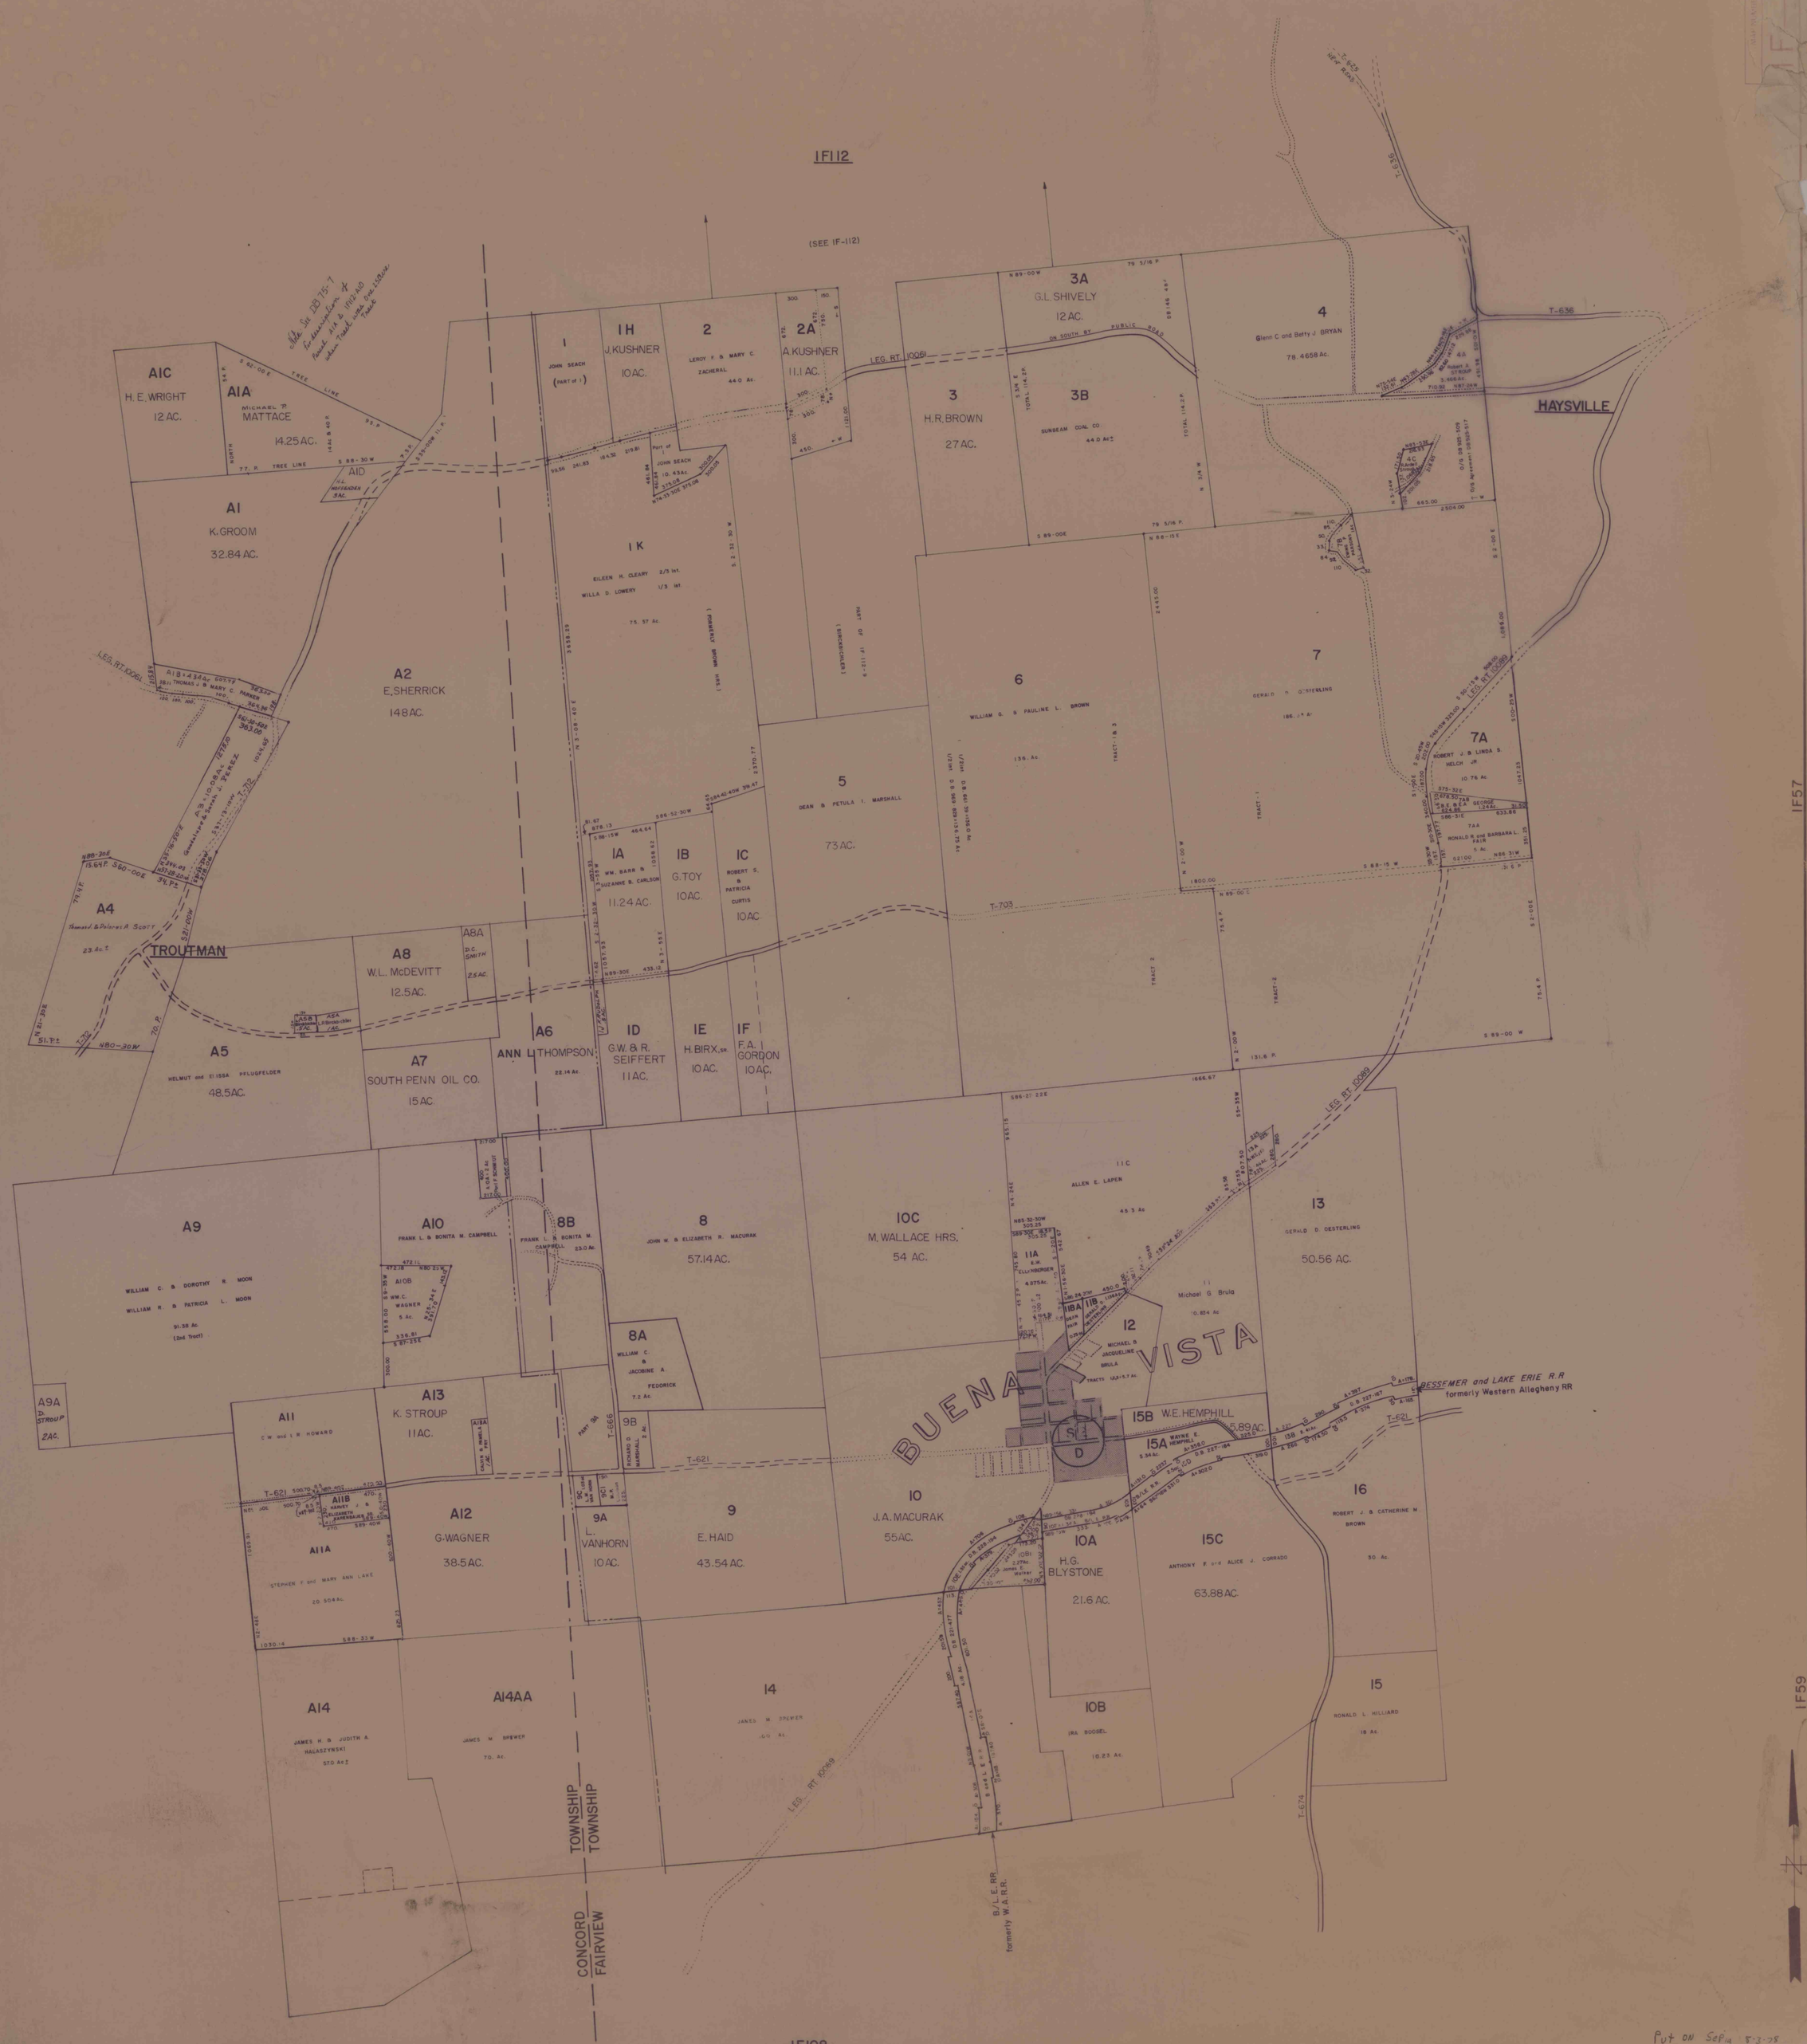
1F112
(SEE 1F-112)
3F06
1F57
1F59
1F108
AIC
H. E. WRIGHT
12 AC.
AIA
MICHAEL P.
MATTAGE
14.25 AC.
AID
AI
K. GROOM
32.84 AC.
A2
E. SHERRICK
148 AC.
1
JOHN SEACH
(PART of 1)
1H
J. KUSHNER
10 AC.
2
LEROY F. & MARY C.
ZACHERAL
44.0 Ac.
2A
A. KUSHNER
11.1 AC.
3A
G.L. SHIVELY
12 AC.
3
H.R. BROWN
27 AC.
3B
SUNBEAM COAL CO.
44.0 Ac±
4
Glenn C. and Betty J. BRYAN
78.4658 Ac.
4A
4C
1K
EILEEN H. CLEARY 2/3 Int.
WILLA D. LOWERY 1/3 Int.
75.57 Ac.
5
DEAN & PETULA I. MARSHALL
73 AC.
6
WILLIAM G. & PAULINE L. BROWN
136. Ac.
7
GERALD D. OESTERLING
7A
ROBERT J. & LINDA S.
HELCH JR.
10.76 Ac.
7AA
RONALD R. and BARBARA L.
FAIR
5 Ac.
A4
Thomas J. & Dolores A. SCOTT
23. Ac±
A5
HELMUT and ELISSA PFLUGFELDER
48.5 AC.
A8
W.L. McDEVITT
12.5 AC.
A8A
D.C.
SMITH
2.5 AC.
A7
SOUTH PENN OIL CO.
15 AC.
A6
ANN L. THOMPSON
22.14 Ac.
IA
WM. BARR &
SUZANNE B. CARLSON
11.24 AC.
IB
G. TOY
10 AC.
IC
ROBERT S.
&
PATRICIA
CURTIS
10 AC.
ID
G.W. & R.
SEIFFERT
11 AC.
IE
H. BIRX, SR.
10 AC.
IF
F.A.
GORDON
10 AC.
A9
WILLIAM C. & DOROTHY R. MOON
WILLIAM R. & PATRICIA L. MOON
91.38 Ac.
(2nd Tract)
A9A
D. STROUP
2 AC.
A10
FRANK L. & BONITA M. CAMPBELL
A10B
WM. C.
WAGNER
5 Ac.
8B
FRANK L. & BONITA M.
CAMPBELL
23.0 Ac.
8
JOHN W. & ELIZABETH R. MACURAK
57.14 AC.
8A
WILLIAM C.
&
JACOBINE A.
FEDORICK
7.2 Ac.
10C
M. WALLACE HRS.
54 AC.
11C
ALLEN E. LAPEN
45.3 Ac
11A
E.W.
ELLENBERGER
4.875 Ac.
11B
Michael G. Brula
0.824 Ac
12
MICHAEL & JACQUELINE
BRULA
13
GERALD D. OESTERLING
50.56 AC.
BUENA VISTA
15B
W.E. HEMPHILL
5.89 AC.
15A
WAYNE E.
HEMPHILL
3.54 Ac.
16
ROBERT J. & CATHERINE M.
BROWN
30 Ac.
15
RONALD L. HILLIARD
18 Ac.
15C
ANTHONY F. and ALICE J. CORRADO
63.88 AC.
10A
H.G.
BLYSTONE
21.6 AC.
10B
IRA BOOSEL
10.23 Ac.
10
J.A. MACURAK
55 AC.
9A
L.
VANHORN
10 AC.
9
E. HAID
43.54 AC.
9B
RICHARD D.
MARSHALL
2 Ac.
A11
C.W. and L.M. HOWARD
A11A
STEPHEN F. and MARY ANN LAKE
20.504 Ac.
A11B
A12
G. WAGNER
38.5 AC.
A13
K. STROUP
11 AC.
A14
JAMES H. & JUDITH A.
HALASZYNSKI
570 Ac±
A14AA
JAMES M. BREWER
70. Ac.
14
JAMES M. BREWER
100 Ac.
TROUTMAN
HAYSVILLE
BESSEMER and LAKE ERIE R.R.
formerly Western Allegheny RR
B. & L.E. RR.
formerly W.A. R.R.
TOWNSHIP
TOWNSHIP
CONCORD
FAIRVIEW
LEG. RT. 10069
T-636
T-703
T-621
T-674
T-666
T-672
T-673
T-702
T-623
Put on Sep 14 8-3-78
1 MAPS # 14124
12069 -