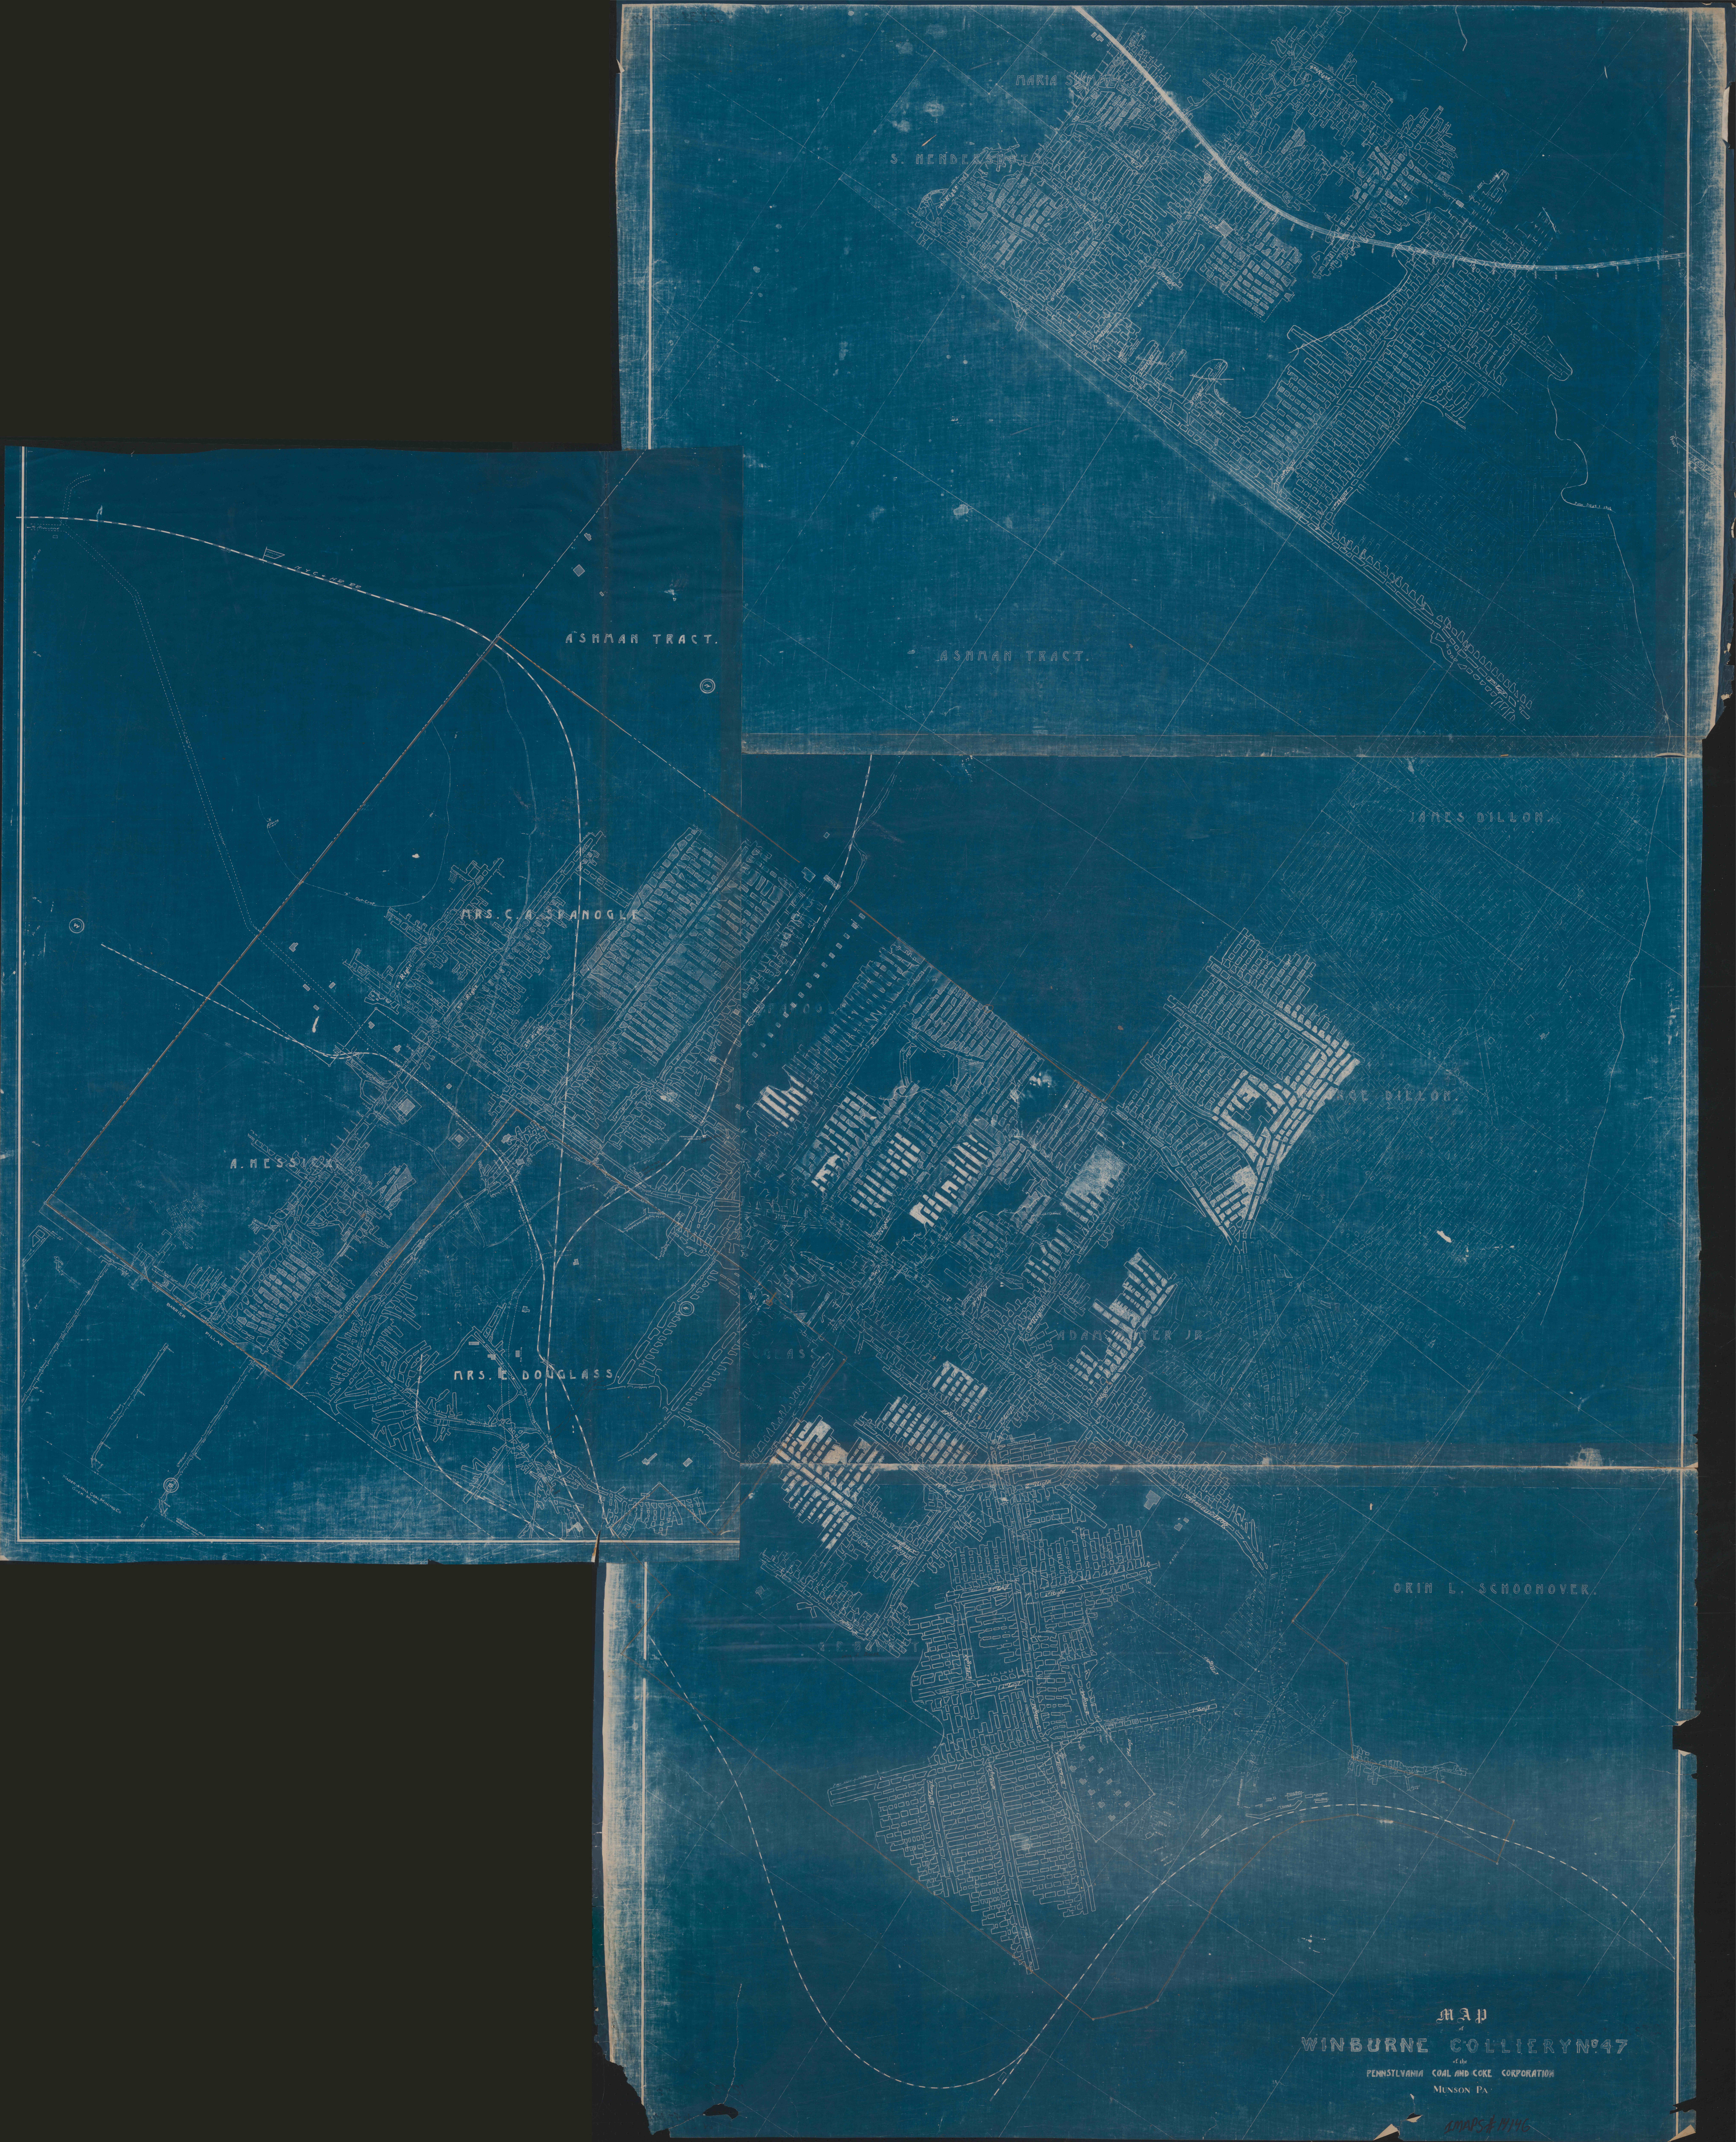
MARIA SH
S. HENDERSHOT
ASHMAN TRACT.
ASHMAN TRACT.
N.Y.C. & H.R. RR
JAMES DILLON.
MRS. C. A. SPANOGLE
"B" Out-Crop
RGE DILLON.
A. MESSICK
BARRIER PILLAR
BARRIER PILLAR
MRS. E. DOUGLASS.
ADAM YER JR.
MADERA-HILL COAL MINING CO.
E. BARRETT
ORIN L. SCHOONOVER.

MAP
of
WINBURNE COLLIERY No. 47
of the
PENNSYLVANIA COAL AND COKE CORPORATION
MUNSON PA.

MAPS # 11146