


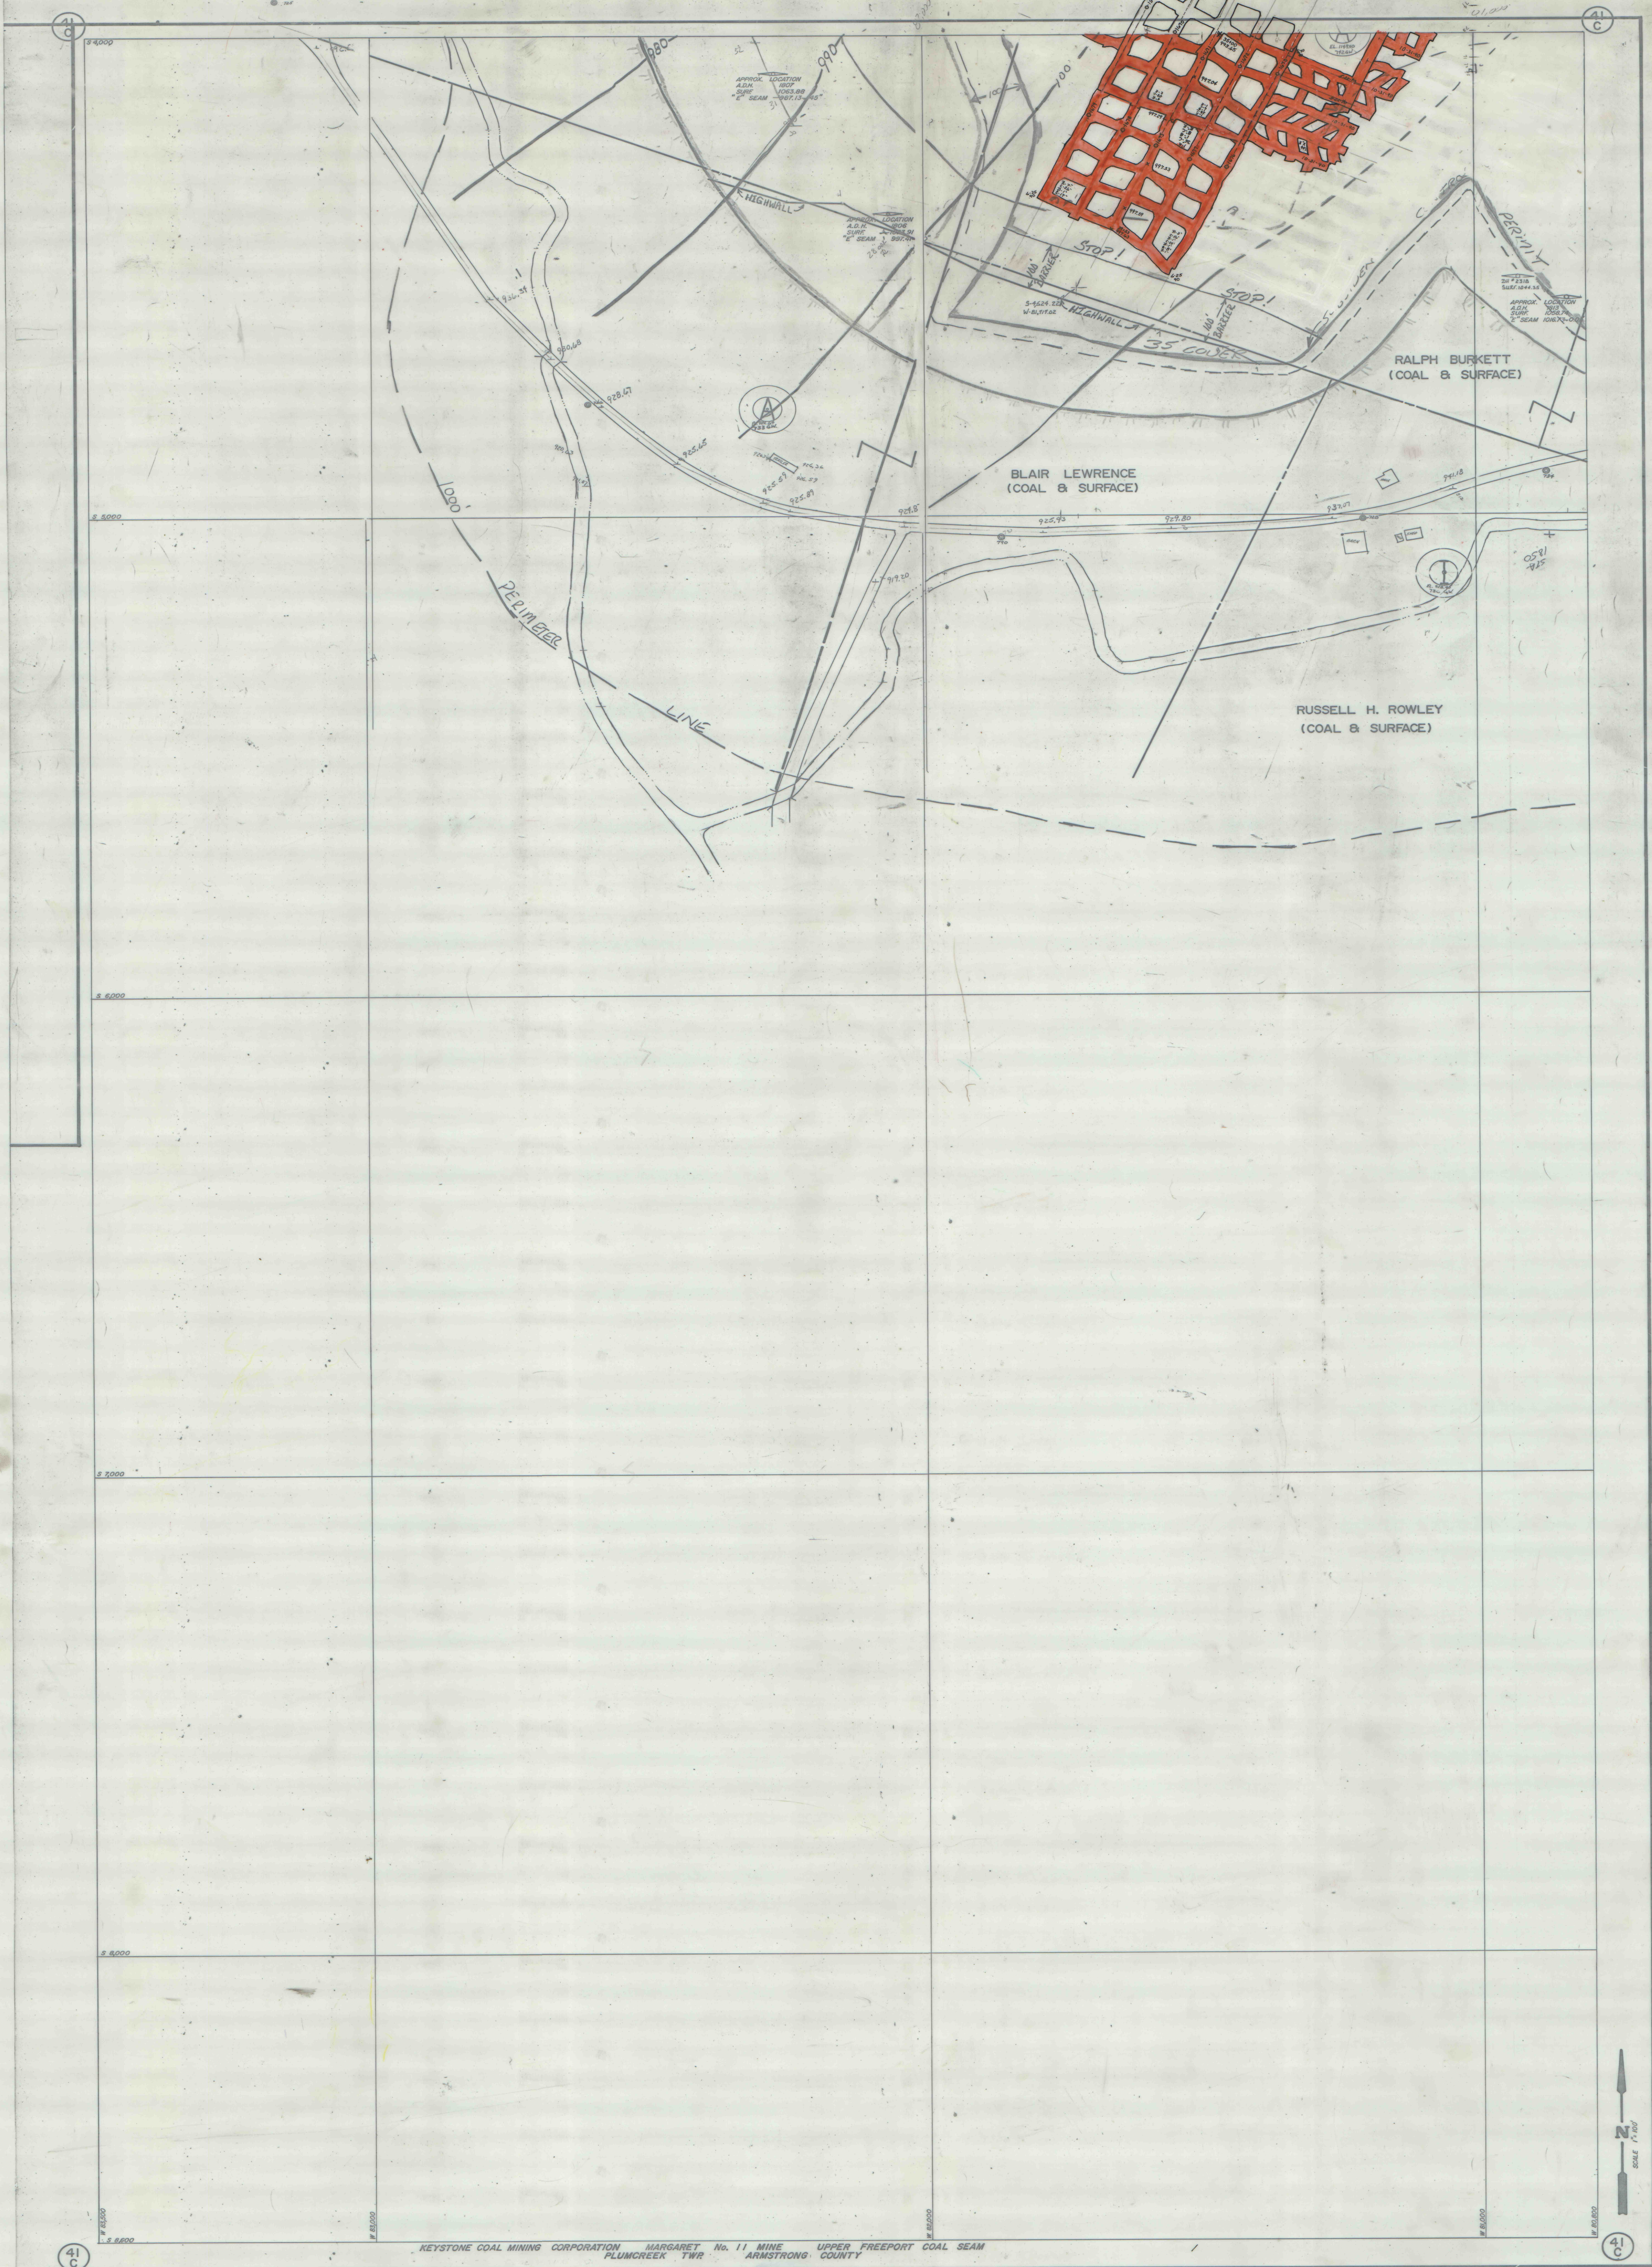

KEYSTONE COAL MINING CORPORATION MARGARET No. 11 MINE UPPER FREEPORT COAL SEAM
PLUMCREEK TWR ARMSTRONG COUNTY

IMAPS# 14327