


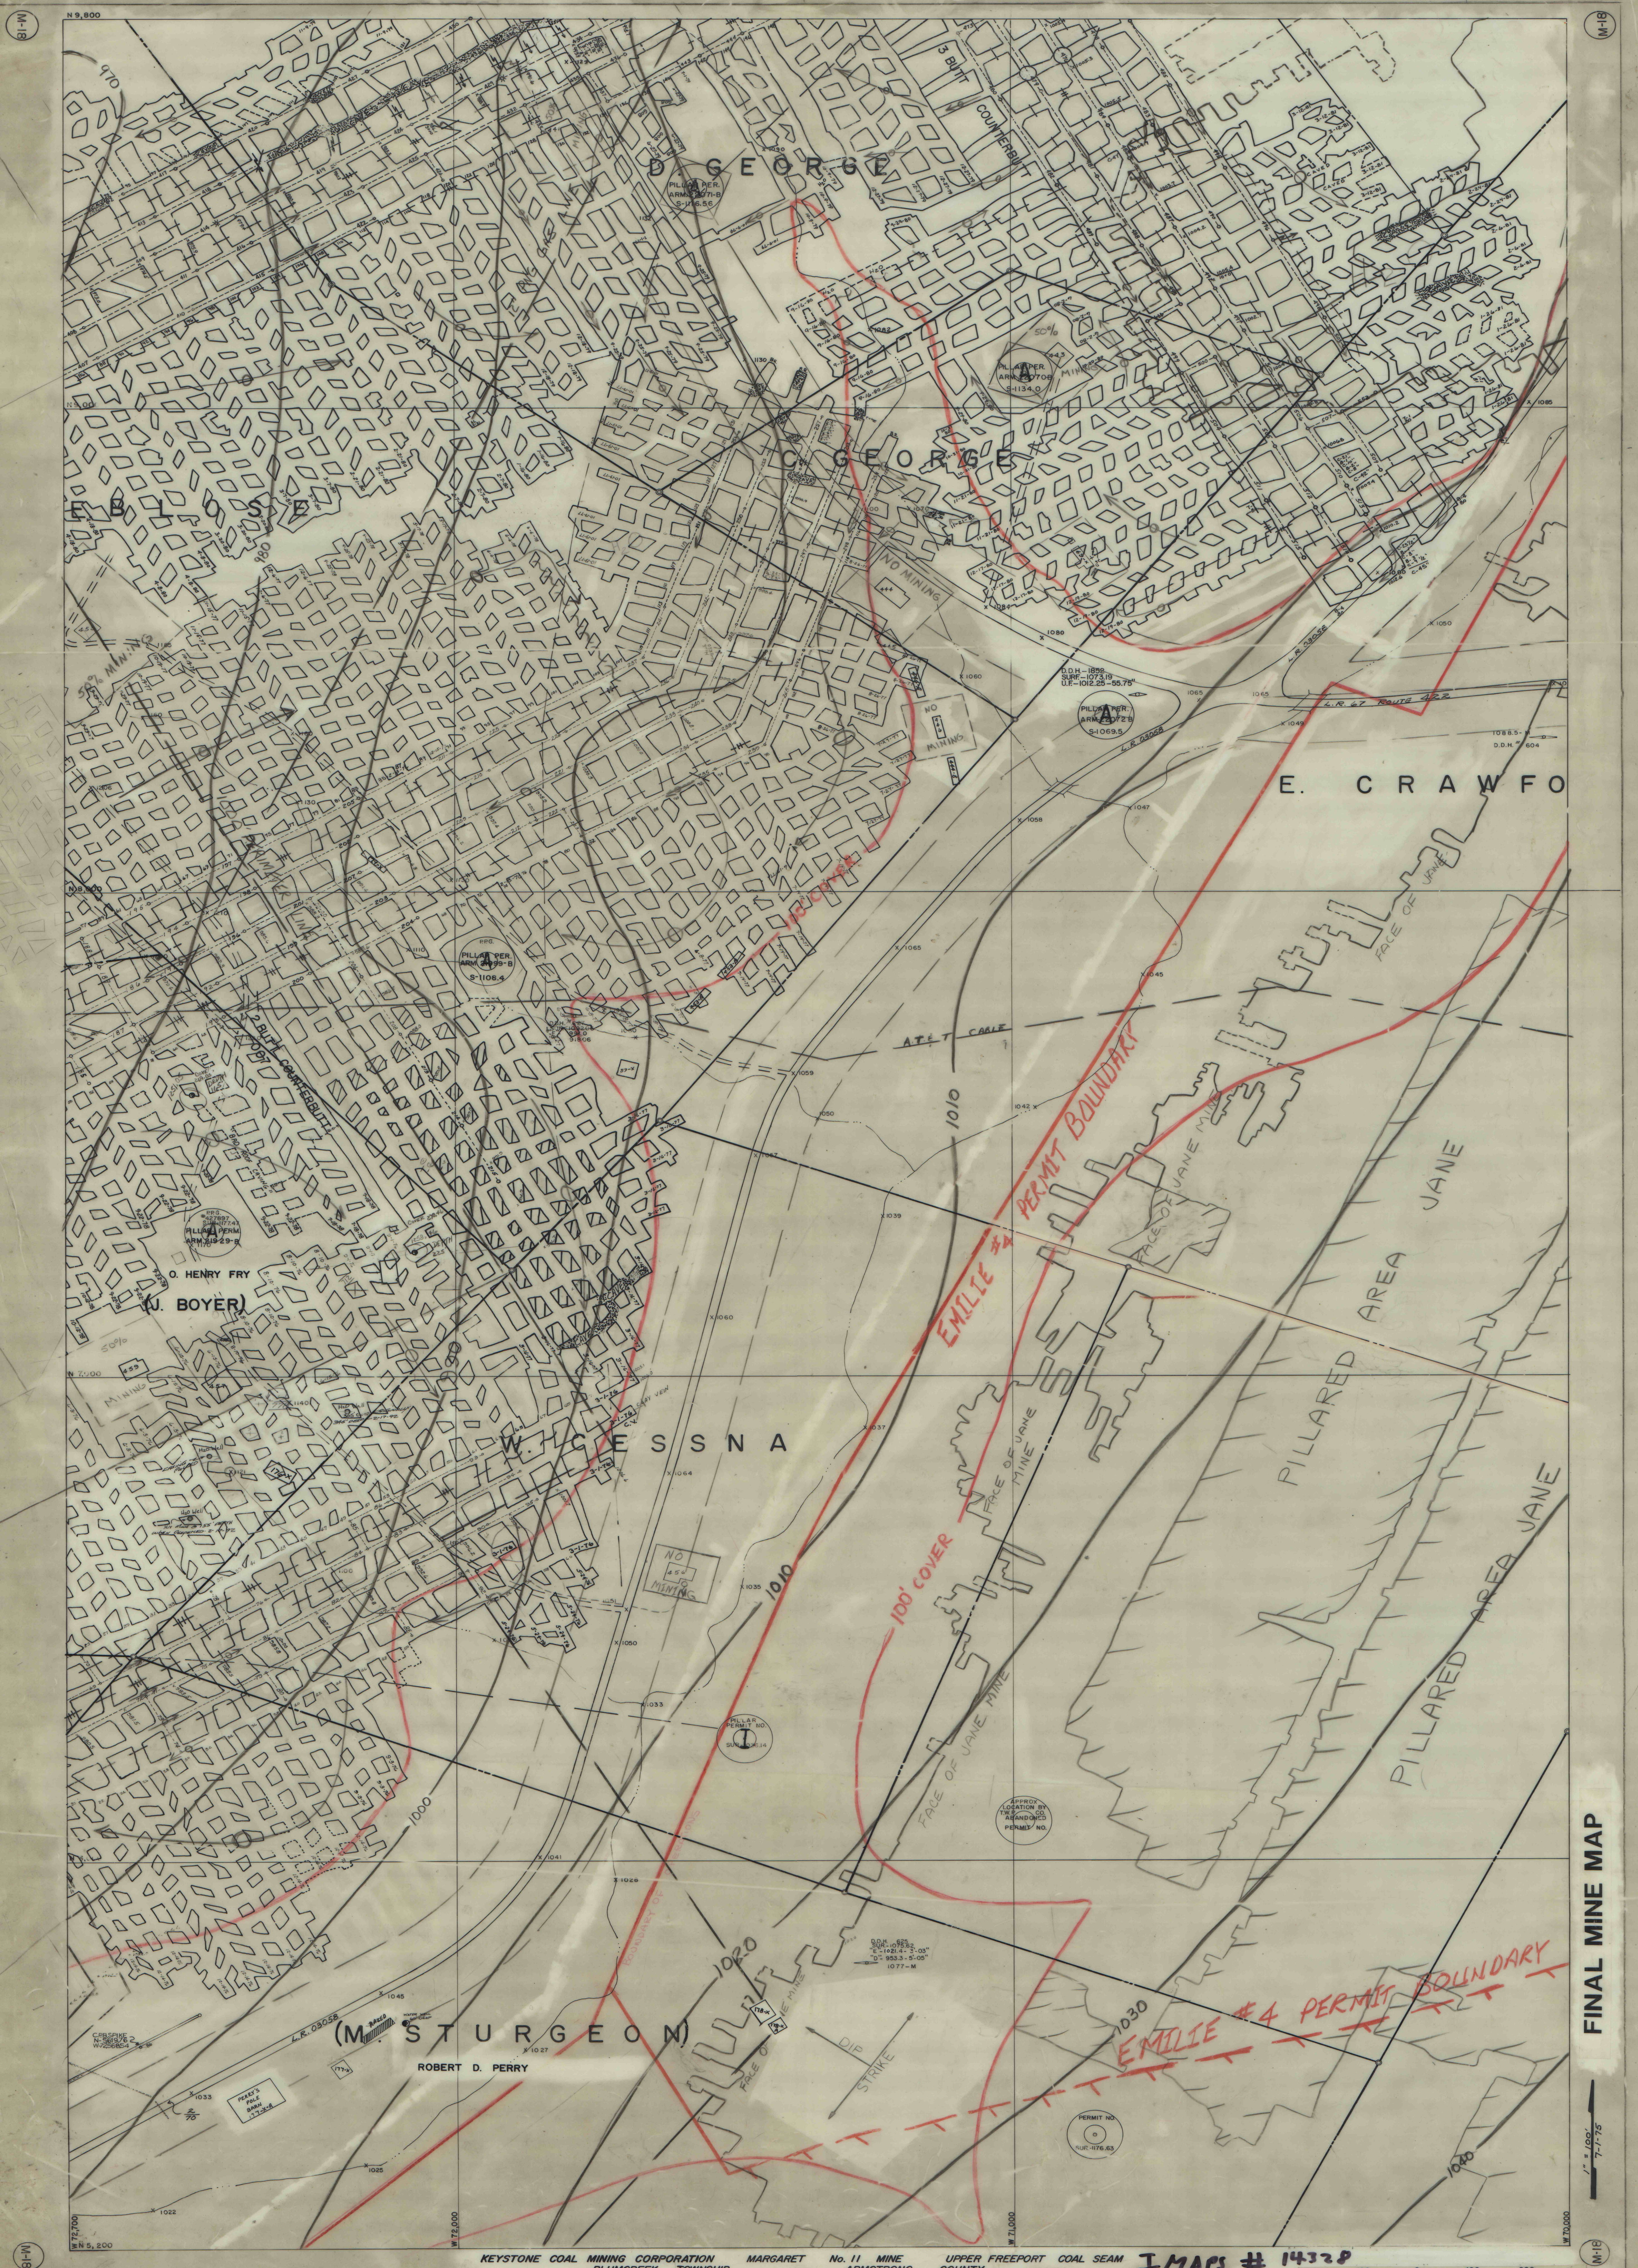

FINAL MINE MAP