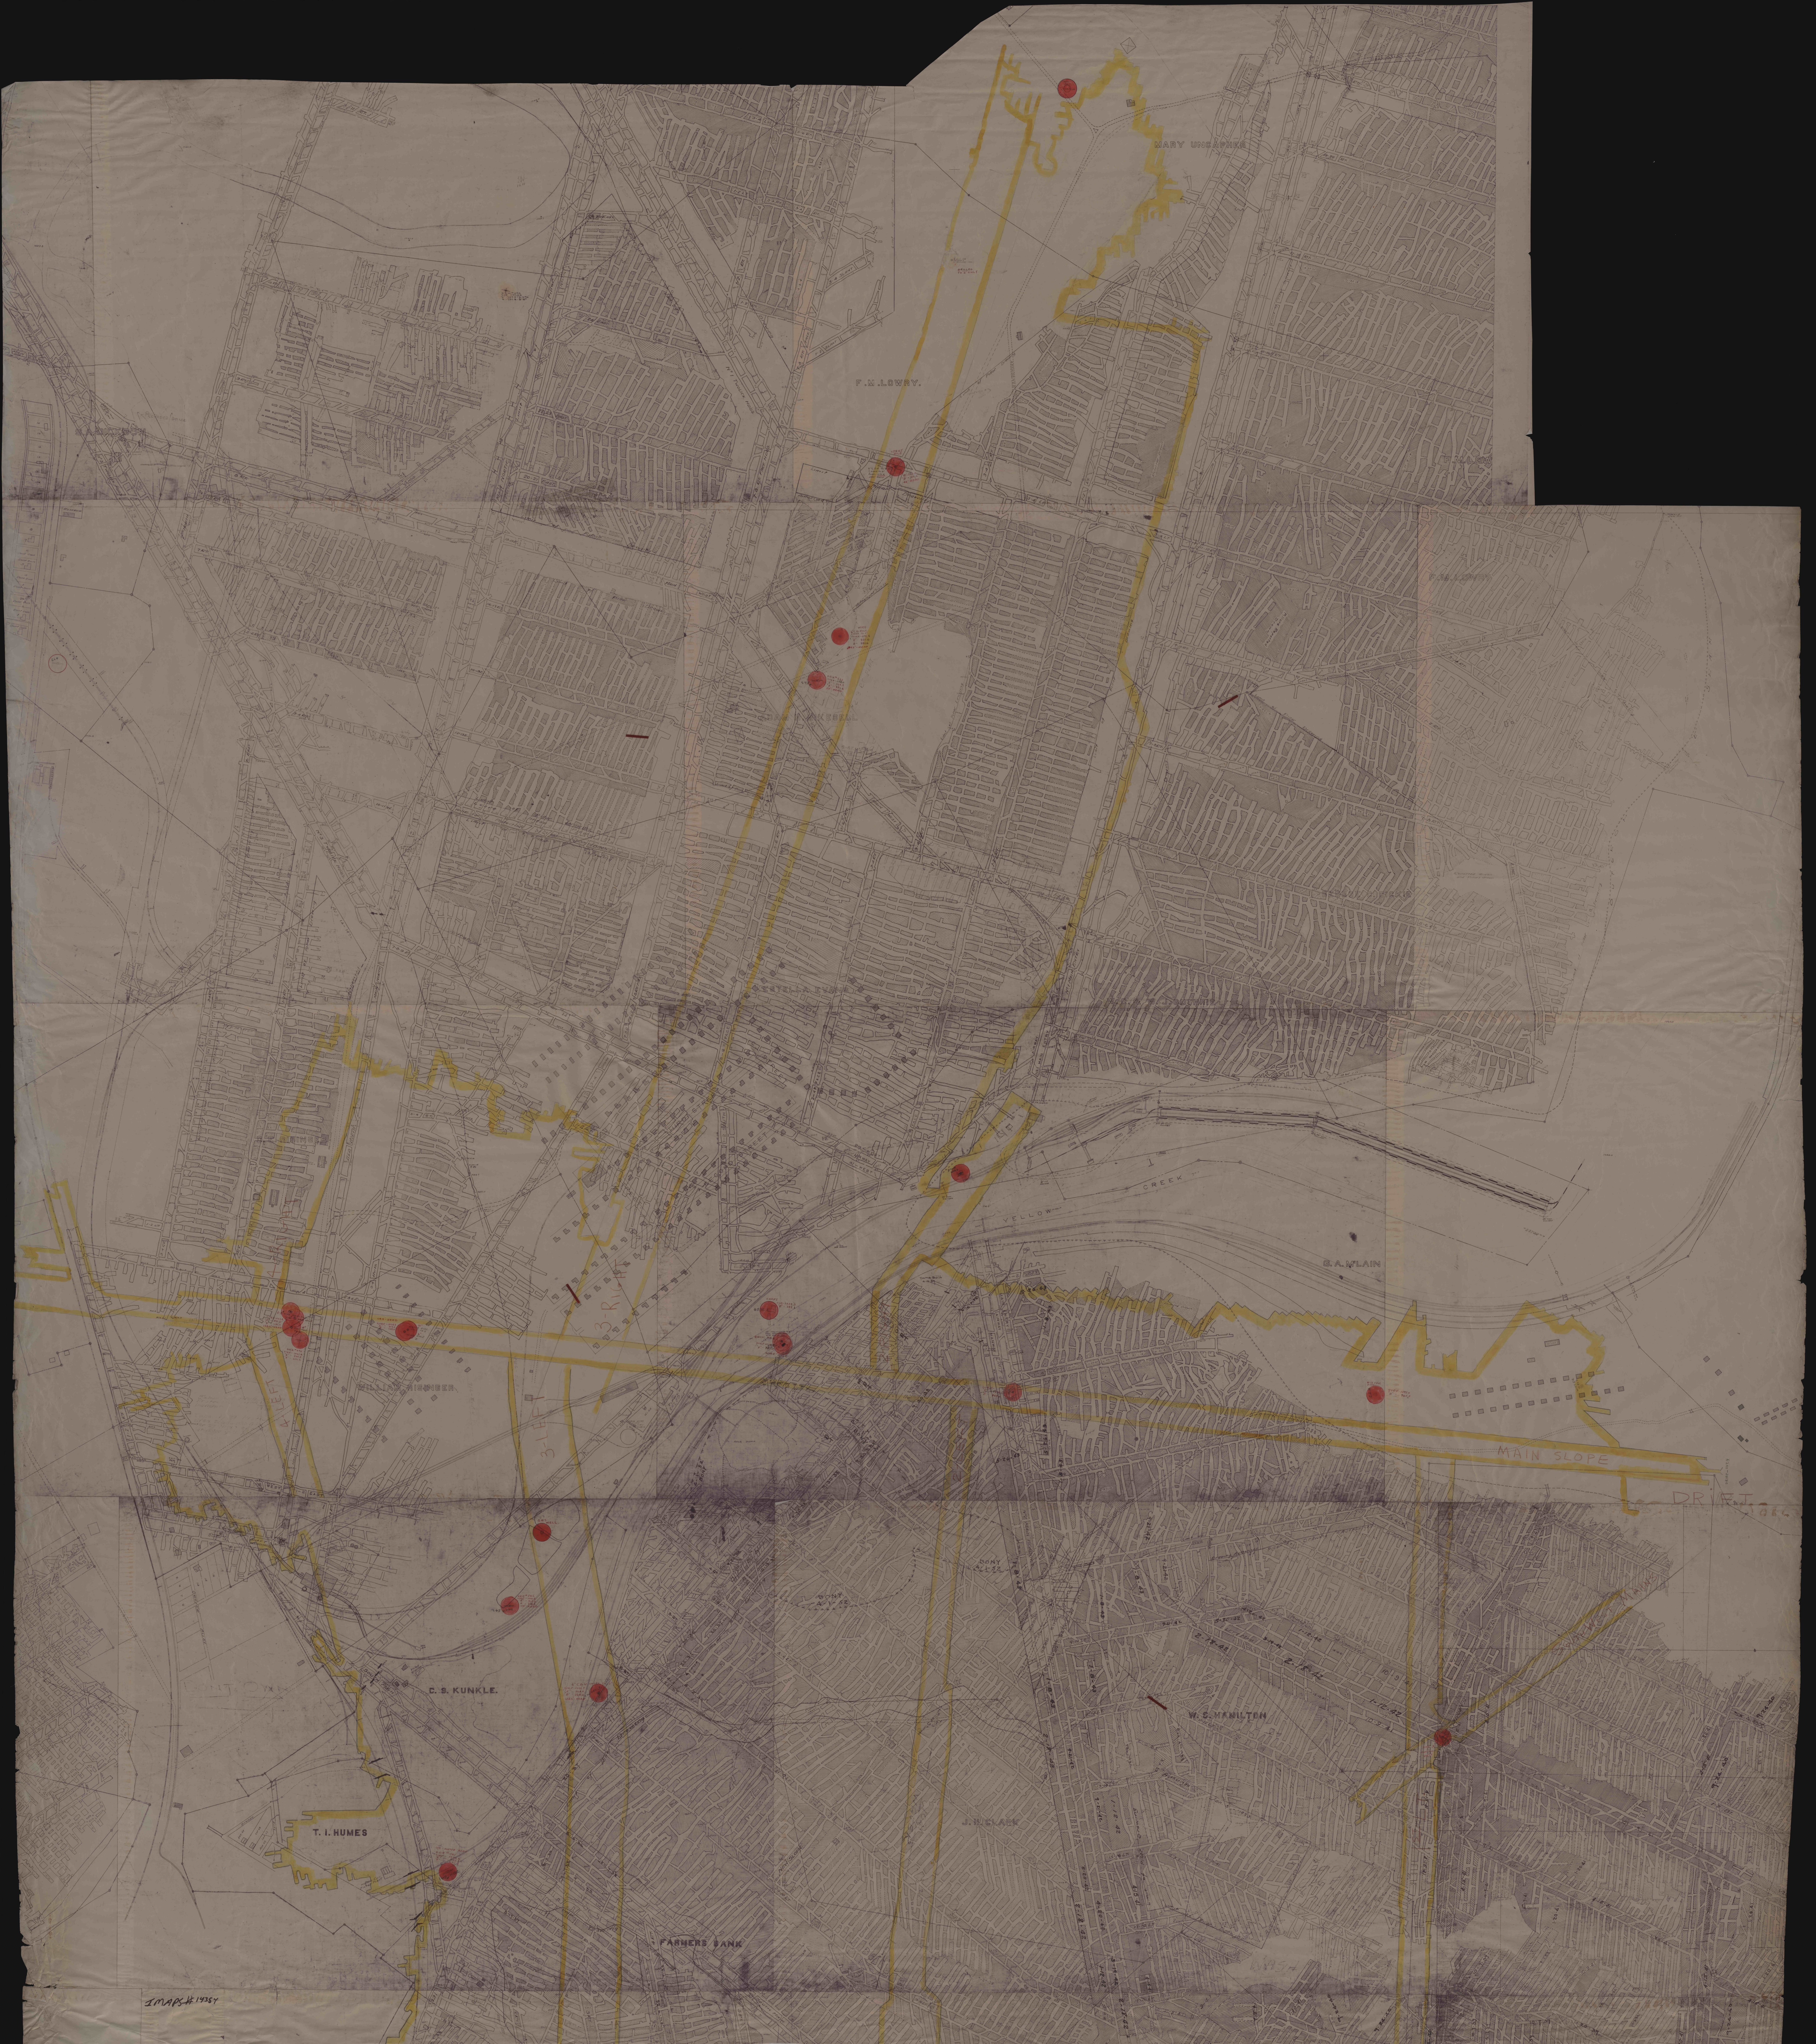
MARY UNCAPHER
Gas Well Not Active
F. M. LOWRY.
3-4 SLANT
1-2 SLANT
7-8 RT. FACE
SPRAY HOLE
6" C.D.H. To "B" VN. CASED To 3" SURF- 1171.4 380' DEEP
E-982.0
"B"-782.0
46'-HEAD
DRILLED TO "E" ONLY
Limit of Authorized Pillar Drawing
WILLIAM RISINGER
4-LEFT
3-LEFT
119.5'-HEAD
SURF-1074.9
"E"-909.0
"B"-709.0
12" WATER DISC. HOLE TO "B"
6" WIRE HOLE TO "B"
2-8" WIRE HOLES TO "B"
6" WIRE HOLE
18" DISC. HOLE TO "B"
SURF-1062.8
"E"-893.0
"B"-693.0
135.5'-HEAD
D.D.H. #496
SURF-1061.4
"E"-888.8
"B"-691.2
MAIN AIRWAY
MAIN ENTRY
1-2 WEST
1-2 EAST
Garage
YELLOW CREEK
G. A. McLAIN
Reported Crown
WATER DISC.
C.D.H.
SURF-1097.0
"B"-965.0
MAIN SLOPE
WATER WELL
DRIFT-1117.9
DRIFT
C. S. KUNKLE.
SOUTH MAIN
PUMP STATION
D.D.H. #542
SURF-1031.8
110' HEAD
6" C.D.H.
SURF-1031.9
"E"-924.0
"B"-724.0
104.5'-HEAD
T. I. HUMES
HOMER CITY FILTER PLANT
133' WATER HEAD
D.D.H. #541
SURF-1038.6
"E"-895.3
"B"-695.3
NEW SLOPE
FARMERS BANK
J. H. CLARK
W. S. HAMILTON
2-18-42
9-21-42
1-8-43

IMAPS #14354