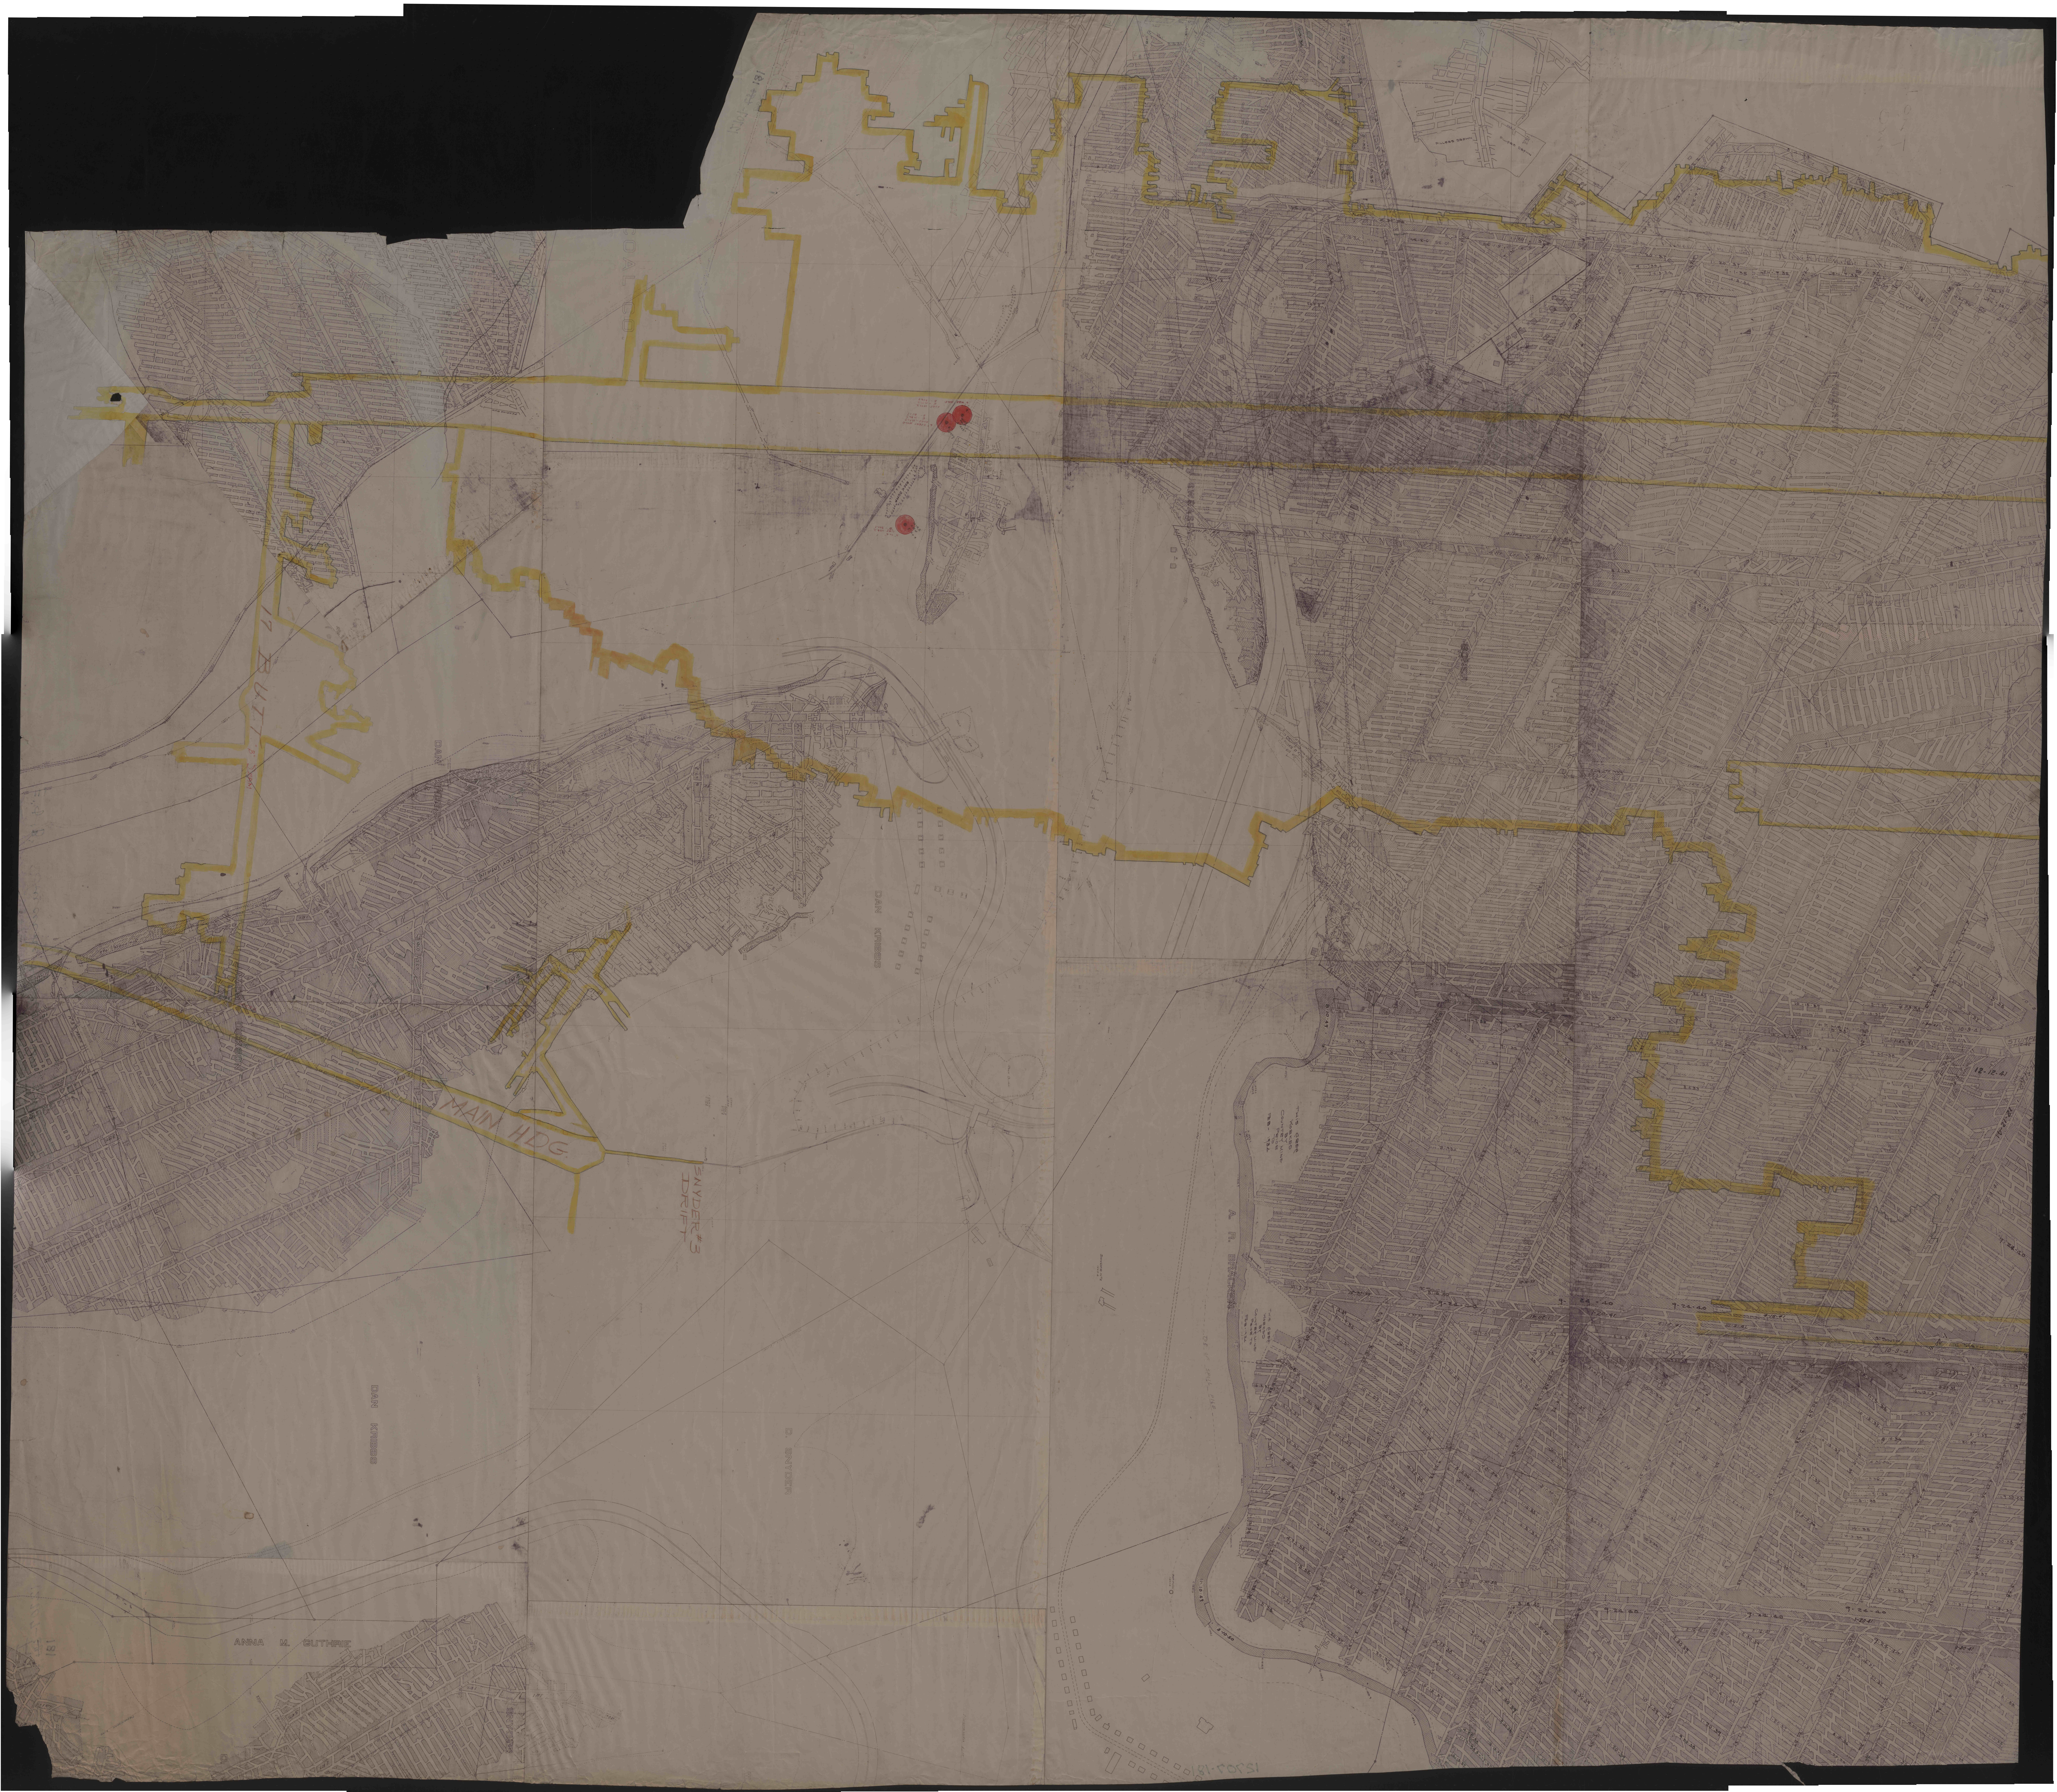
17 BUTT
"B" SEAM
MAIN HDG.
SNYDER #3 DRIFT
DAN KRIBBS
DAN KRIBBS
DAN KRIBBS
D. SNYDER
SNYDER
ANNA M. GUTHRIE
A. R. BRACKEN
THIS AREA WORKED BY COUNTRY MINE PRIOR TO FEB - 1934
THIS AREA WORKED BY COUNTRY MINE PRIOR TO FEB - 1934
TOE OF SPOIL PILE
ROCK DUMP
ROCK DUMP
STRIPPED
MAIN