


5064 P 00465
IMM 14365

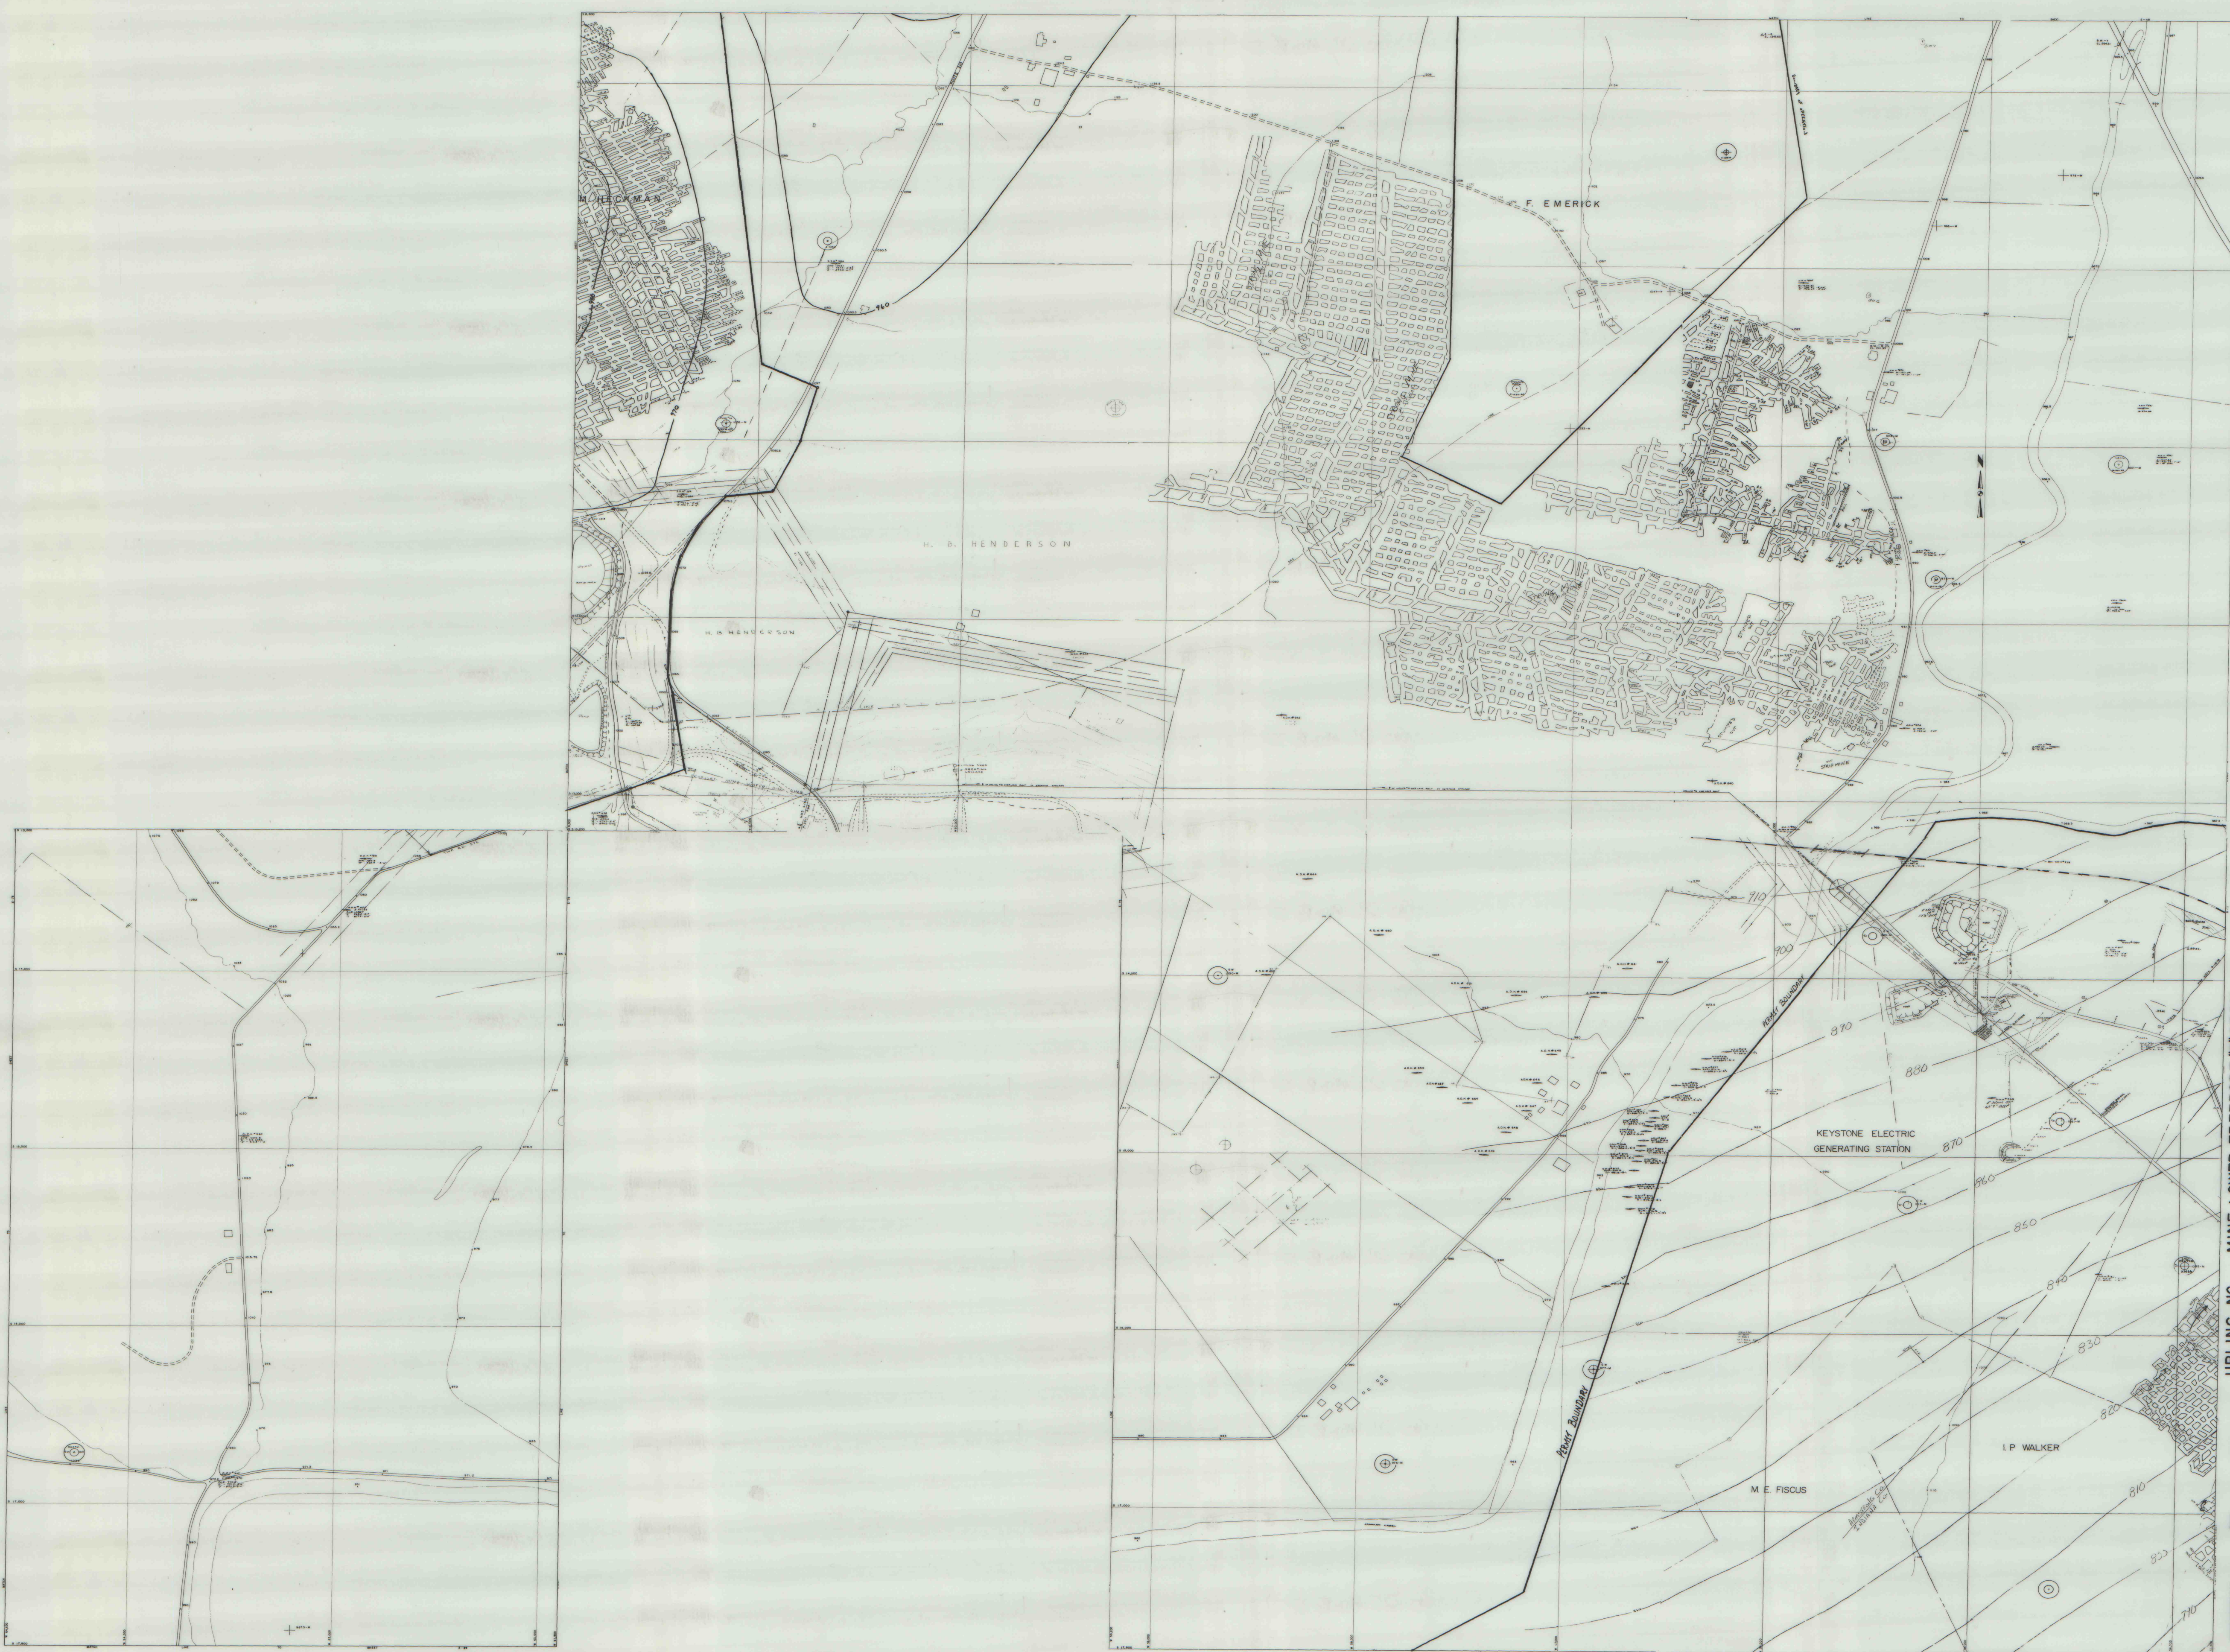

URLING NO. MINE LOWER FREEPORT 'D' SEAM
KEYSTONE COAL MINING CORP.
INDIANA CO.

