


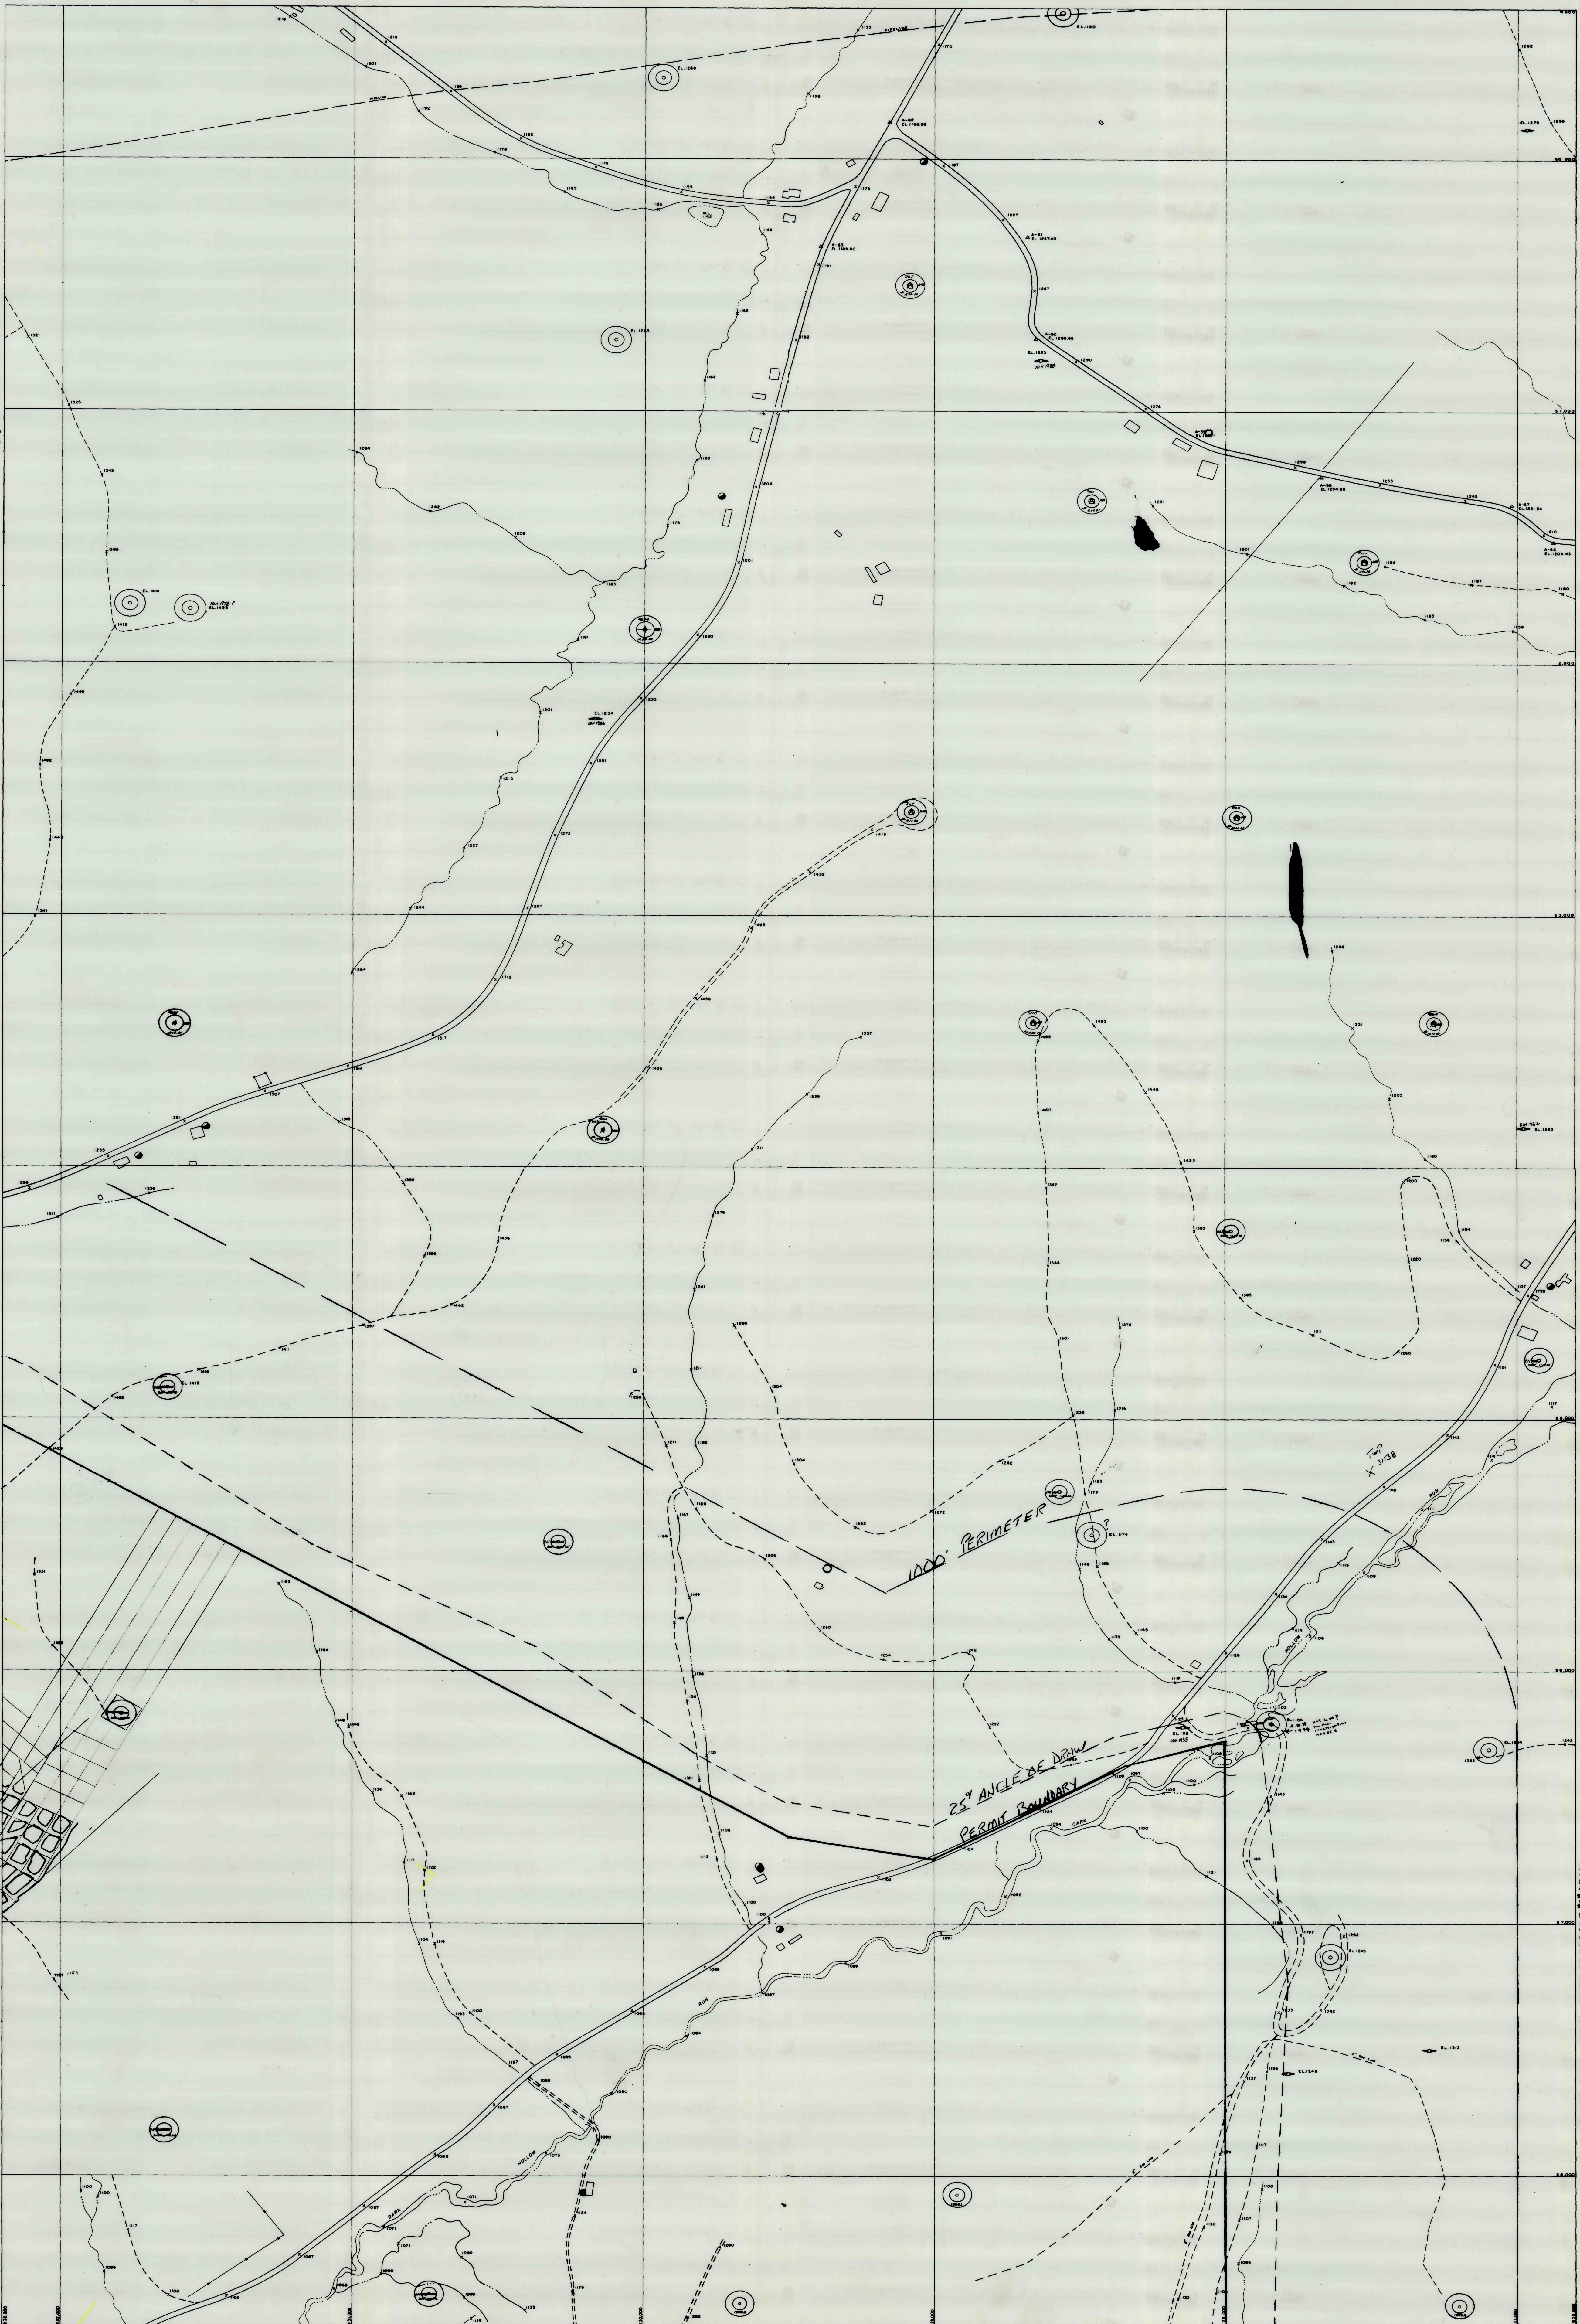

URLING NO. 1 MINE LOWER FREEPORT SEAM
KEYSTONE COAL MINING CORP.
INDIANA CO.

SPR 14383

