


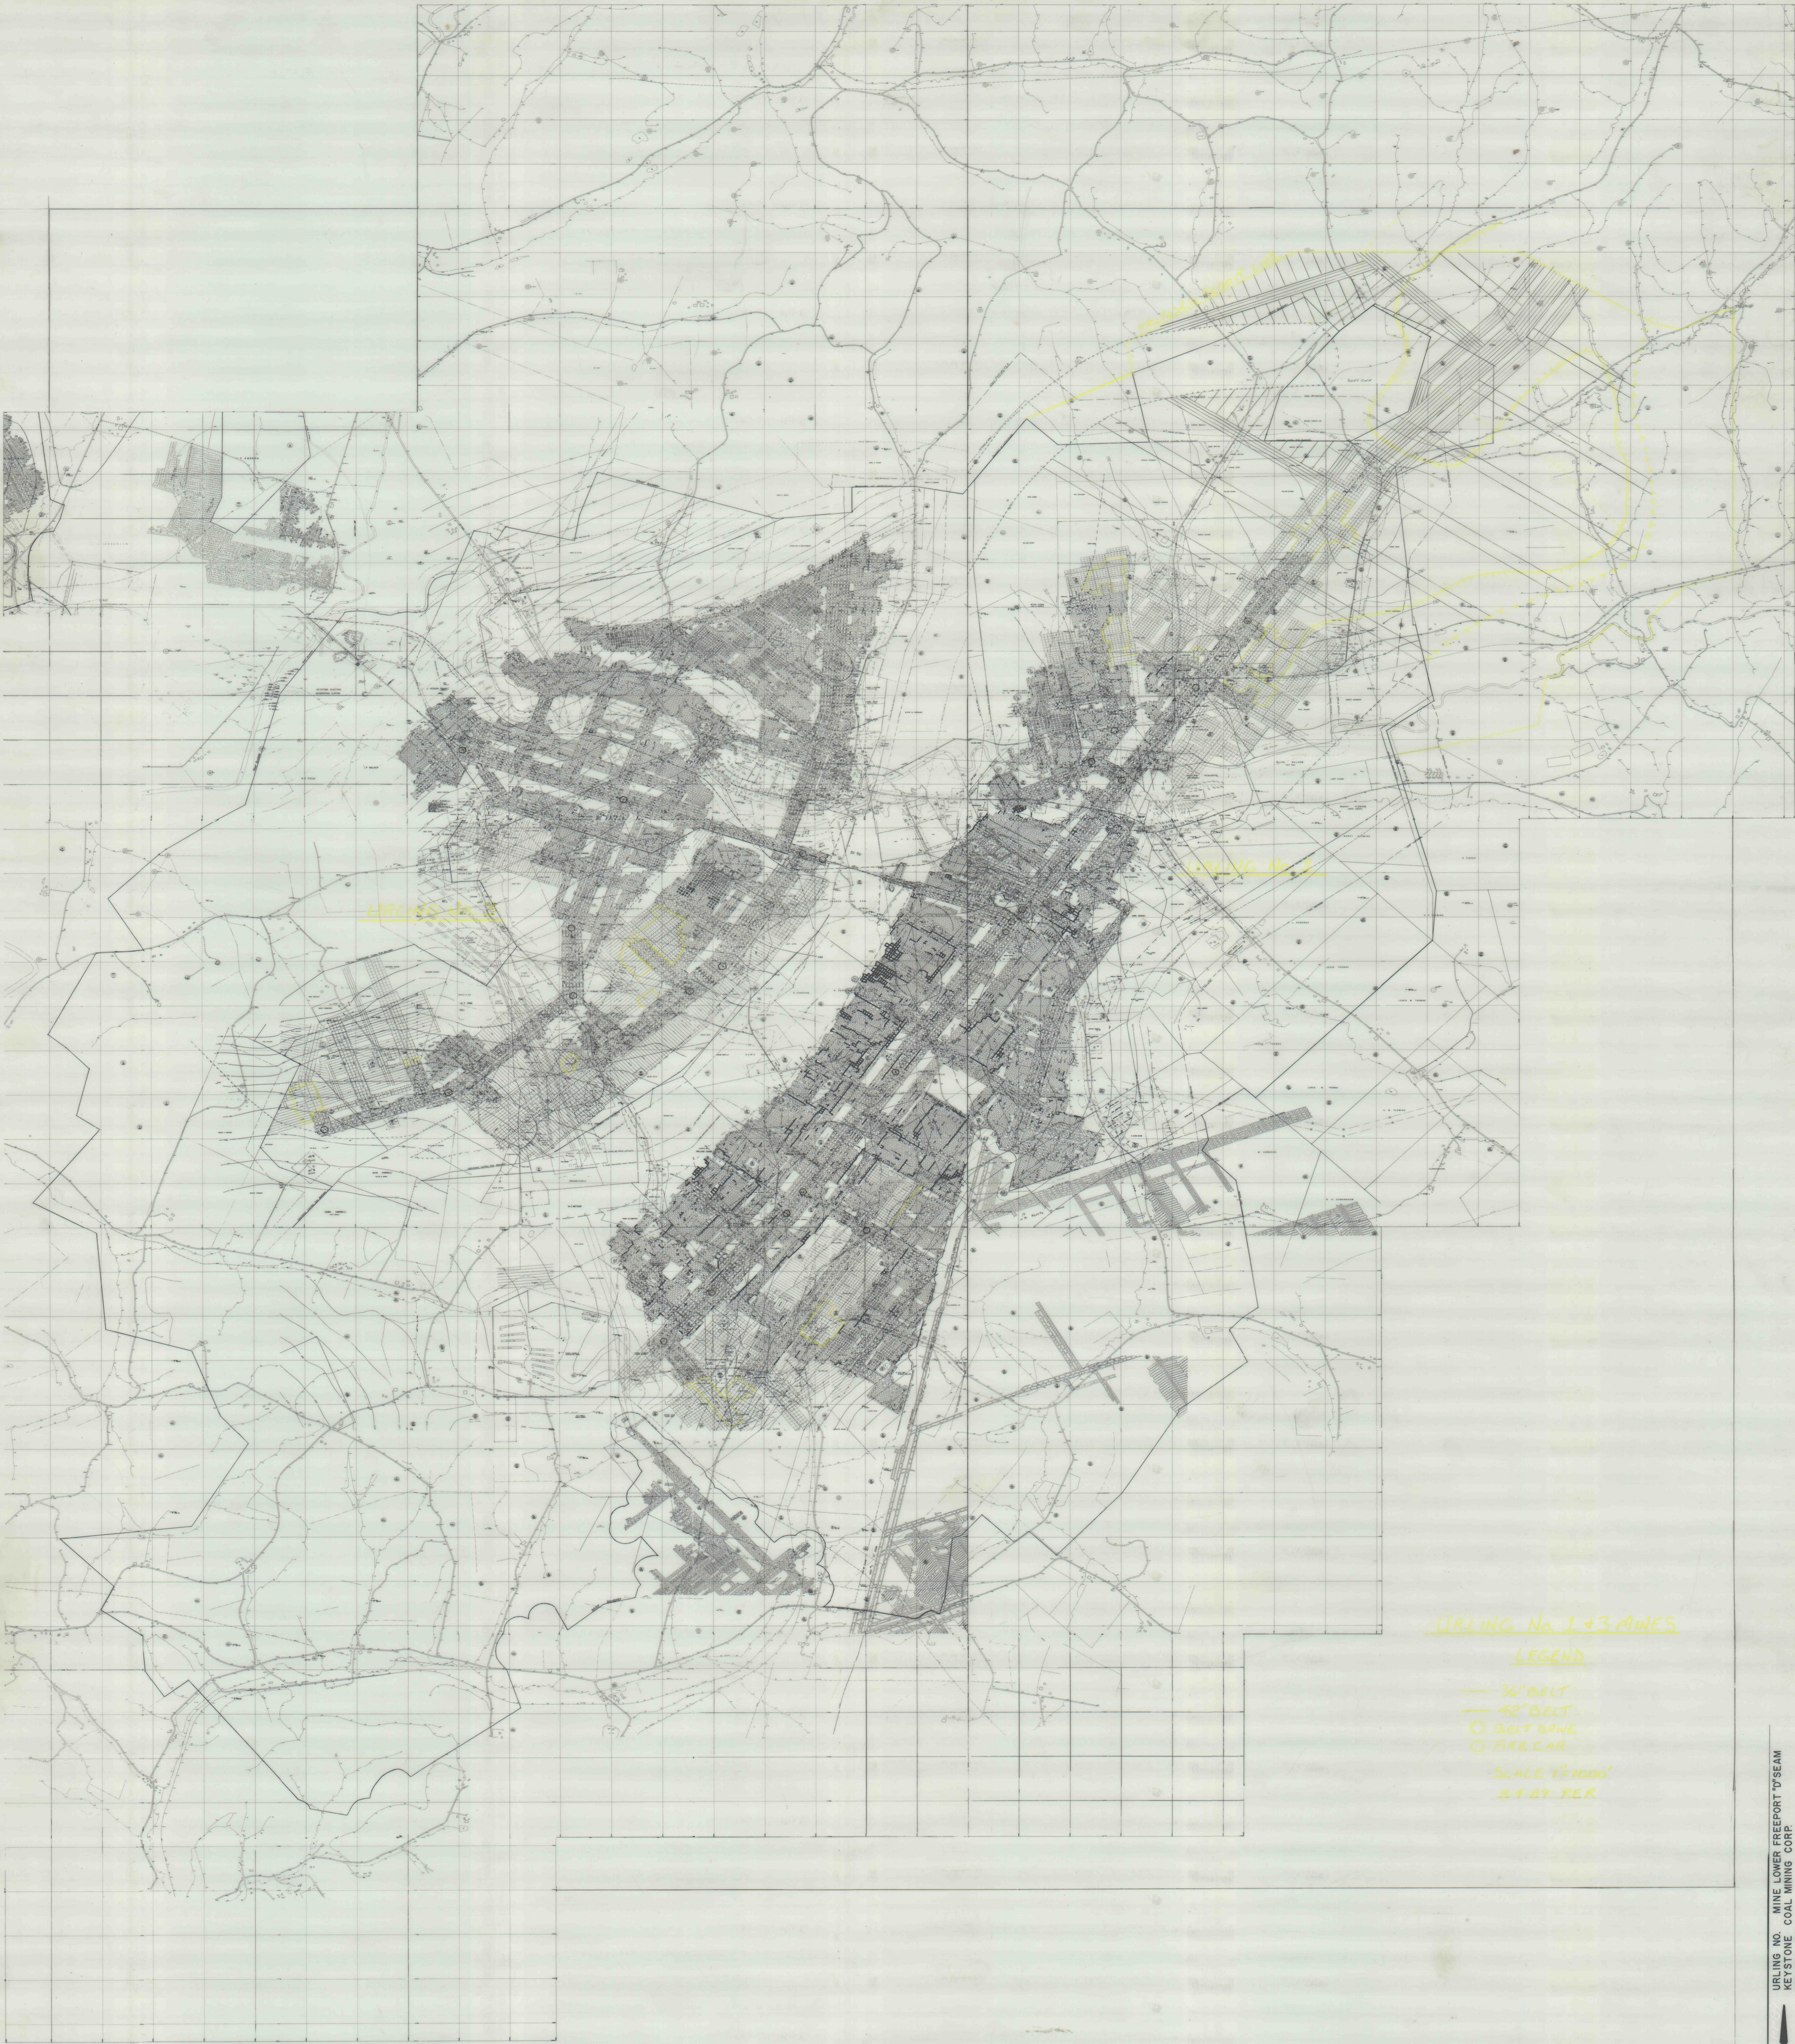

IMMS # 14374

URLING NO. 1+3 MINE LOWER FREEPORT D'SEAM
KEYSTONE COAL MINING CORP.
INDIANA CO.

