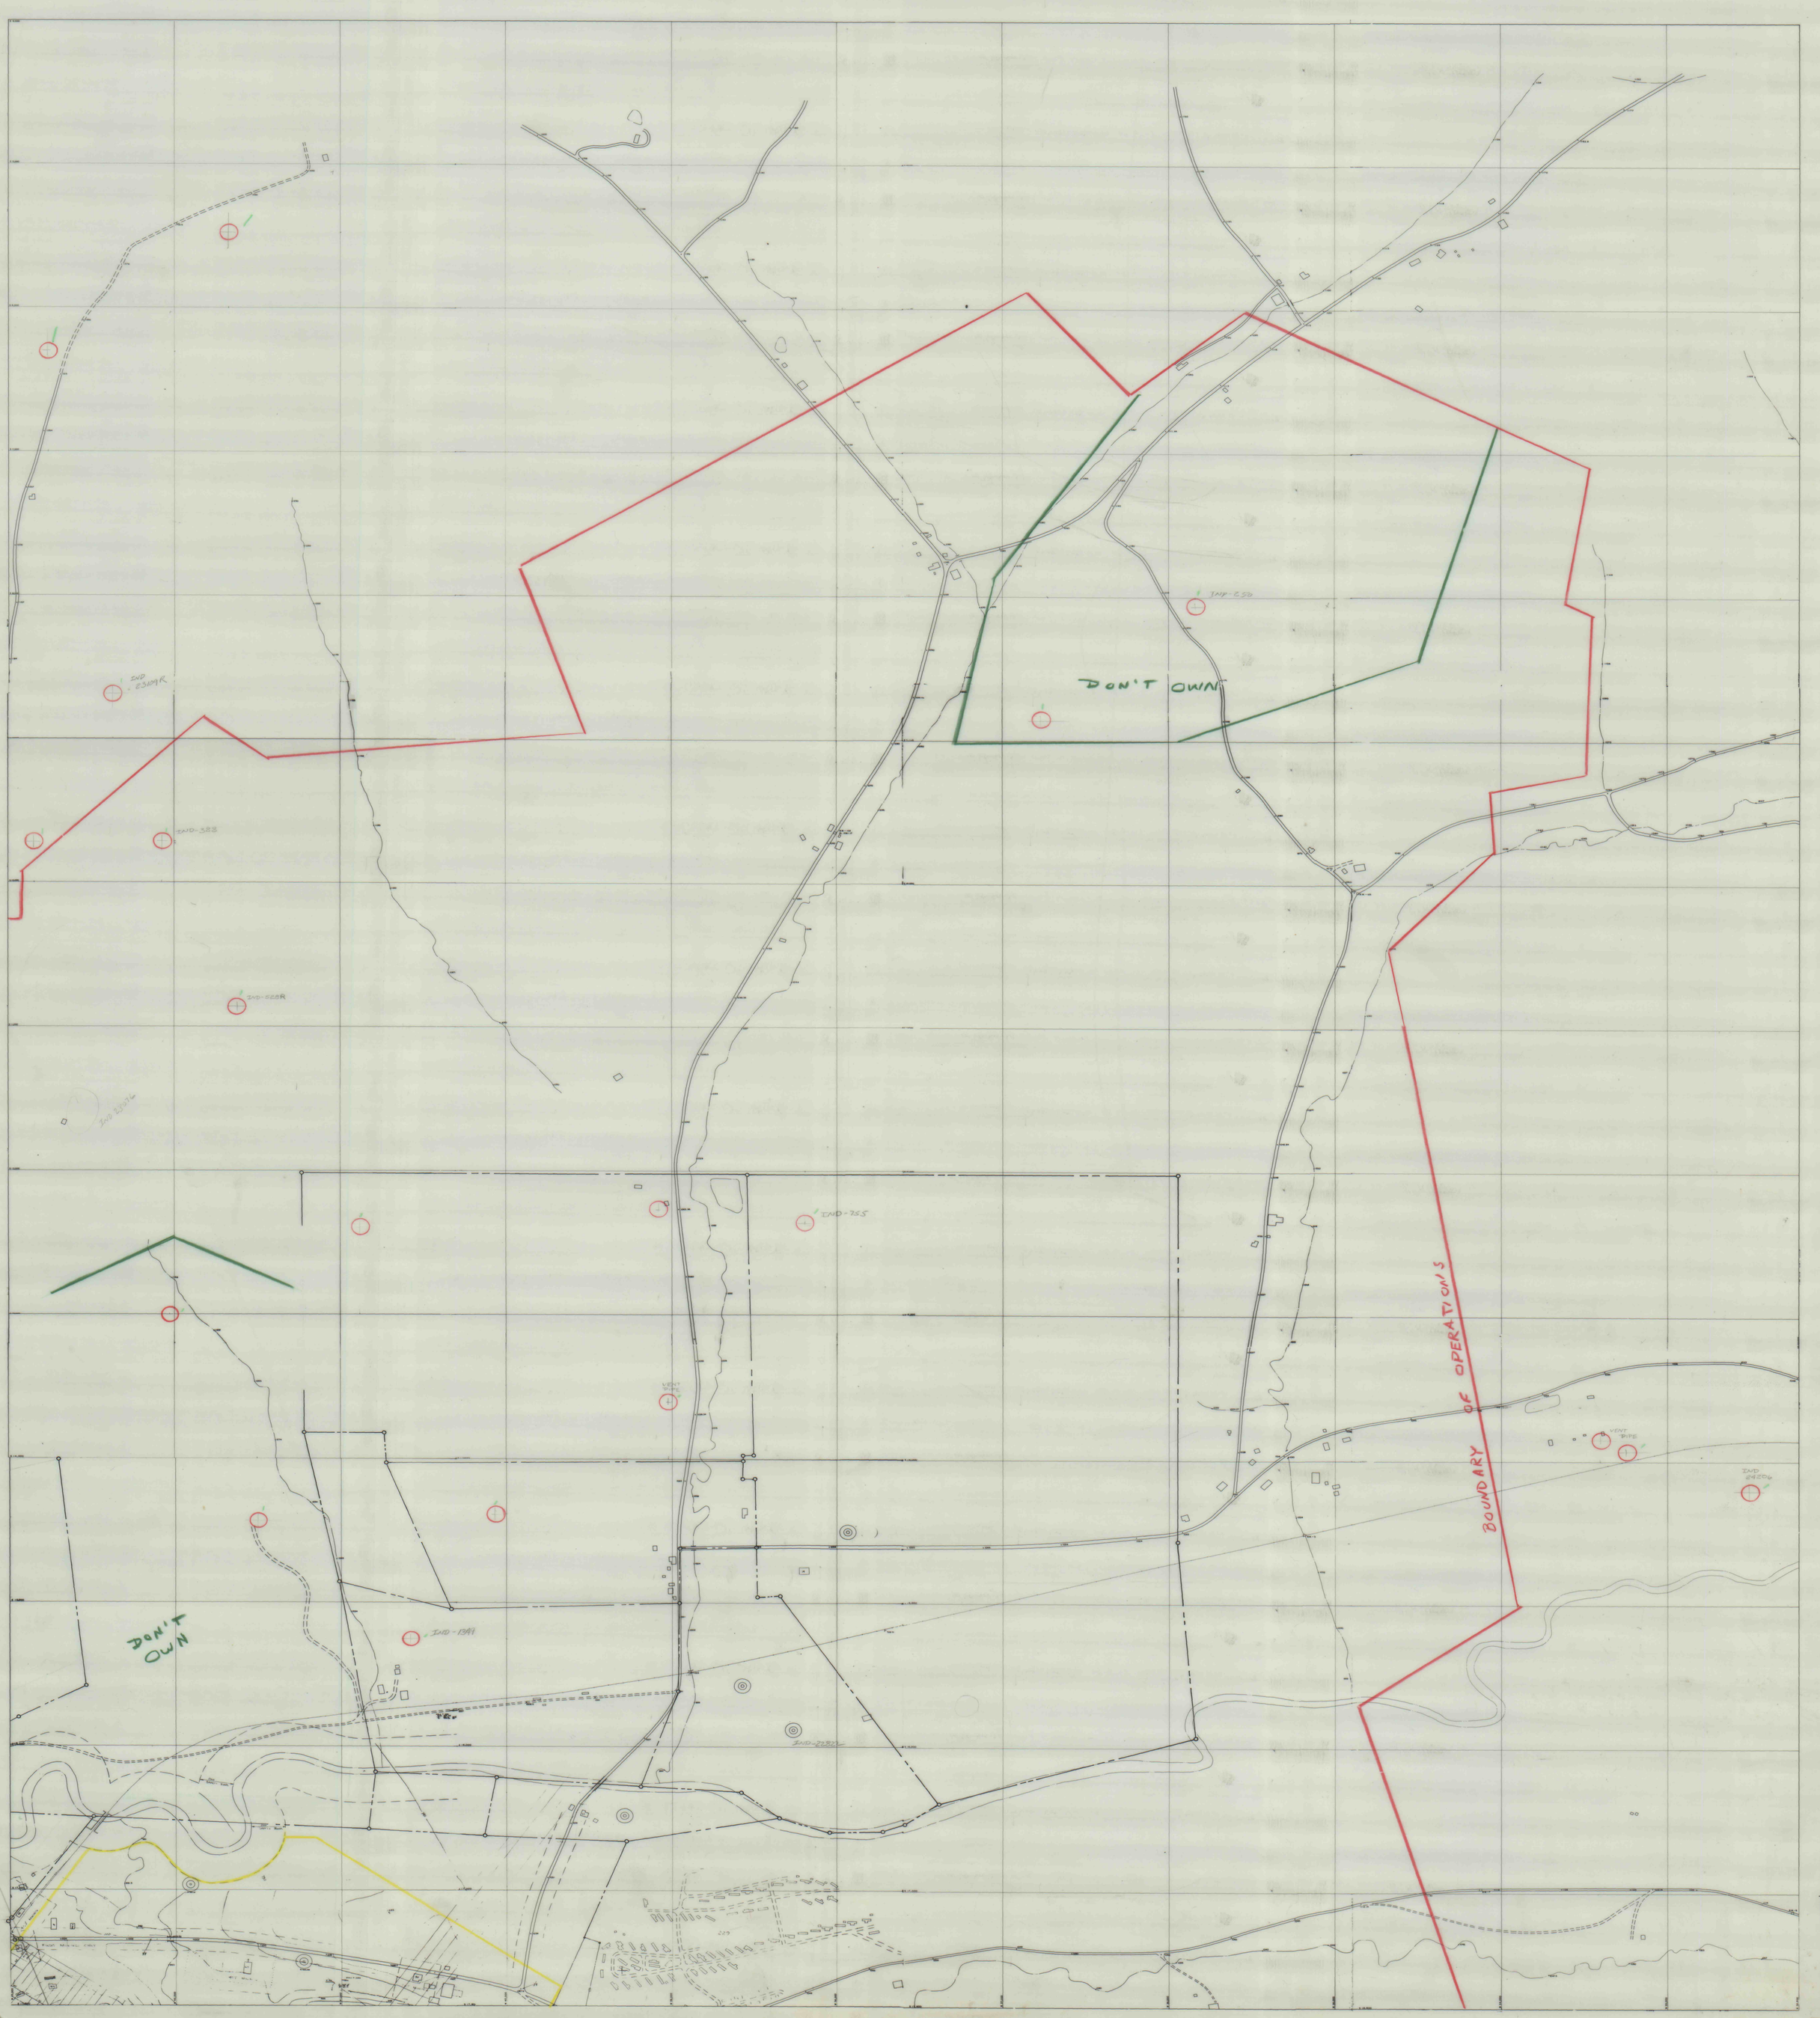

IMAPS # 14389

URLING NO. 1 & NO. 3 MINES
LOWER FREEPORT - "D" SEAM