


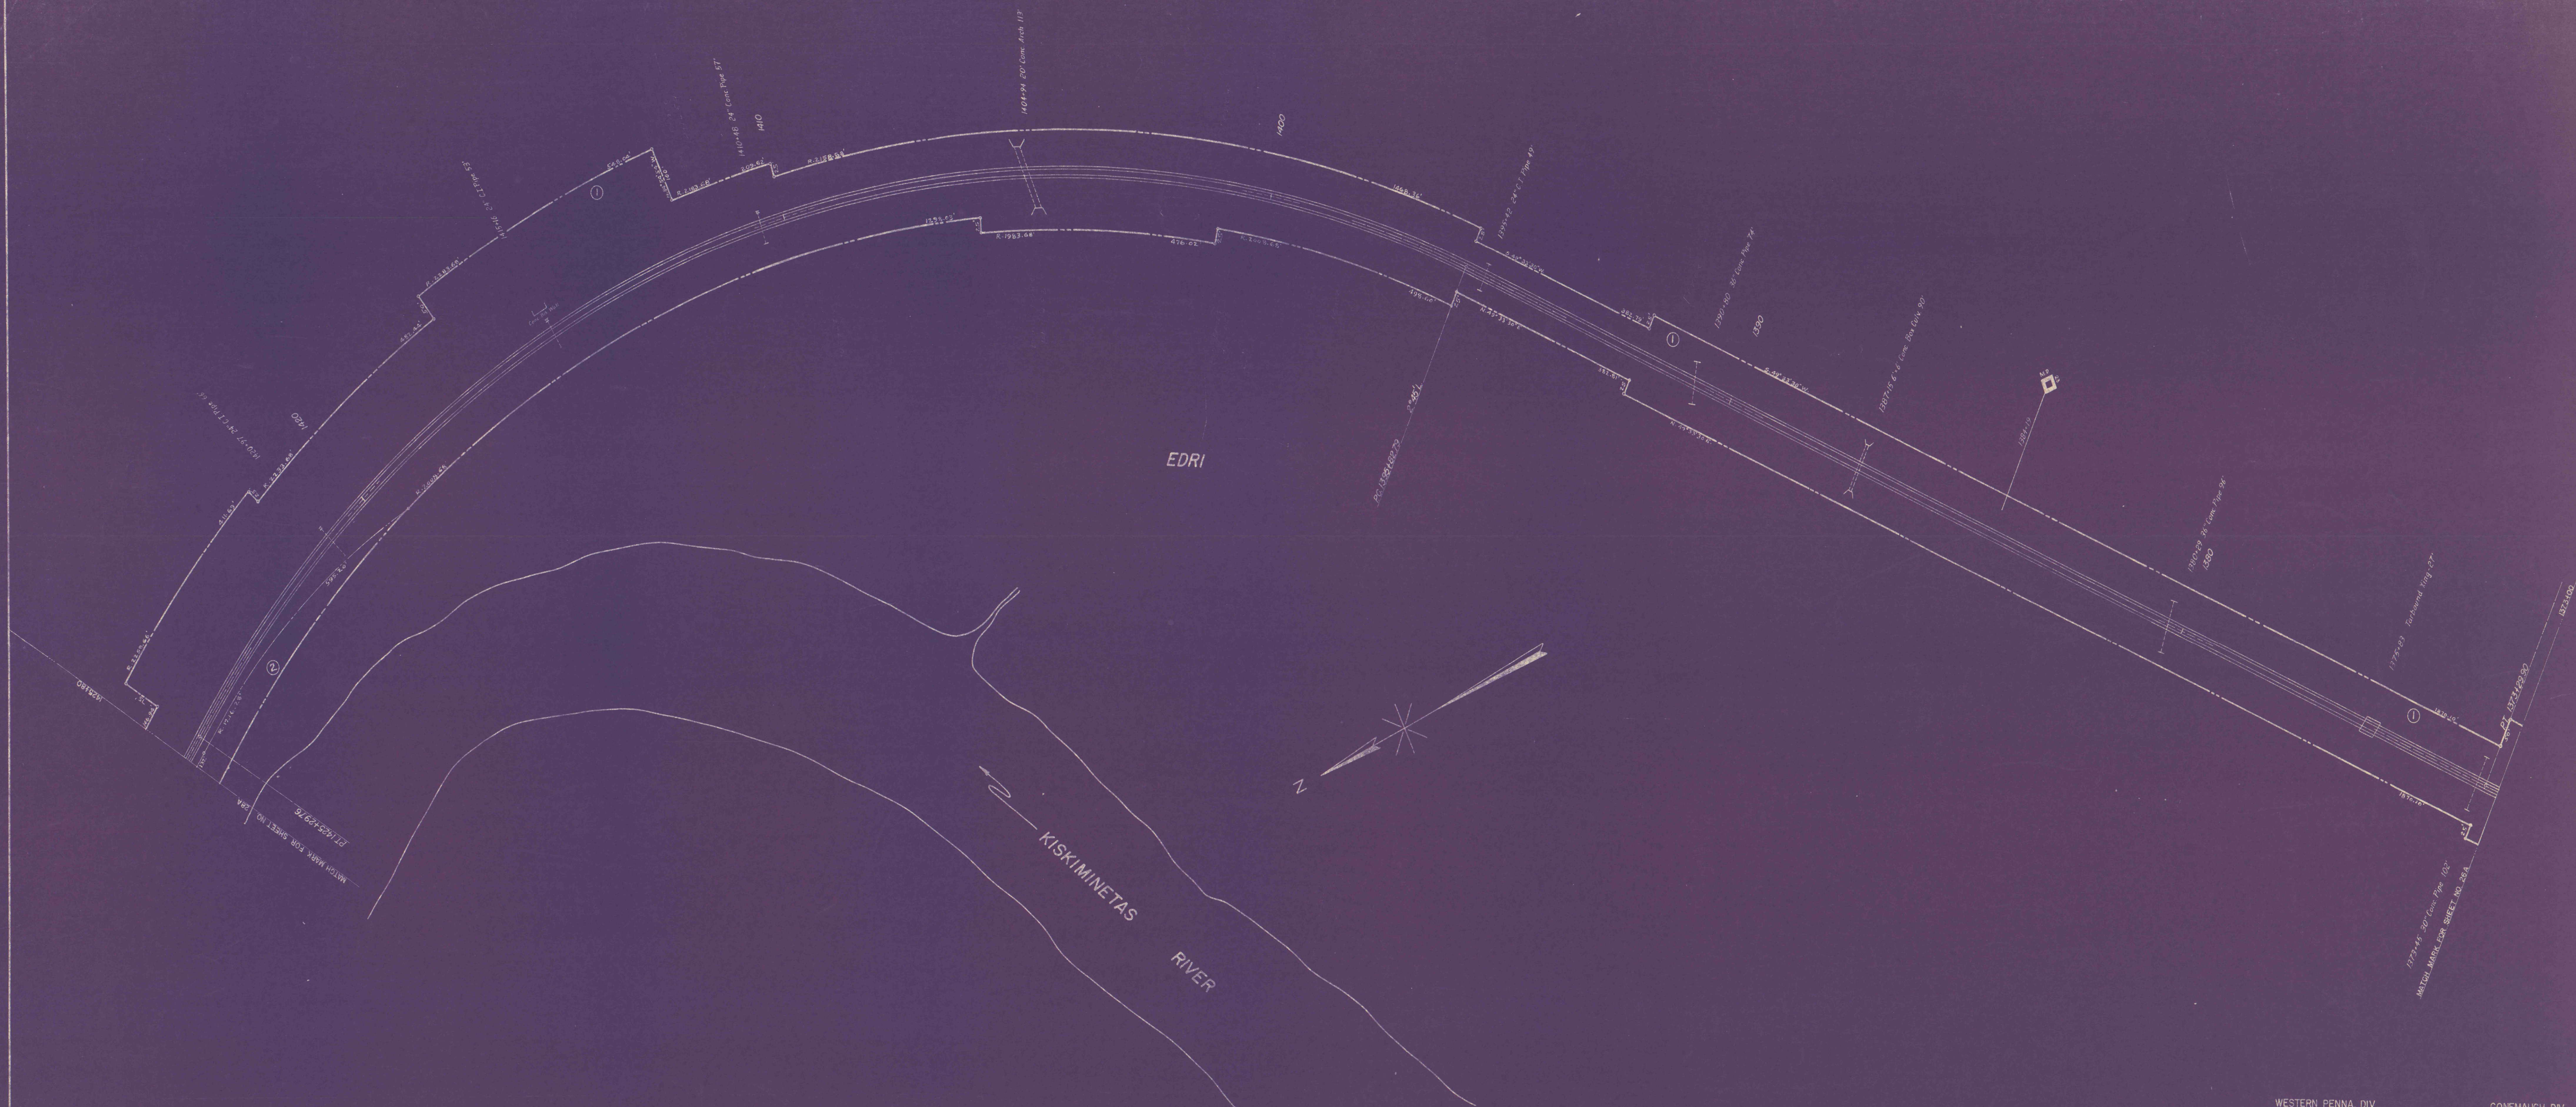

Correct as of Dec. 31st, 1955-10	Revision 5

WESTERN PENNA. DIV. CONEMAUGH DIV.

RIGHT OF WAY AND TRACK MAP

PENNSYLVANIA RAILROAD

STATION 1373+00 TO STATION 1425+80

SCALE 1"=100' JUNE 30, 1958

OFFICE OF VALUATION ENGINEER

PHILADELPHIA, PA.