


CONEMAUGH TWP, INDIANA CO., PA.

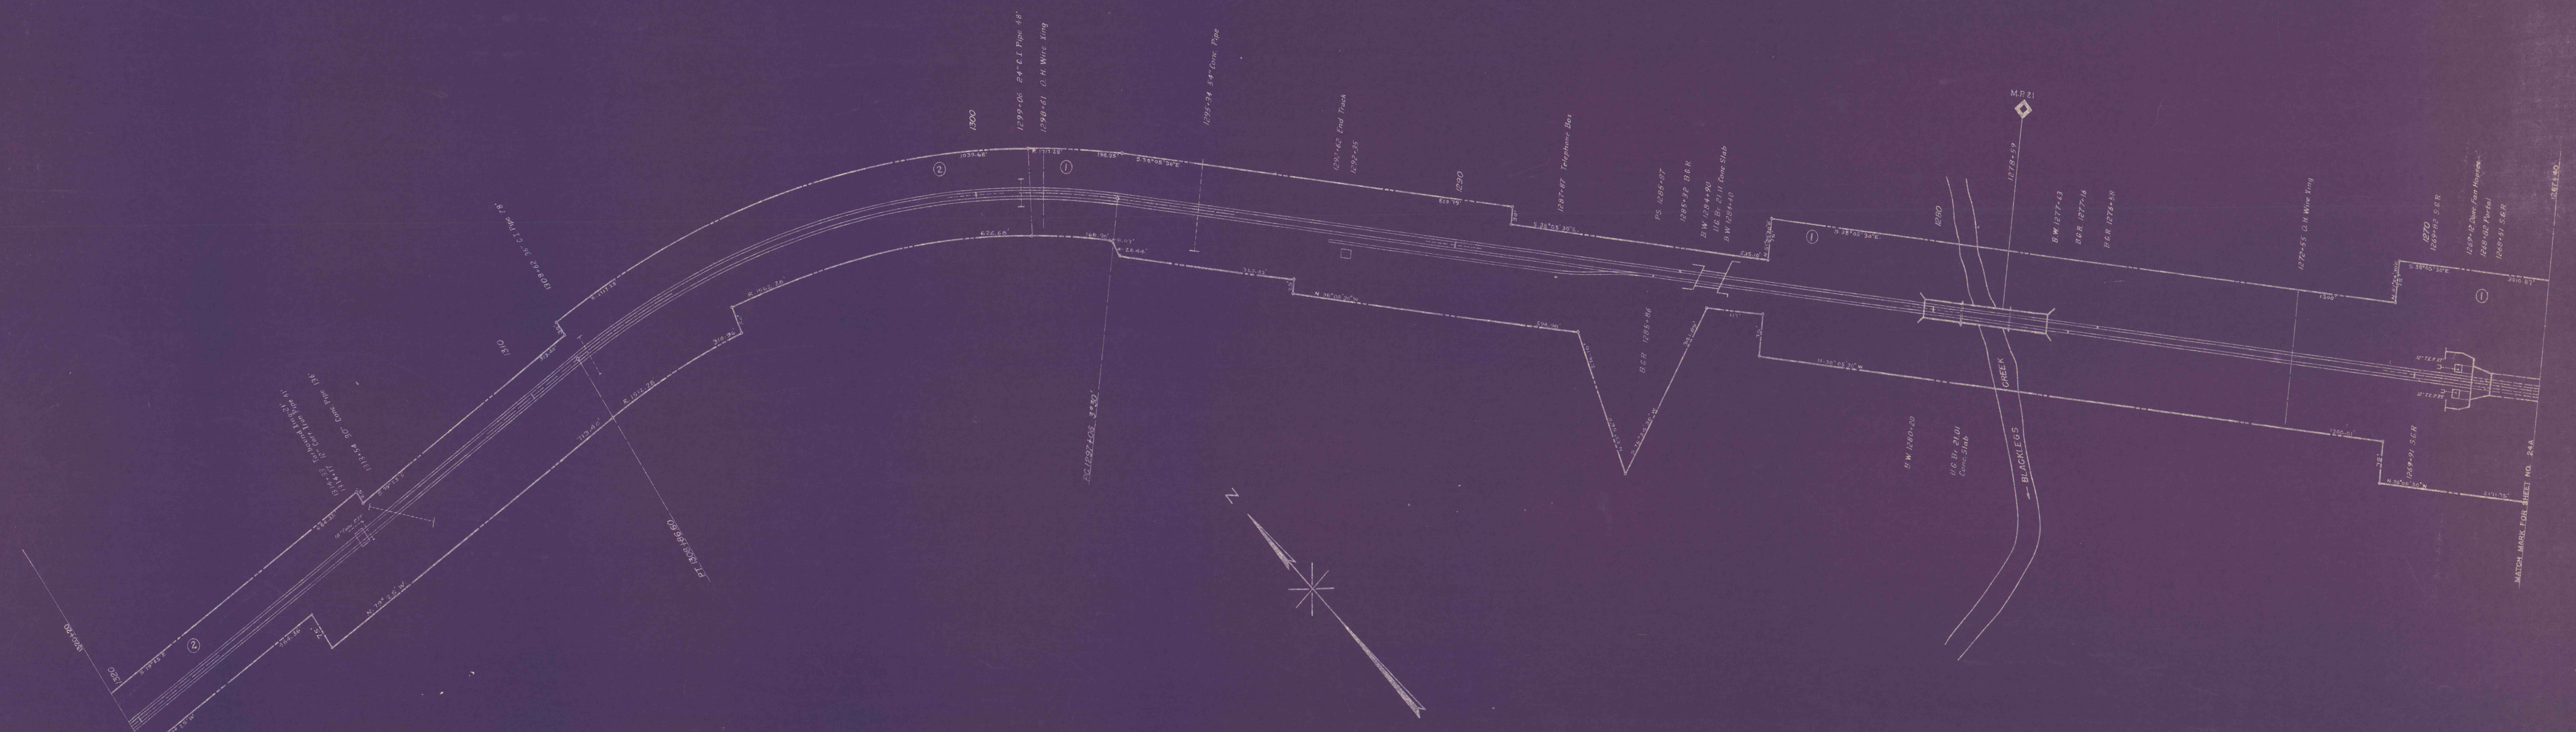

Correct as of Dec. 31st, 1953	No. Revision
Correct as of Dec. 31st, 1951	Map Revised
Correct as of Dec. 31st, 1950	No. Revision
Correct as of Dec. 31st, 1949	No. Revision
Correct as of Dec. 31st, 1948	No. Revision
Correct as of Dec. 31st, 1947	No. Revision
Correct as of Dec. 31st, 1946	No. Revision
Correct as of Dec. 31st, 1945	No. Revision
Correct as of Dec. 31st, 1944	No. Revision
Correct as of Dec. 31st, 1943	No. Revision

WESTERN PENNA. DIV. CONEMAUGH DIV.
RIGHT OF WAY AND TRACK MAP
PENNSYLVANIA RAILROAD
STATION 1267+40 TO STATION 1320+20
SCALE 1"=100' JUNE 30, 1918
OFFICE OF VALUATION ENGINEER
PHILADELPHIA, PA.

VS. 220
28 A