


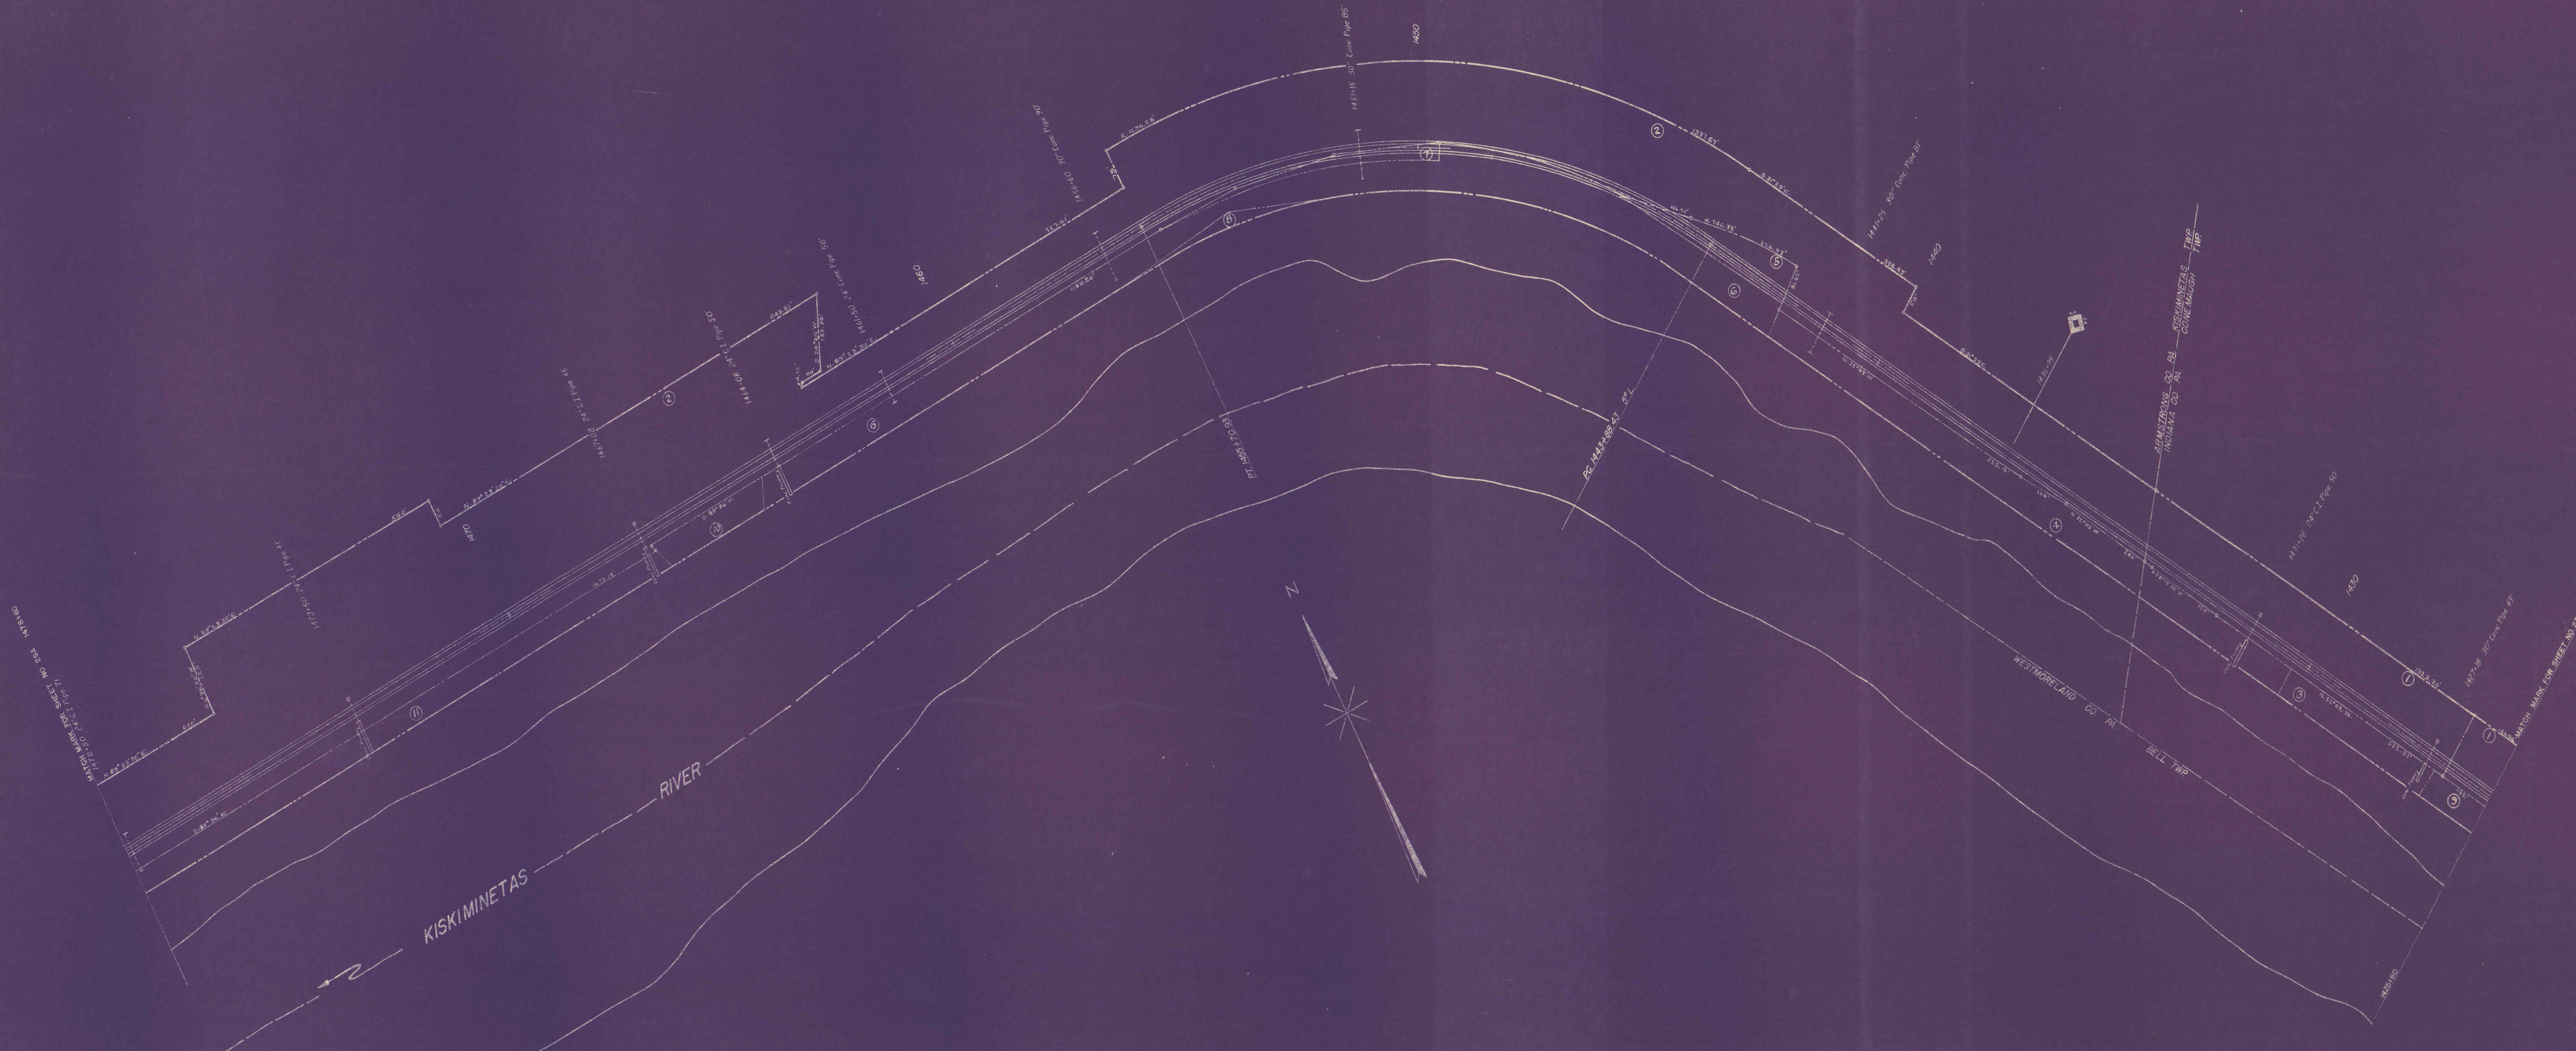

Correct as of Dec. 31st, 1955: No Revision	
Correct as of Dec. 31st, 1954: Map Revised	
Correct as of Dec. 31st, 1953: No Revision	
Correct as of Dec. 31st, 1952: No Revision	
Correct as of Dec. 31st, 1951: No Revision	
Correct as of Dec. 31st, 1950: No Revision	
Correct as of Dec. 31st, 1949: Map Revised	
Correct as of Dec. 31st, 1948: No Revision	
Correct as of Dec. 31st, 1947: No Revision	
Correct as of Dec. 31st, 1946: No Revision	
Correct as of Dec. 31st, 1945: No Revision	
Correct as of Dec. 31st, 1944: No Revision	
Correct as of Dec. 31st, 1943: No Revision	

WESTERN PENNA. DIV. CONEMAUGH DIV.
 RIGHT OF WAY AND TRACK MAP
PENNSYLVANIA RAILROAD
 STATION 1425+80 TO STATION 1478+60
 SCALE 1"=100' JUNE 30, 1958
 OFFICE OF VALUATION ENGINEER
 PHILADELPHIA, PA.

VS. 22.0
 28A