


2000 E

3000 E

4000 E

MINING 44-131 69248

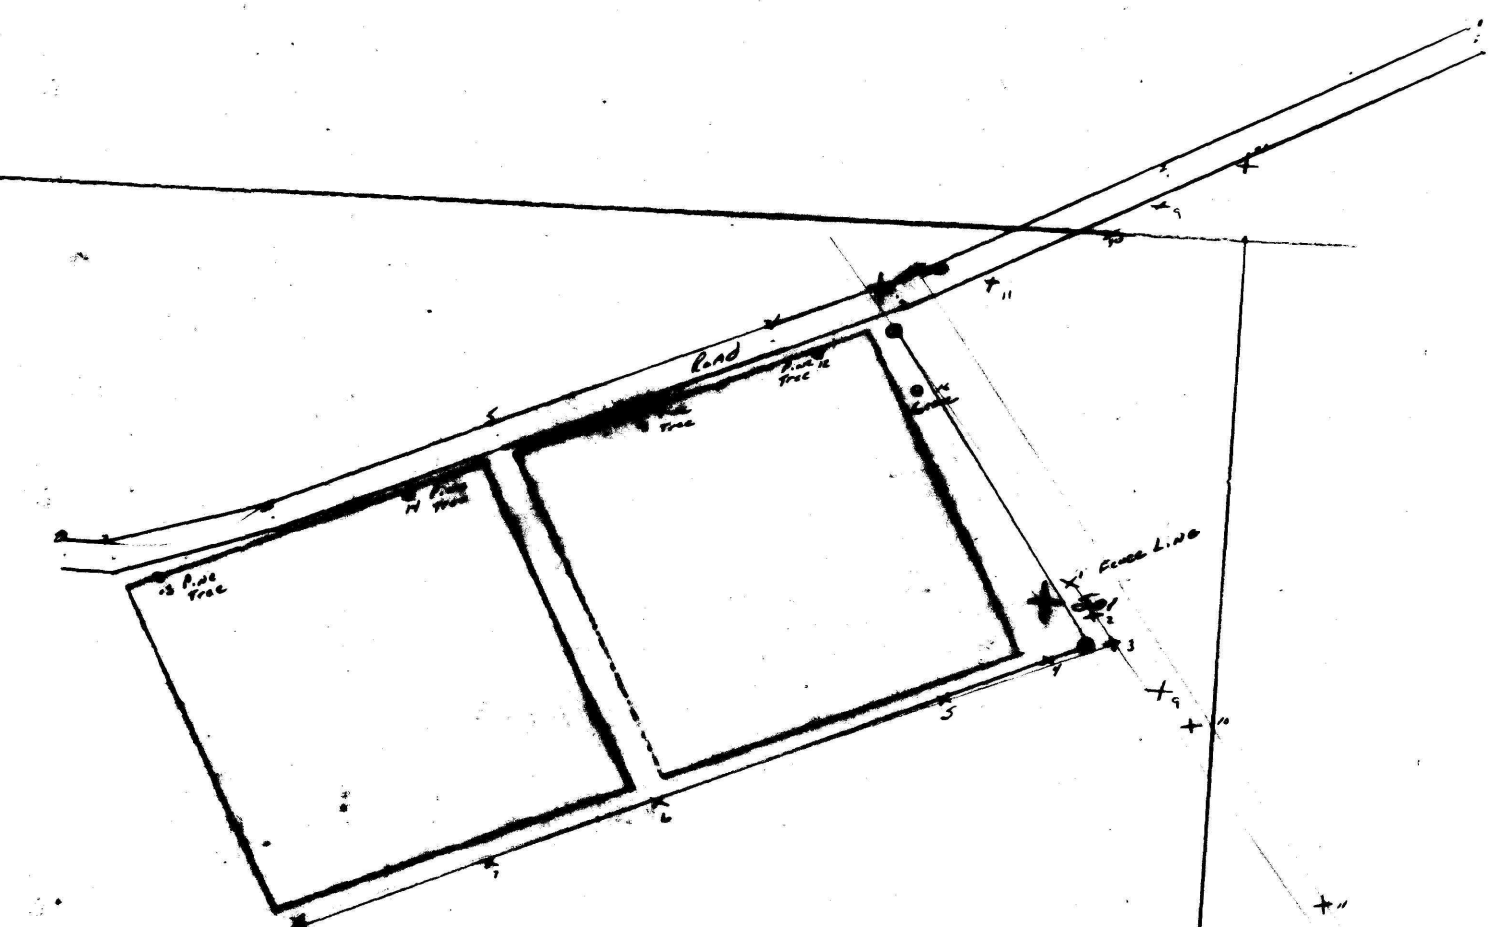

ROCKEFELLER & PITTSBURGH COAL COMPANY	
ENGINEERING DEPT., INDIANA, PA.	
Iselin Cemetery	
MADE BY	SCALE 1"=100'
TRACED BY	DATE
CHECKED BY	MR.

IMAP # 14900