


LUCERNE #9 MINE LEGEND

-  1" = 100' TRACINGS
-  HARD COPIES
-  1" = 200' TRACINGS
-  1" = 400' TRACINGS

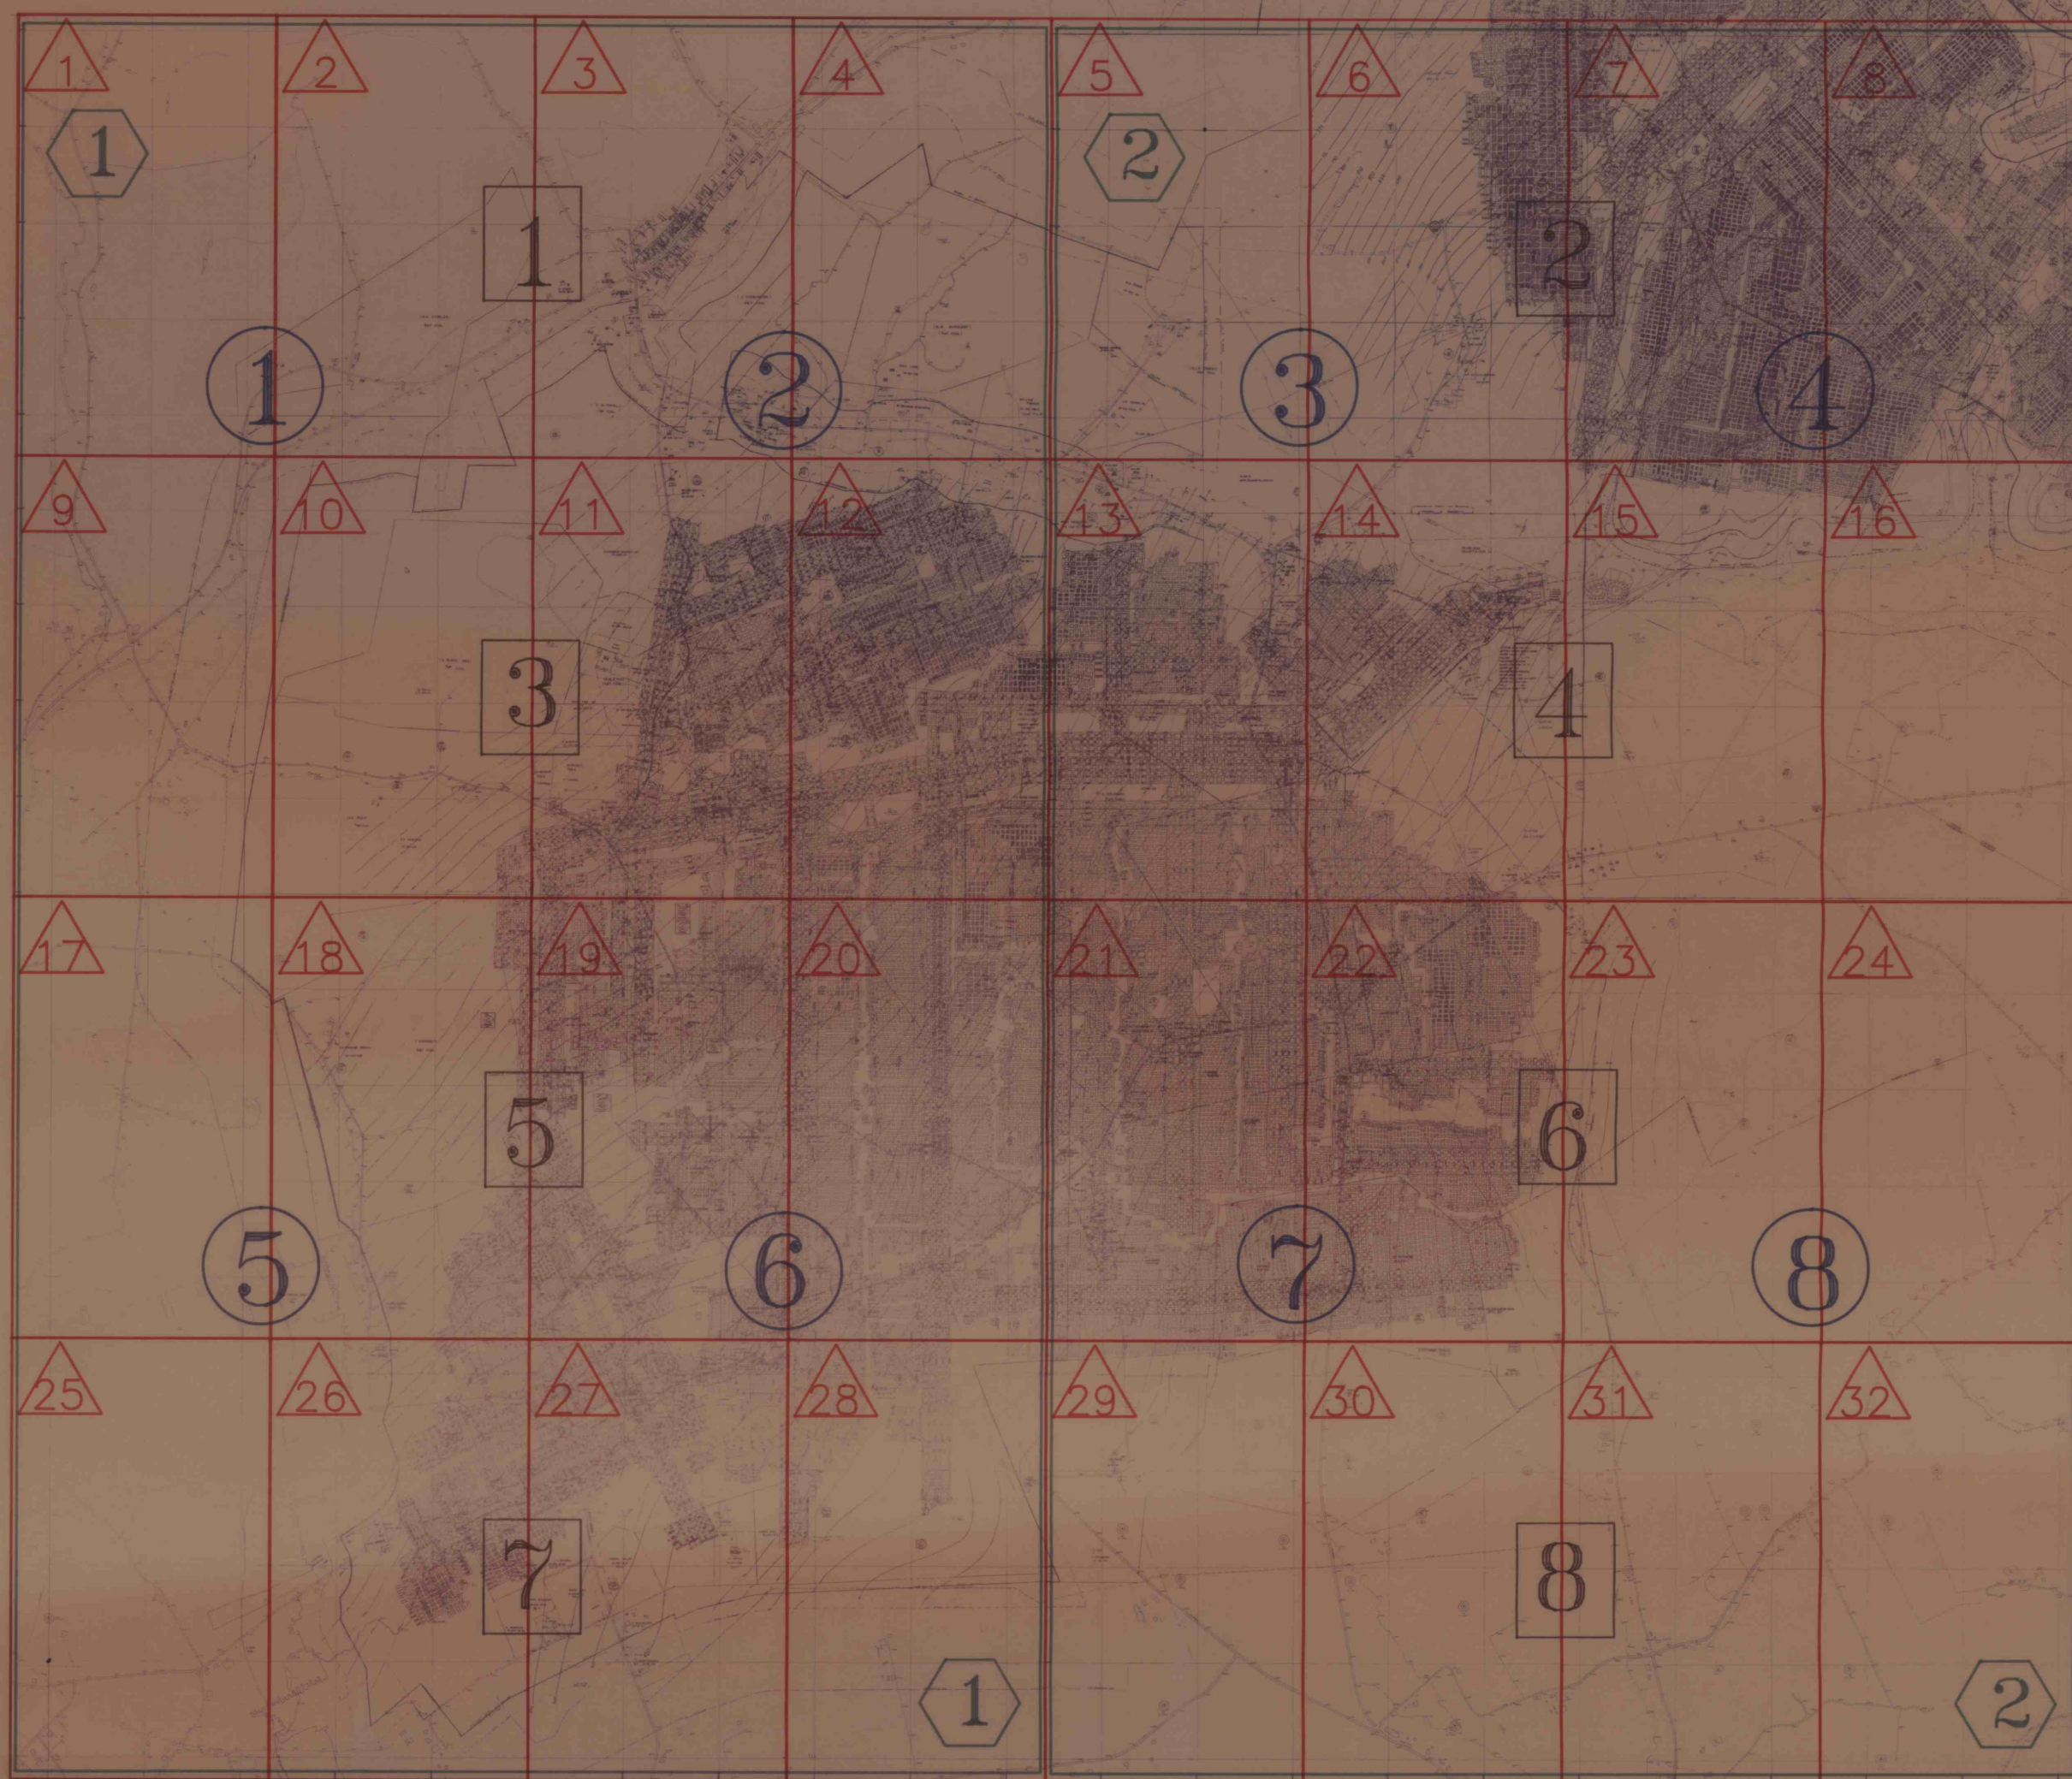

LUCERNE NO. 9 MINE - HELVETIA COAL CO.
YOUNG TWP. - INDIANA CO., PA.

SCALE 1" = 1000'

FINAL MINE MAP 12-20-94

LUCERNE #9 MINE DATE 1-1-95