


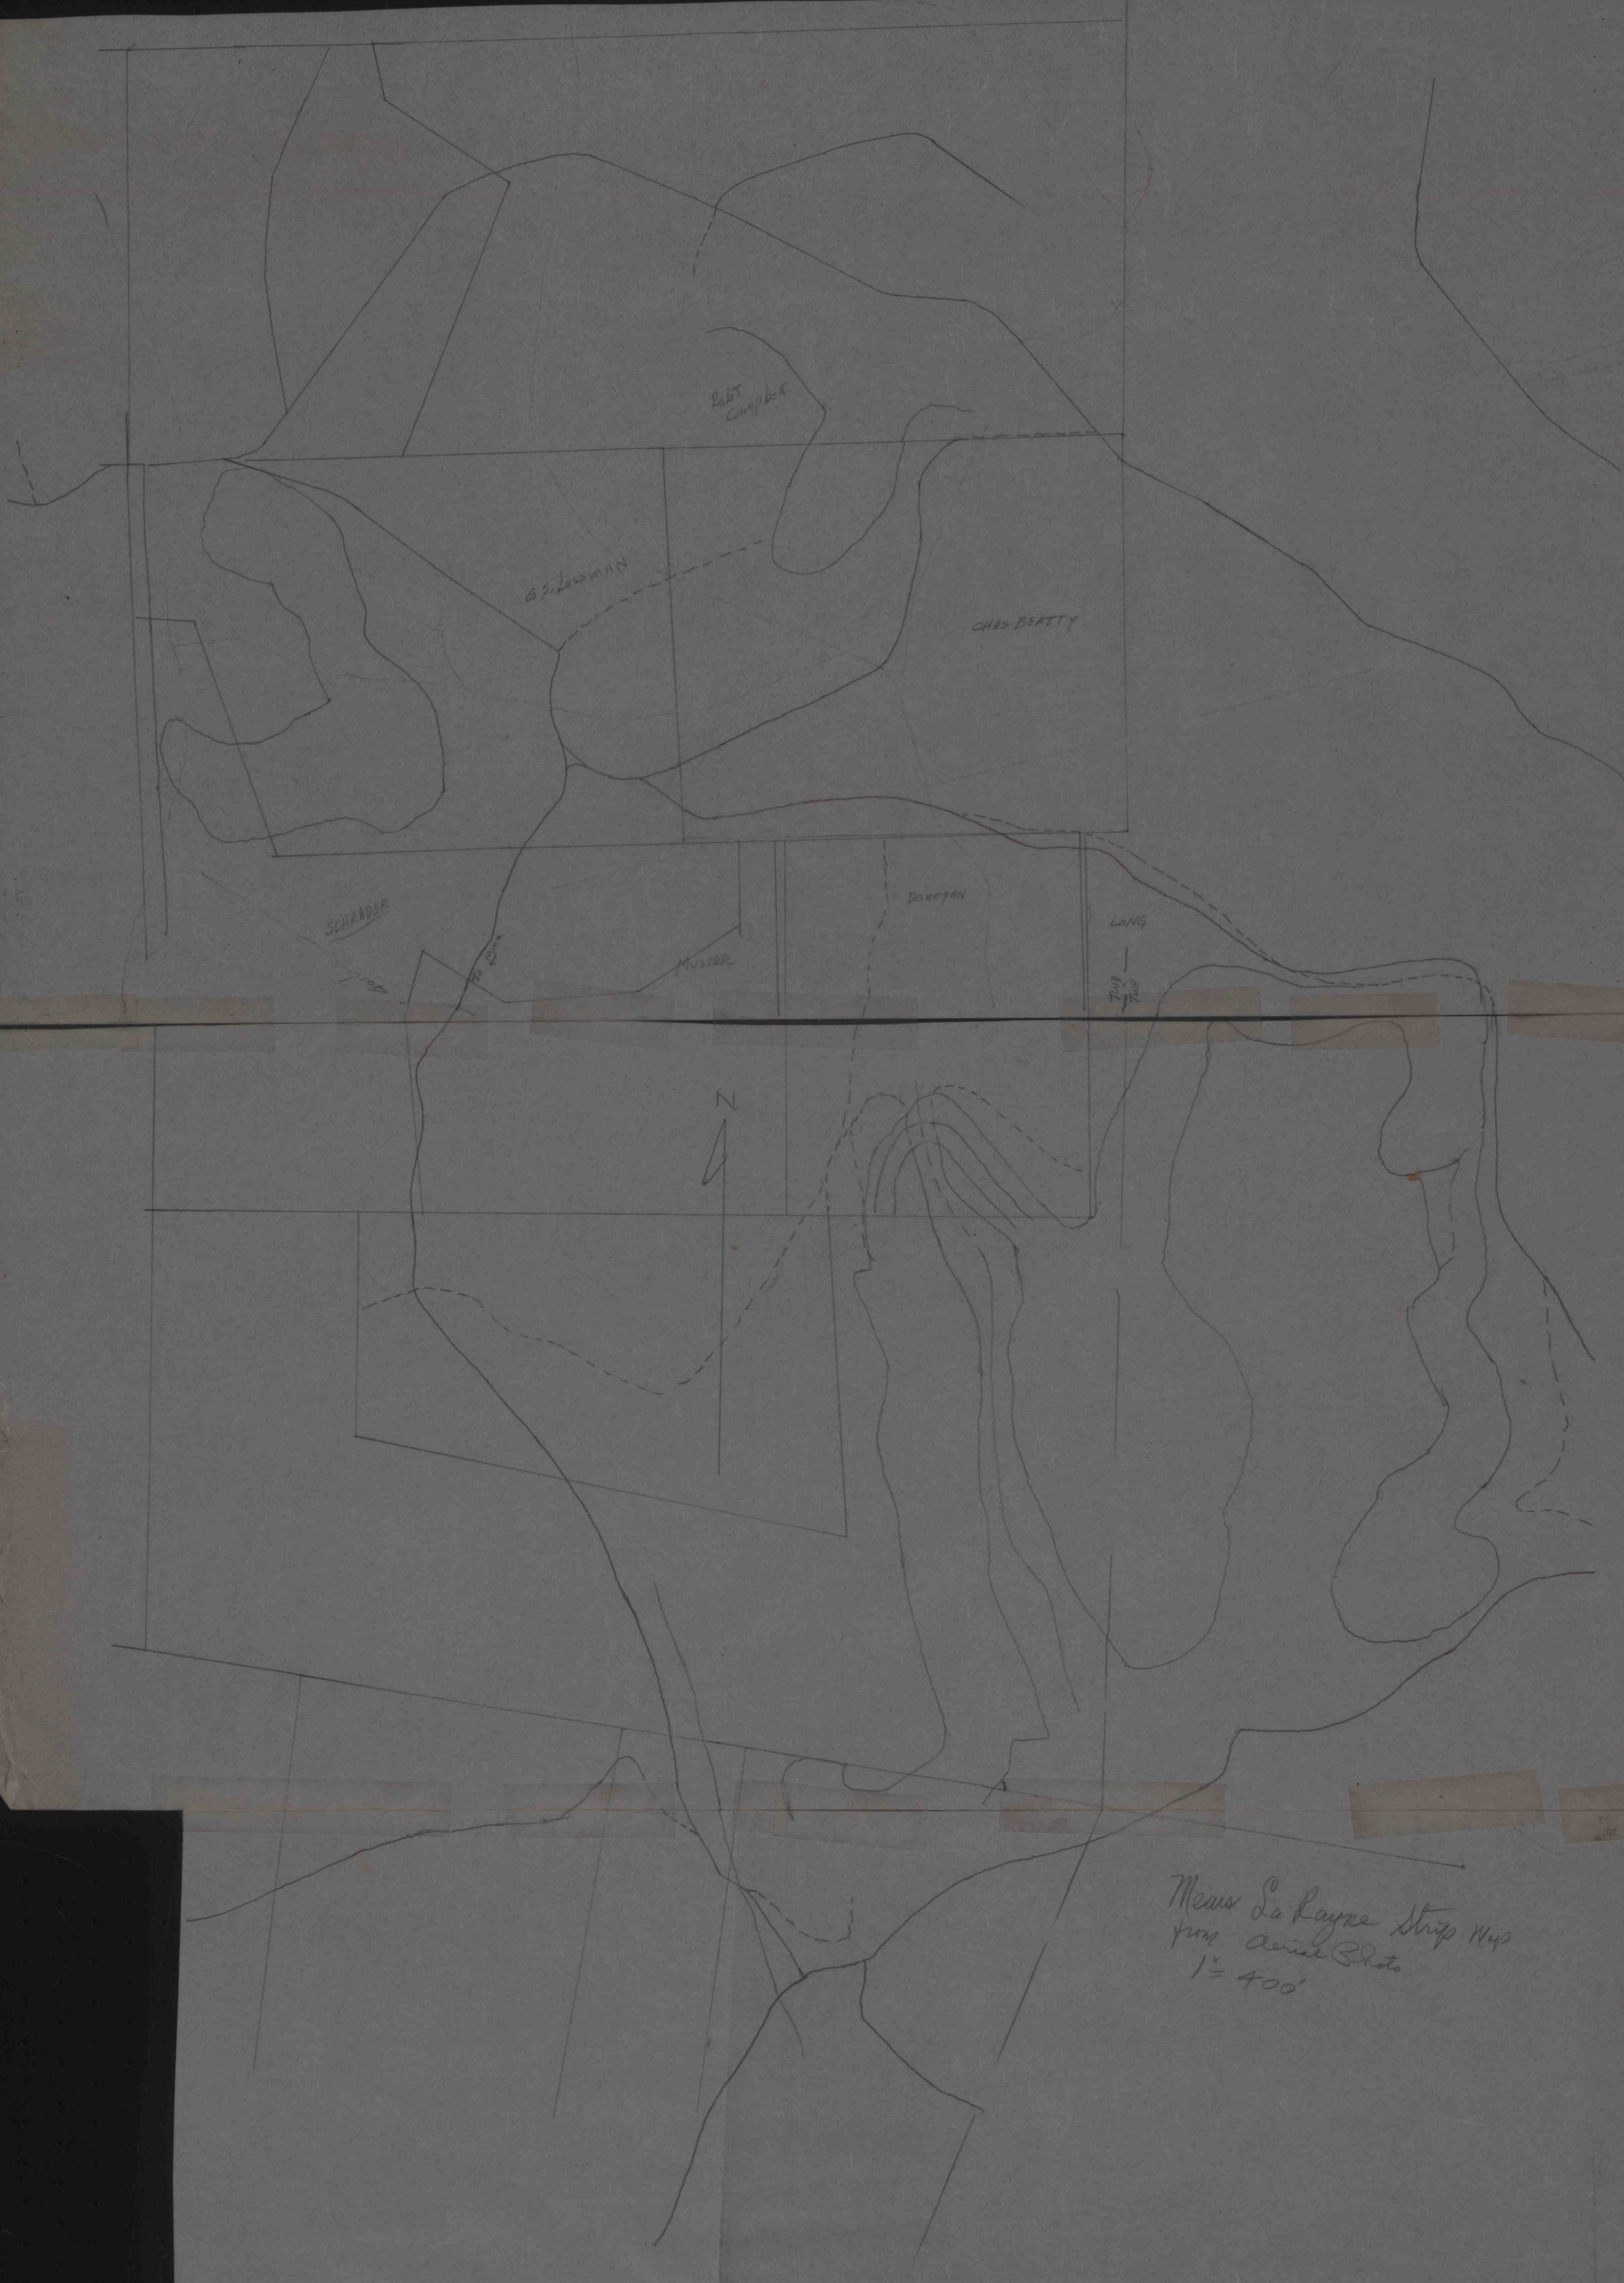

Means Le Rayne Strip Map
from Aerial Photo
1" = 400'

Means
Le Rayne
Strip Map
1" = 400'

IMAPS # 14450