


MAPS # 14480

KARTHUS - DRIFTING - GORTON

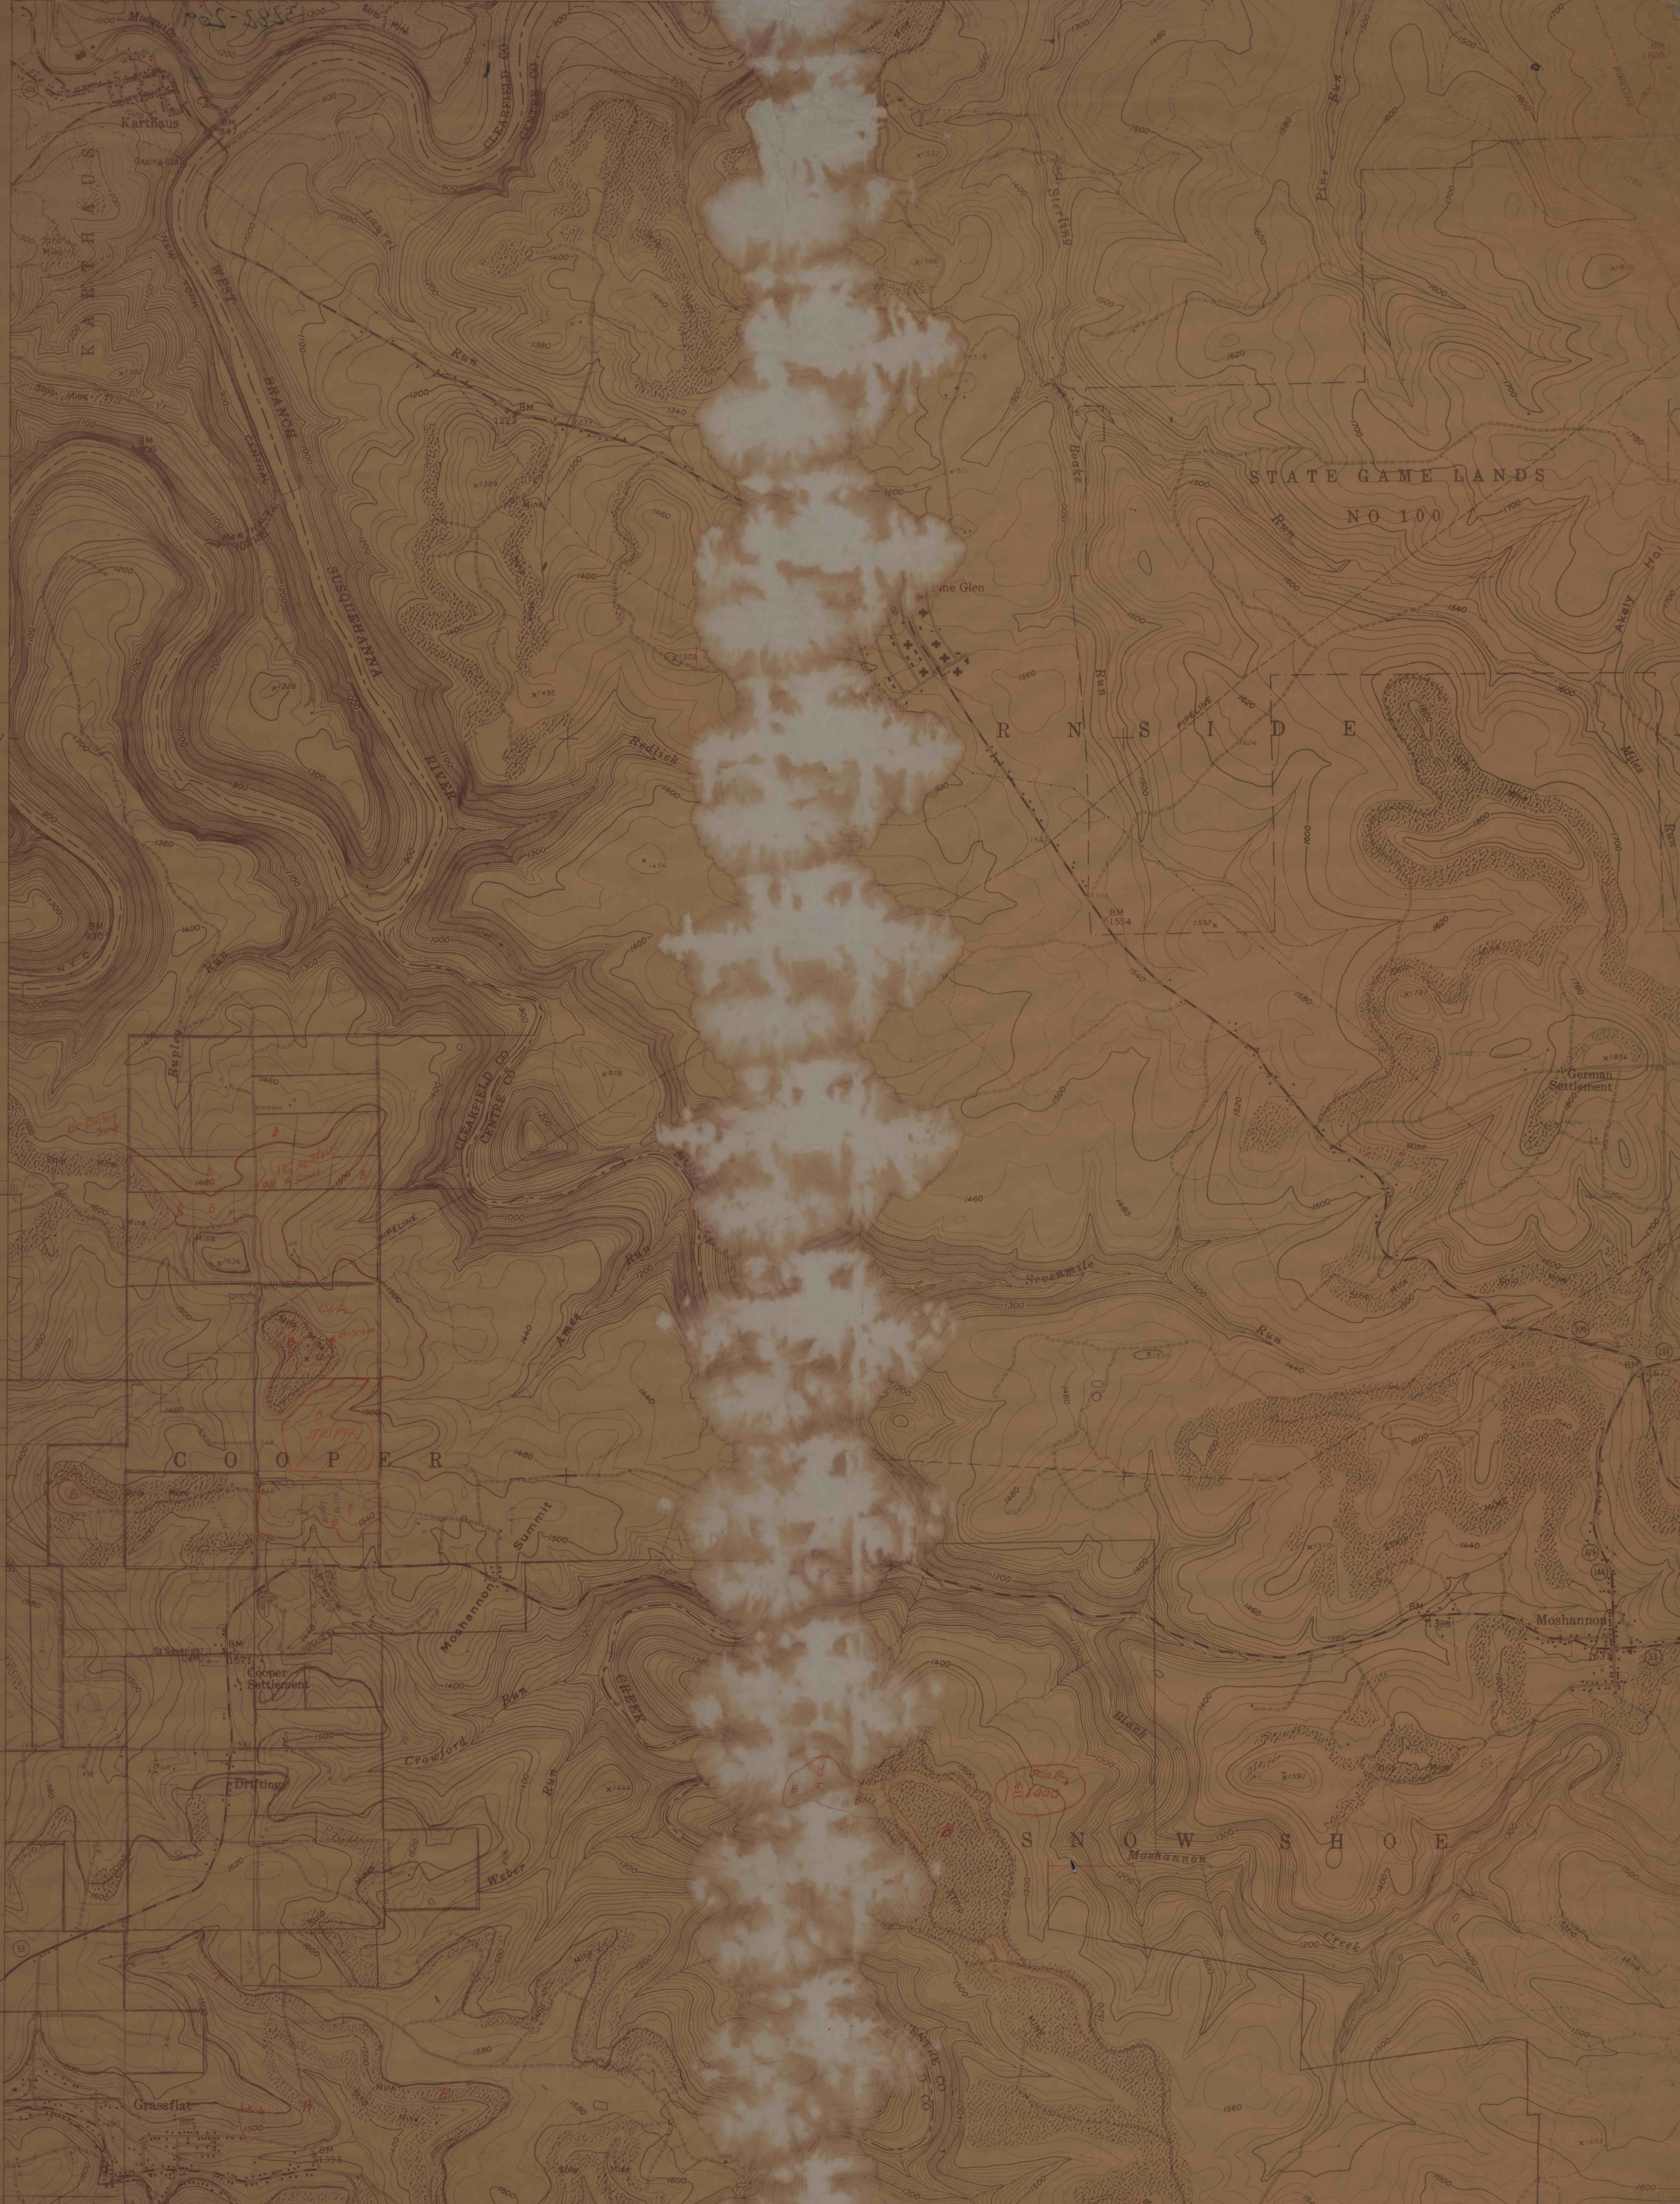

GRASSFLAT
GORTON
1" = 1000'