


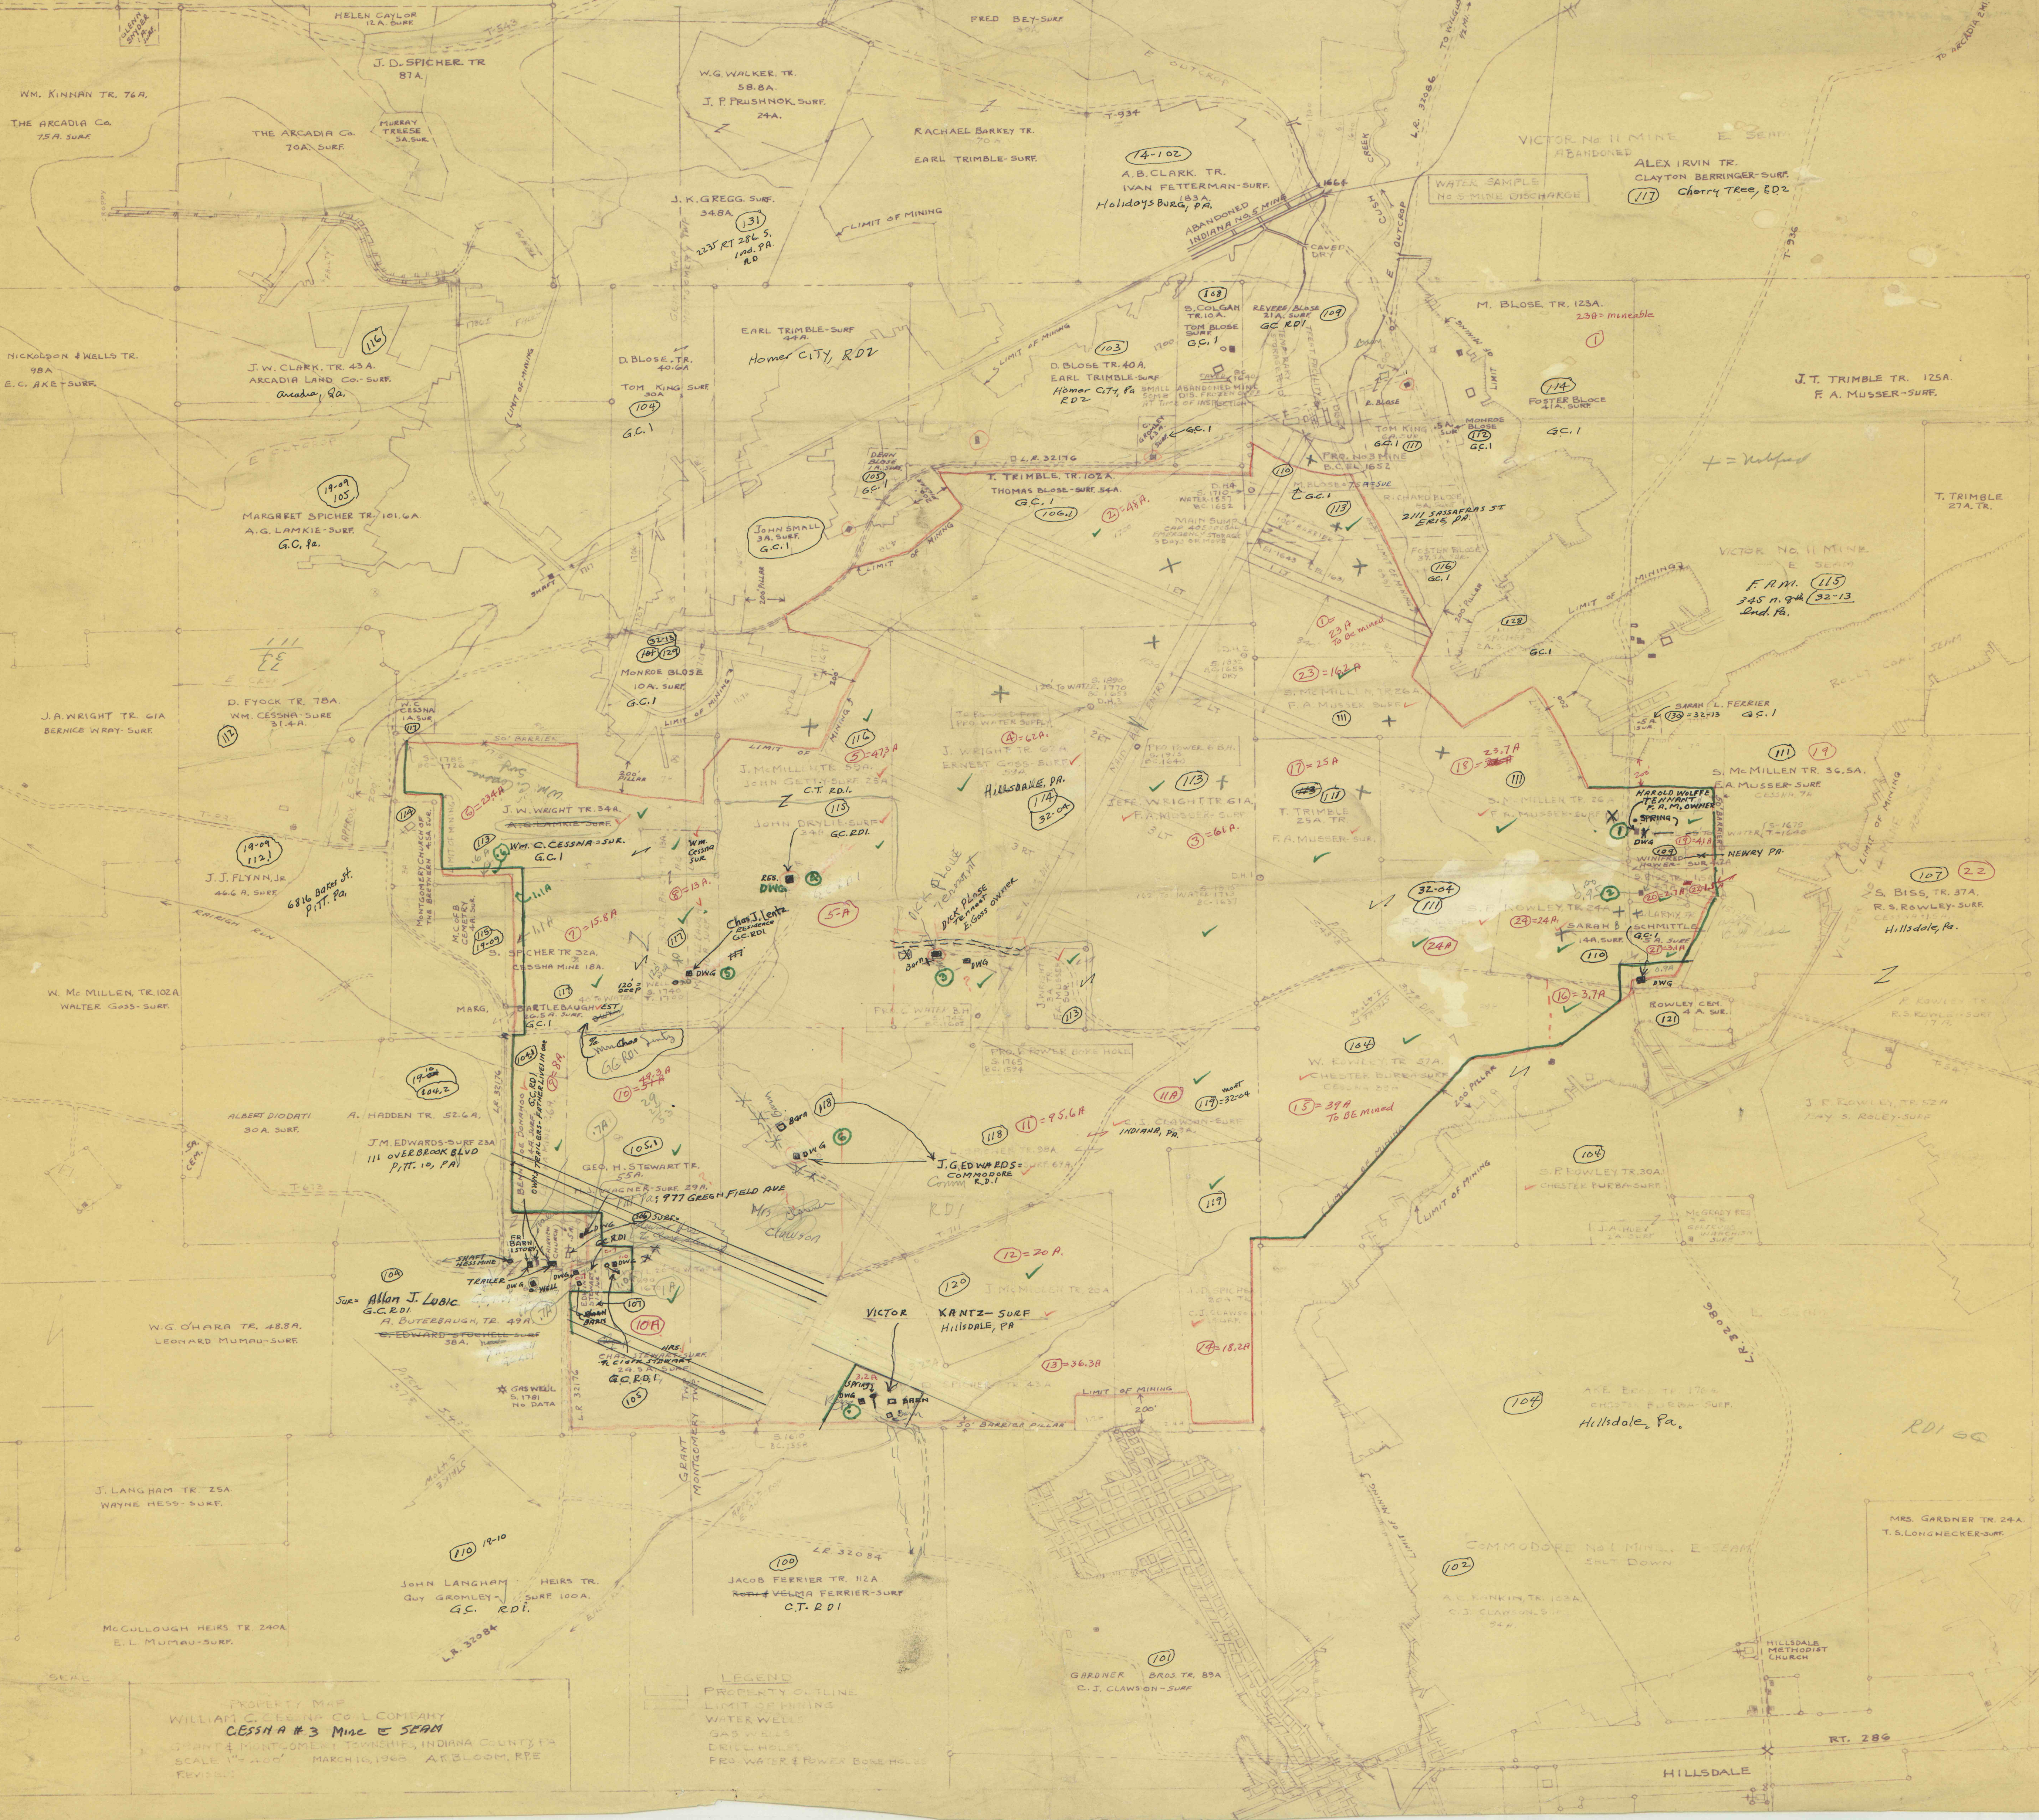

PROPERTY MAP
WILLIAM C. CESSNA COAL COMPANY
CESSNA #3 MINE & SEAM
GRANT & MONTGOMERY TOWNSHIPS, INDIANA COUNTY, PA
SCALE 1" = 400' MARCH 10, 1966 A.B. BLOOM, P.E.
REVISED

LEGEND
PROPERTY OUTLINE
LIMIT OF MINING
WATER WELLS
GAS WELLS
DRILL HOLES
PRO. WATER & POWER BORE HOLES